









LATEST COPY





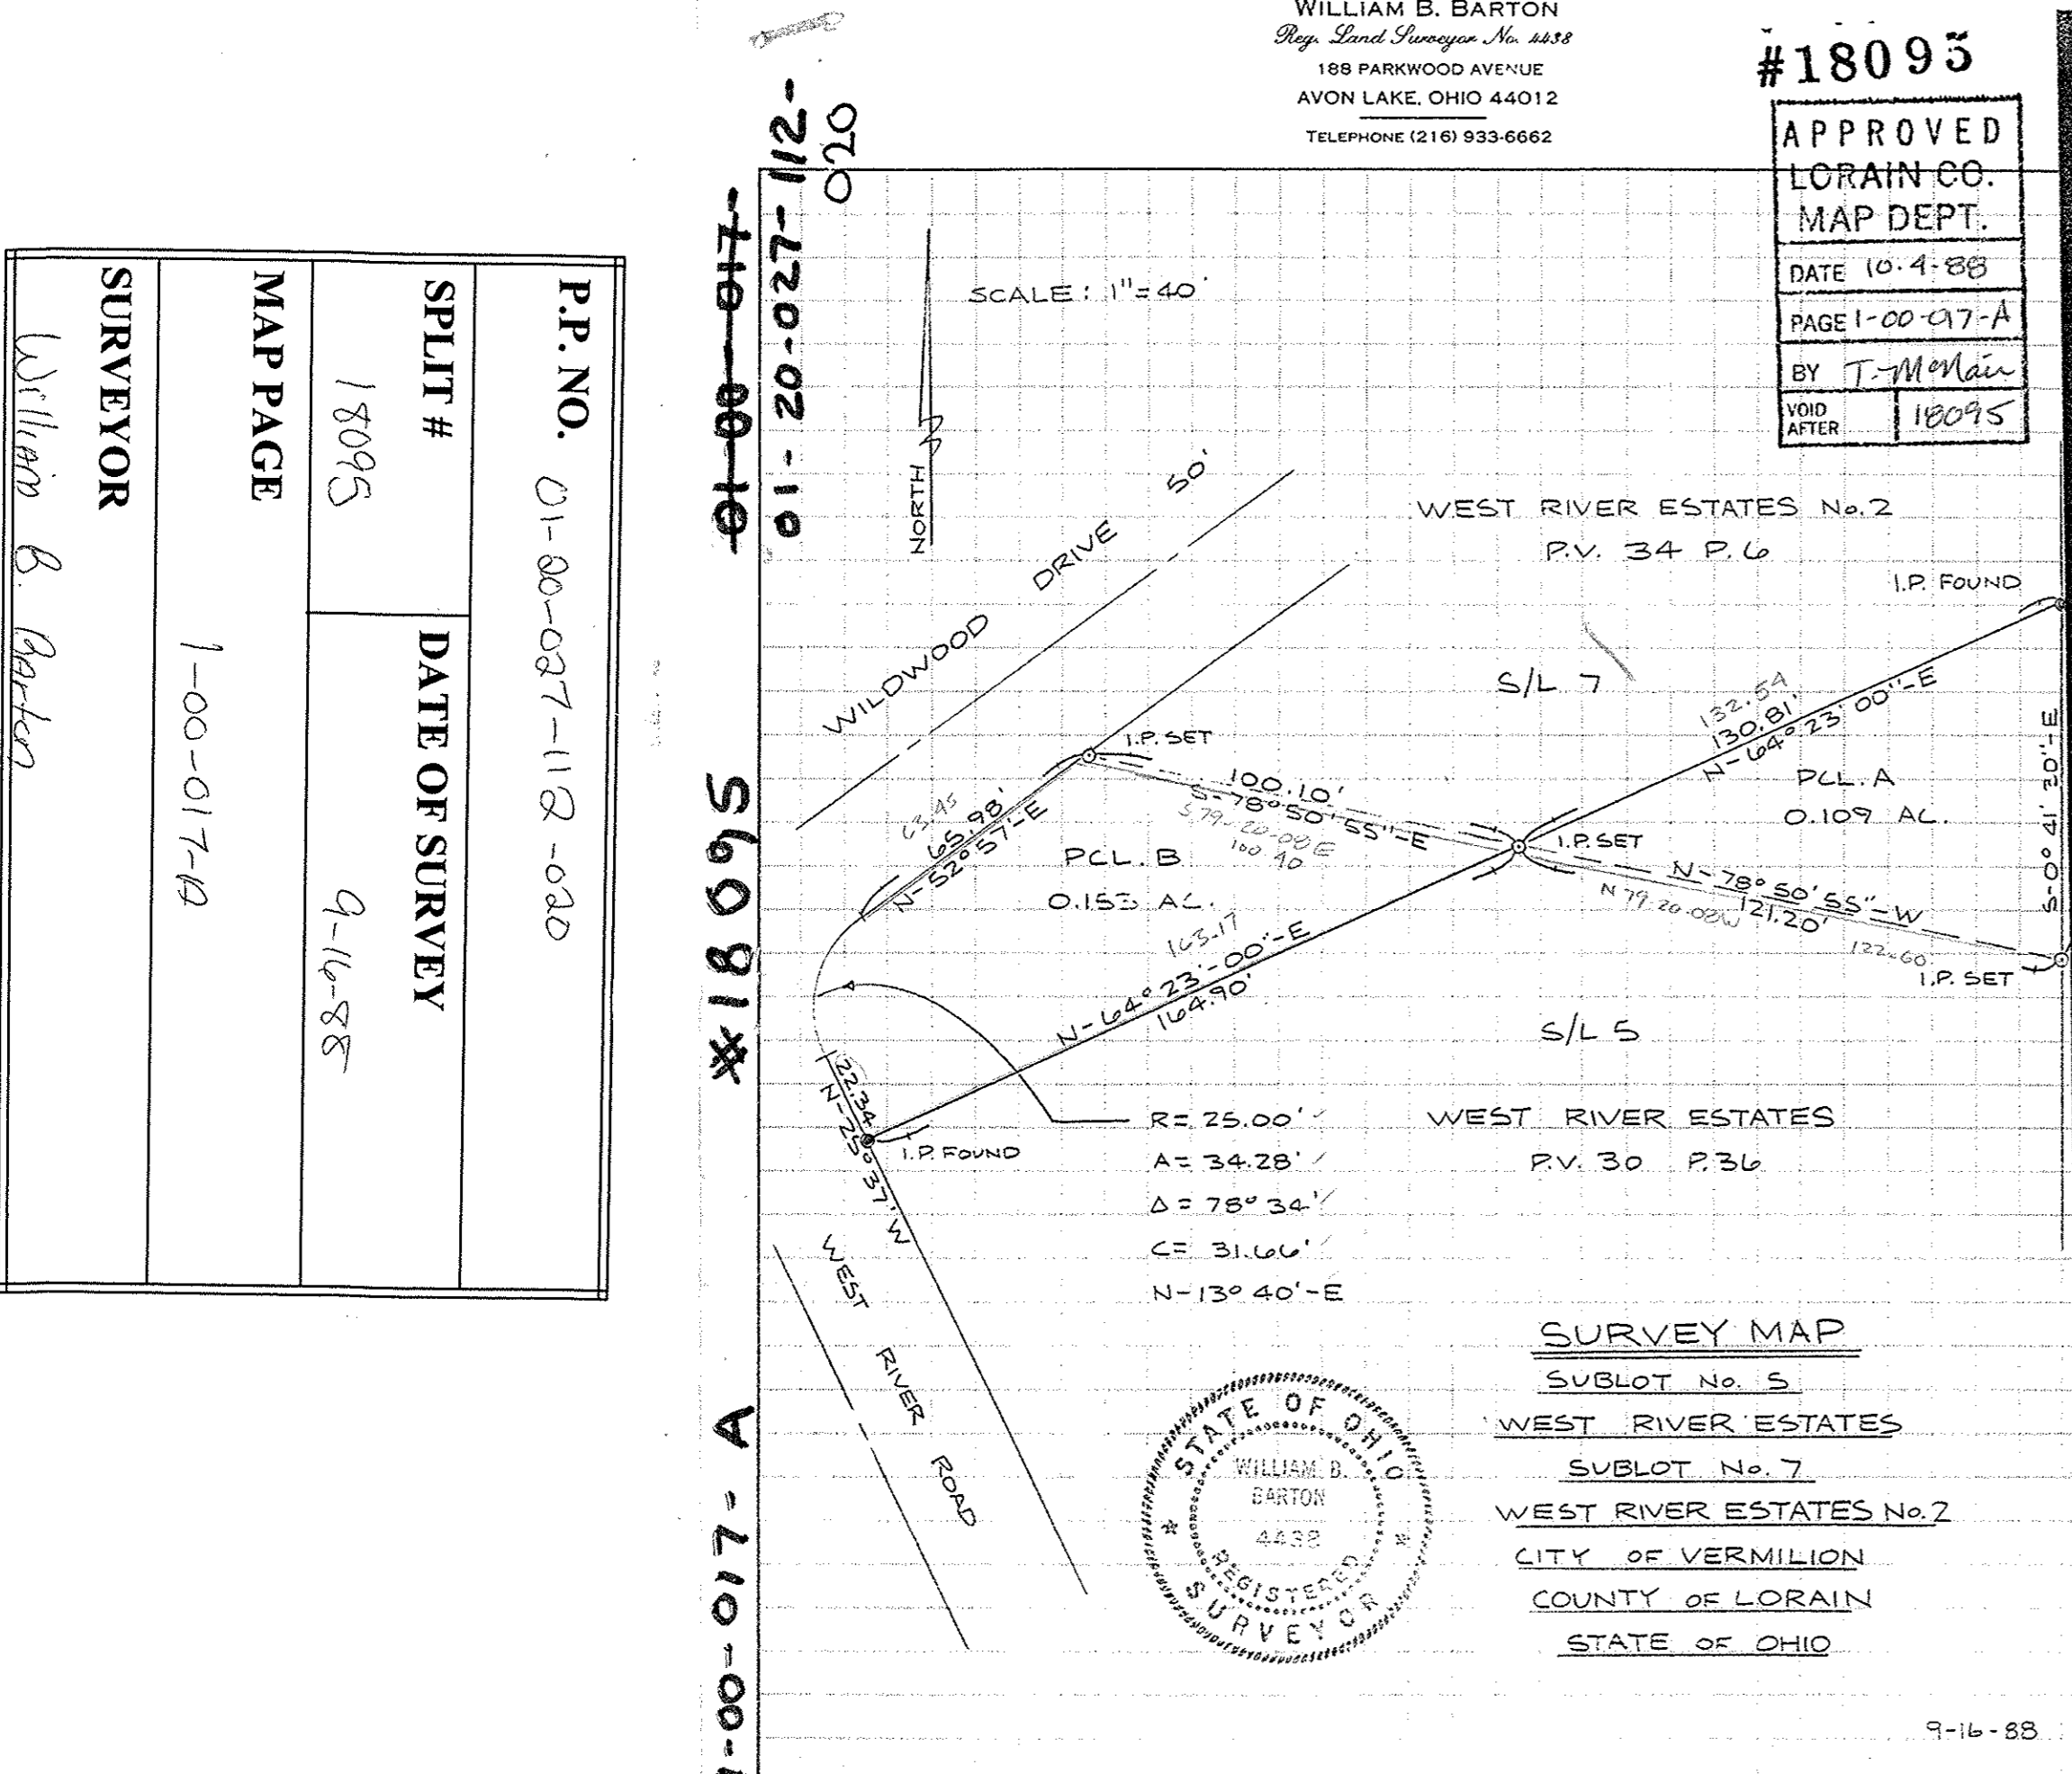

WILLIAM B. BARTON, Reg. Land Surveyor No. 4418, 188 PARKWOOD AVENUE, AVON LAKE, OHIO 44012, TELEPHONE (216) 933-6662. SURVEY MAP SUBLOT No. 5 WEST RIVER ESTATES SUBLOT No. 7 WEST RIVER ESTATES No. 2 CITY OF VERMILION COUNTY OF LORAIN STATE OF OHIO

242939 Vol 1414 Page 256

Know all men by these presents, that the Broadview Savings and Loan Company, a Corporation incorporated under the laws of the State of Ohio, who claim title by or through instrument, recorded in Volume Page County Recorder's Office, for the consideration of ten dollars and other valuable consideration Dollars (\$10.00 etc.) Full satisfaction of Frederick Allen May

INDEXED 242939 WARRANTY DEED FROM The Broadview Savings and Loan Company, an Ohio Corporation TO Fredrick Allen May FILM ROLL NO. 2810 RECEIVED FOR RECORD at o'clock M. in County Records Volume Page ENTERED FOR TRANSFER

THE STATE OF OHIO, Office of the Auditor Public in and for said County, person who approved the above named, Broadview Savings and Loan Company, an Ohio Corporation, in the presence of Thomas R. Hedrick, Notary Public