WILLIAM R. WATKINS
Chief Deputy Operations

JOHN R. HAMILTON
Deputy Engineer

CHARLES P. WARYU
Chief Deputy Planning

LAWRENCE V. McGLINCHY
LORAIN COUNTY ENGINEER
247 HADAWAY STREET
ELYRIA, OHIO 44035
Elyria 216-329-5586
Lorain 216-244-6261

September 25, 1986

Ray Henry, City Engineer
Lorain City Hall
West Erie Avenue
Lorain, Ohio 44052

Att: Pat McGannon

RE: Joseph Stanziano Lot Split
Broadway Heights Allotment
Lorain, Ohio

Dear Sir:

In accordance with our recent telephone conversation, we are forwarding copy of survey information the records of Ray E. Hollis, Registered Engineer and Surveyor (now deceased). The copy was made of Survey Field Book 147, Page 23, which is located at our office.

Hopefully, there is enough information shown that will enable you to advise Mr. Joseph Stanziano, 3708 Lexington Avenue, that the information is sufficient to permit him to proceed with the clearing of the records with the Lorain County Auditor's Transfer Office.

If you have any further questions, please contact this office.

Sincerely,

Lawrence V. McGlinchy

Lawrence V. McGlinchy,
LORAIN COUNTY ENGINEER

LVM/CPW/cjt

Attach: Survey Field Book 147, Page 23 (Hollis)
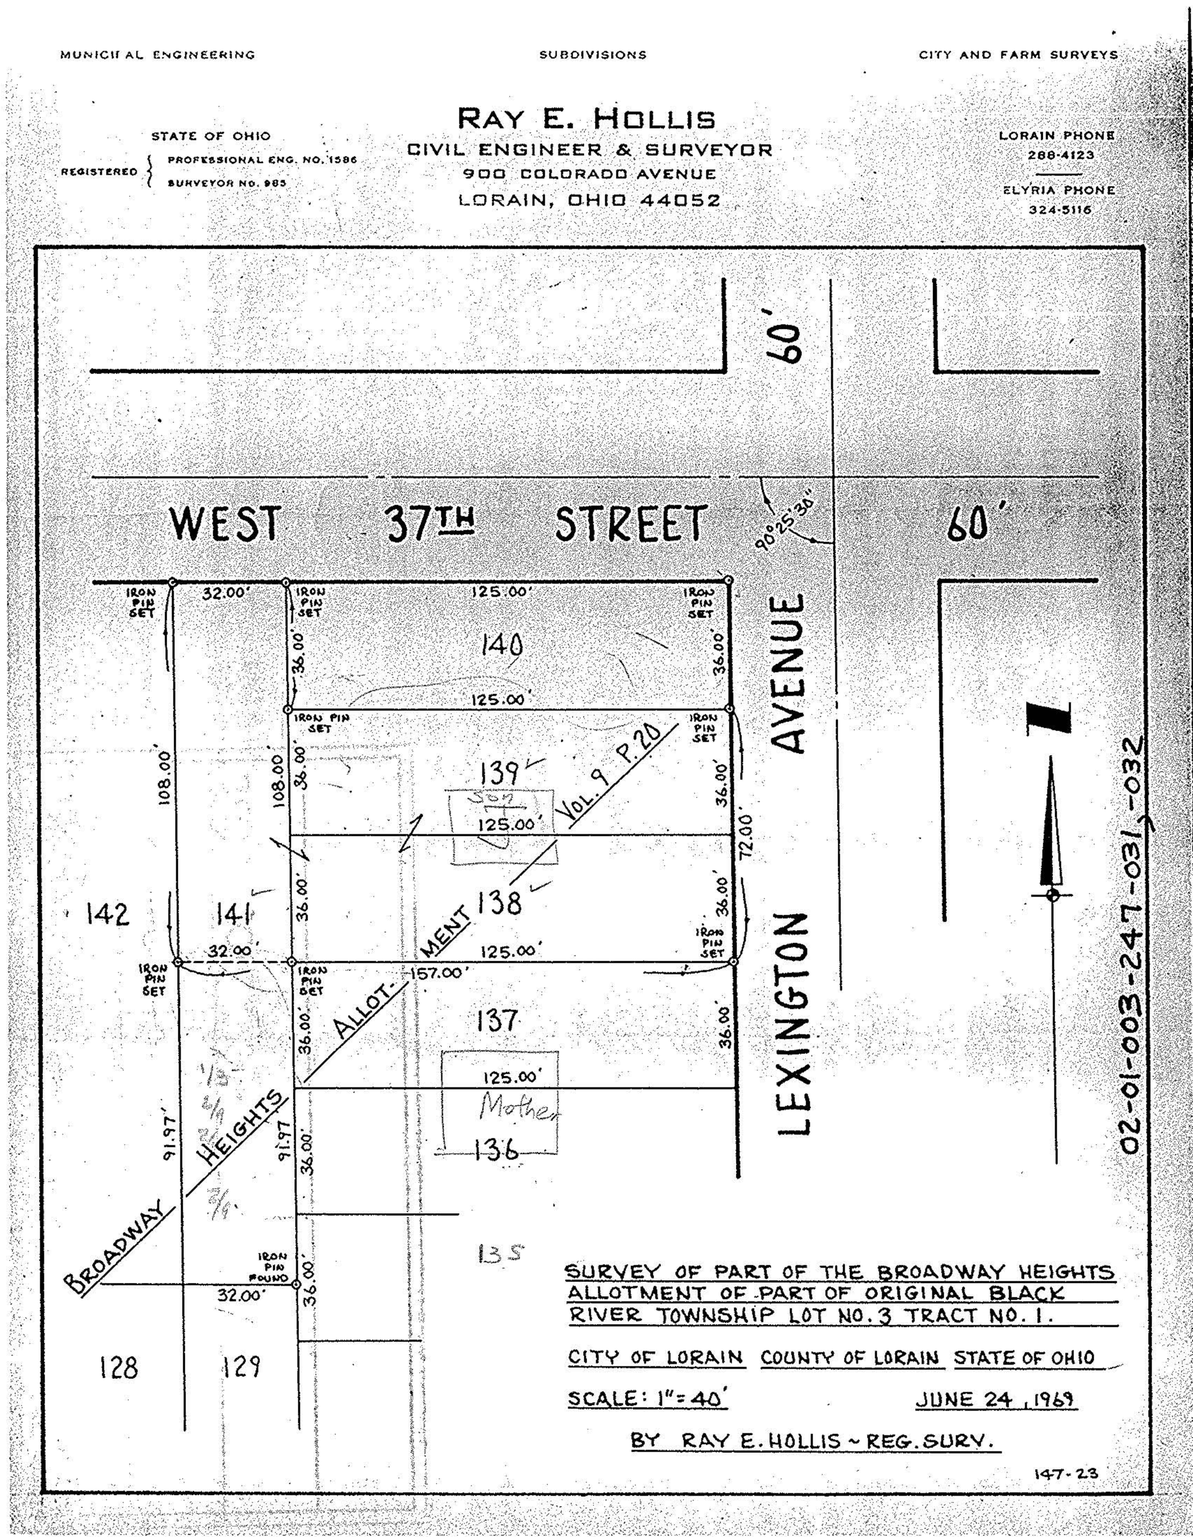
cc: Tax Map Depart