21183
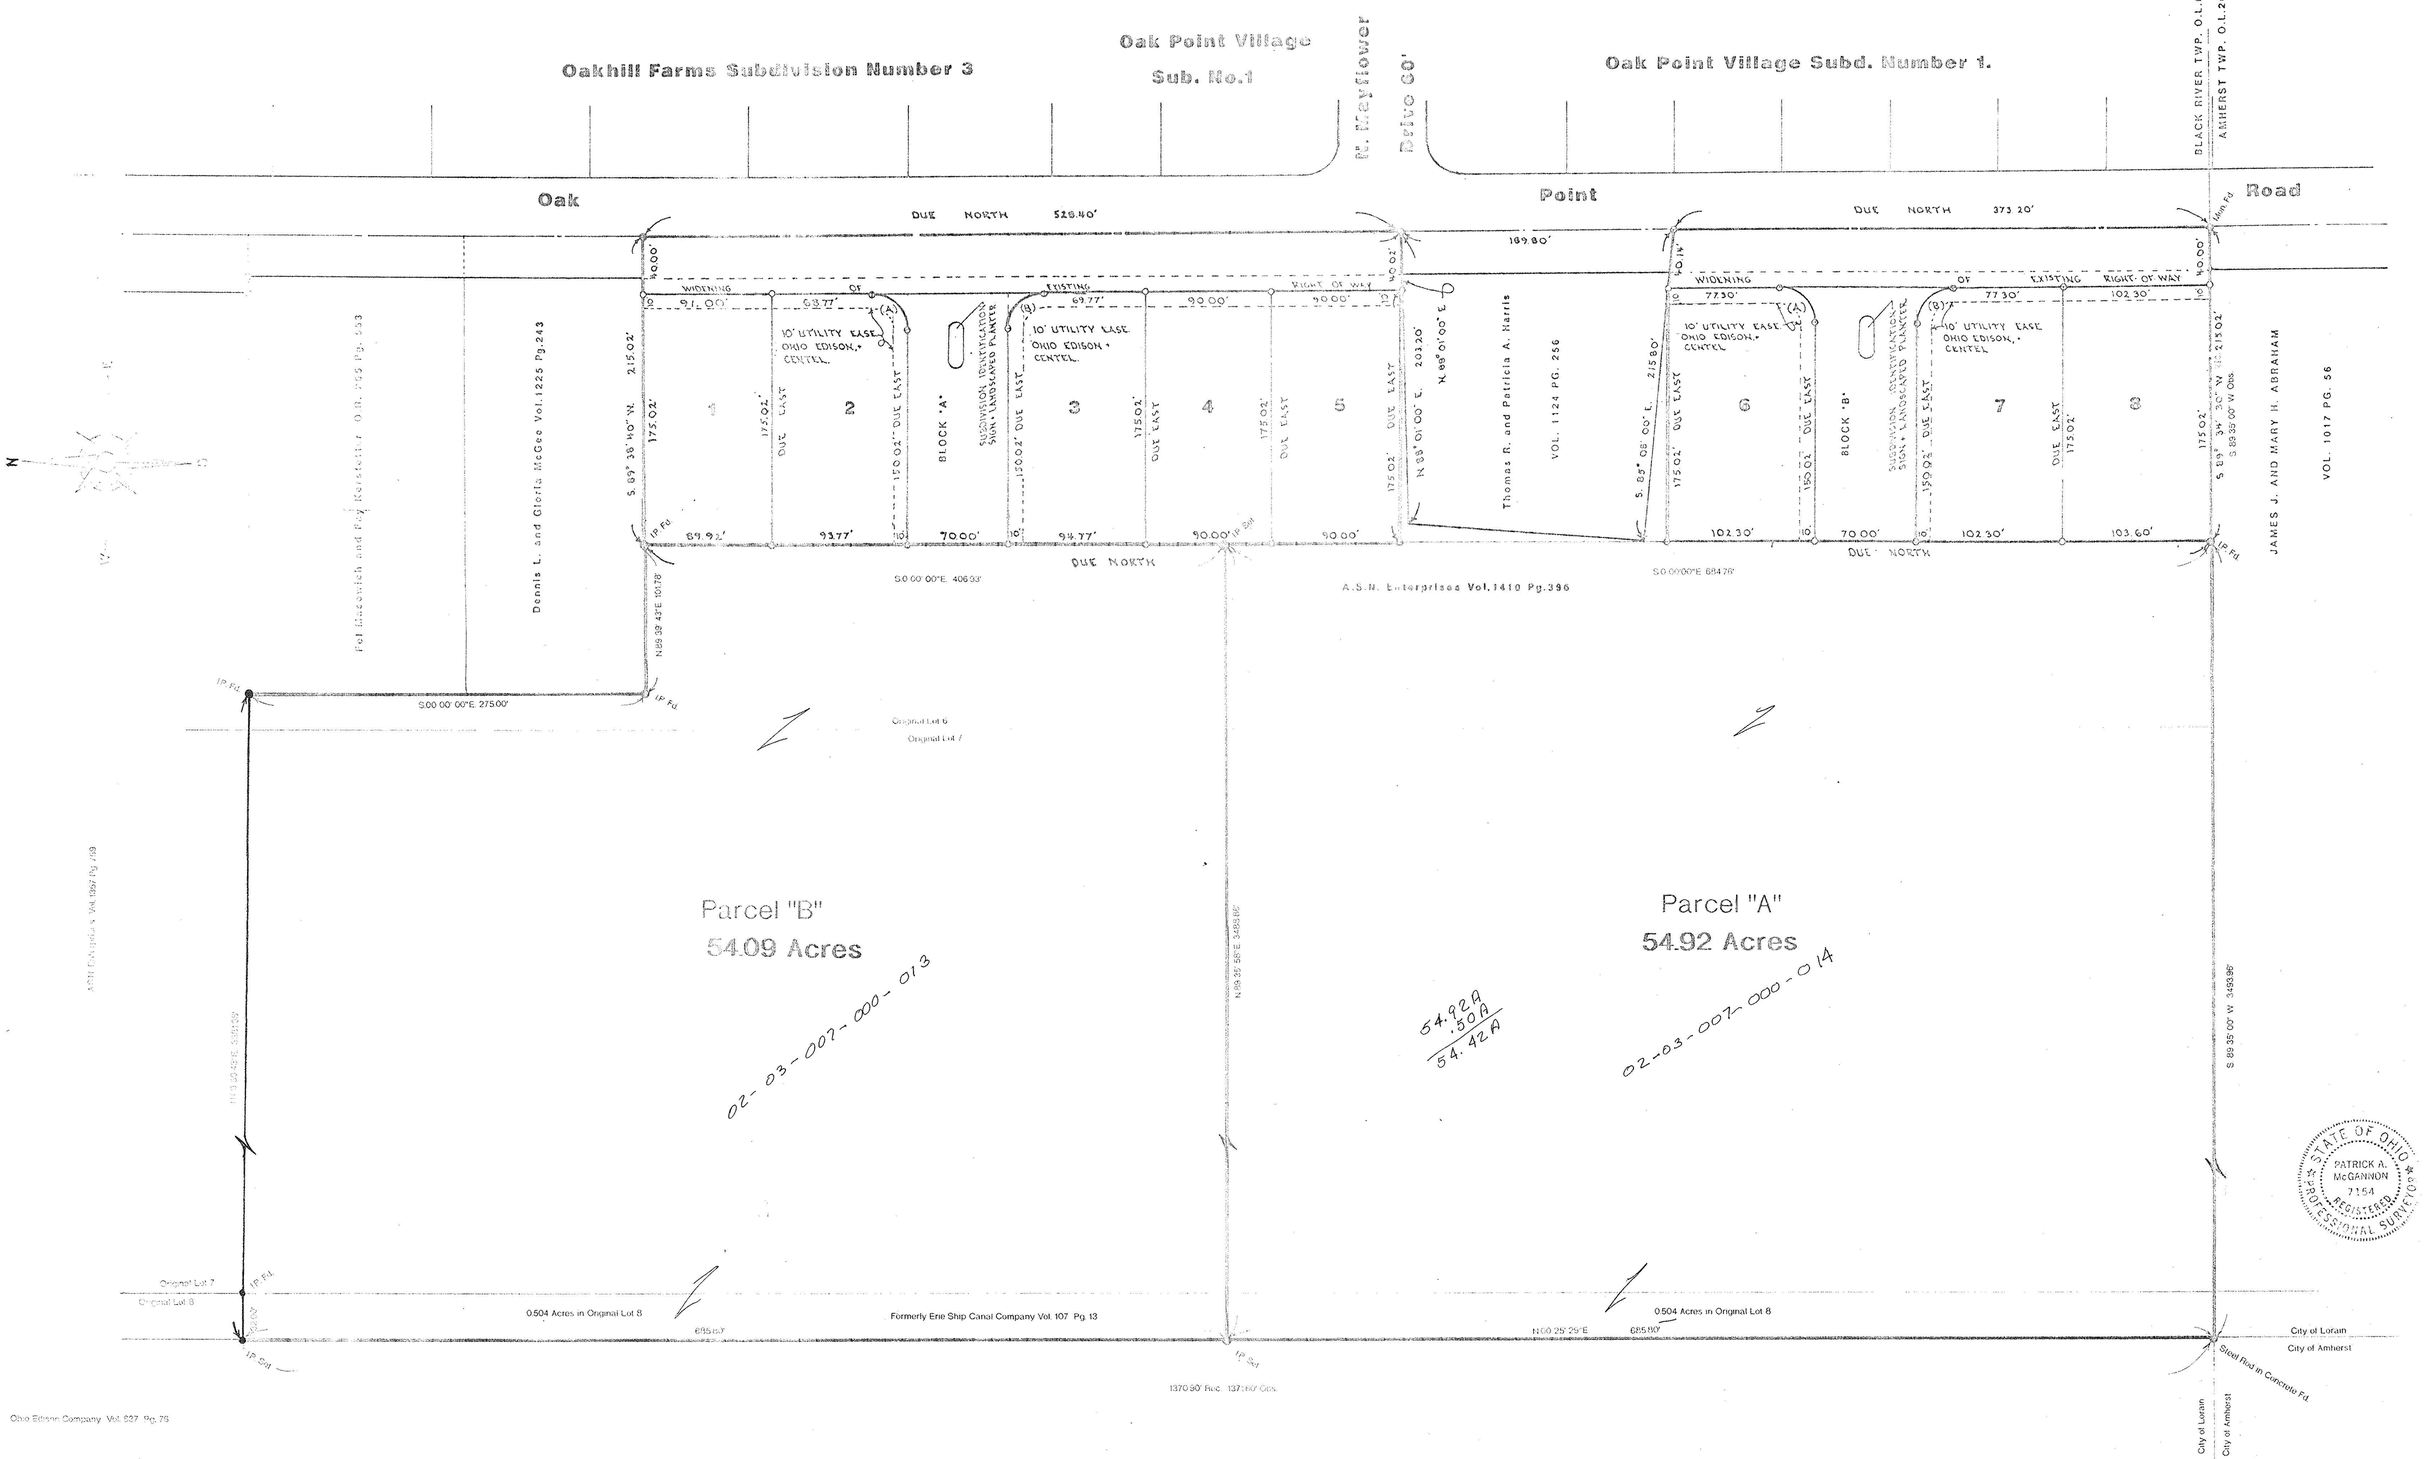
APPROVED
LORAIN CO.
MAP DEPT.
DATE 1-6-95
PAGE 2-E 2-03-00c-A
BY CAROLYN FRANCIS
21183