


NORTH  
ASSUMED  
MERIDIAN

SCALE  
1" = 100'

NOTE -  
\* CLOSURE ON "3"  
w/ N83-10 E 133.30'  
= 1:47.49'  
L - 0.02  
D - 0.03

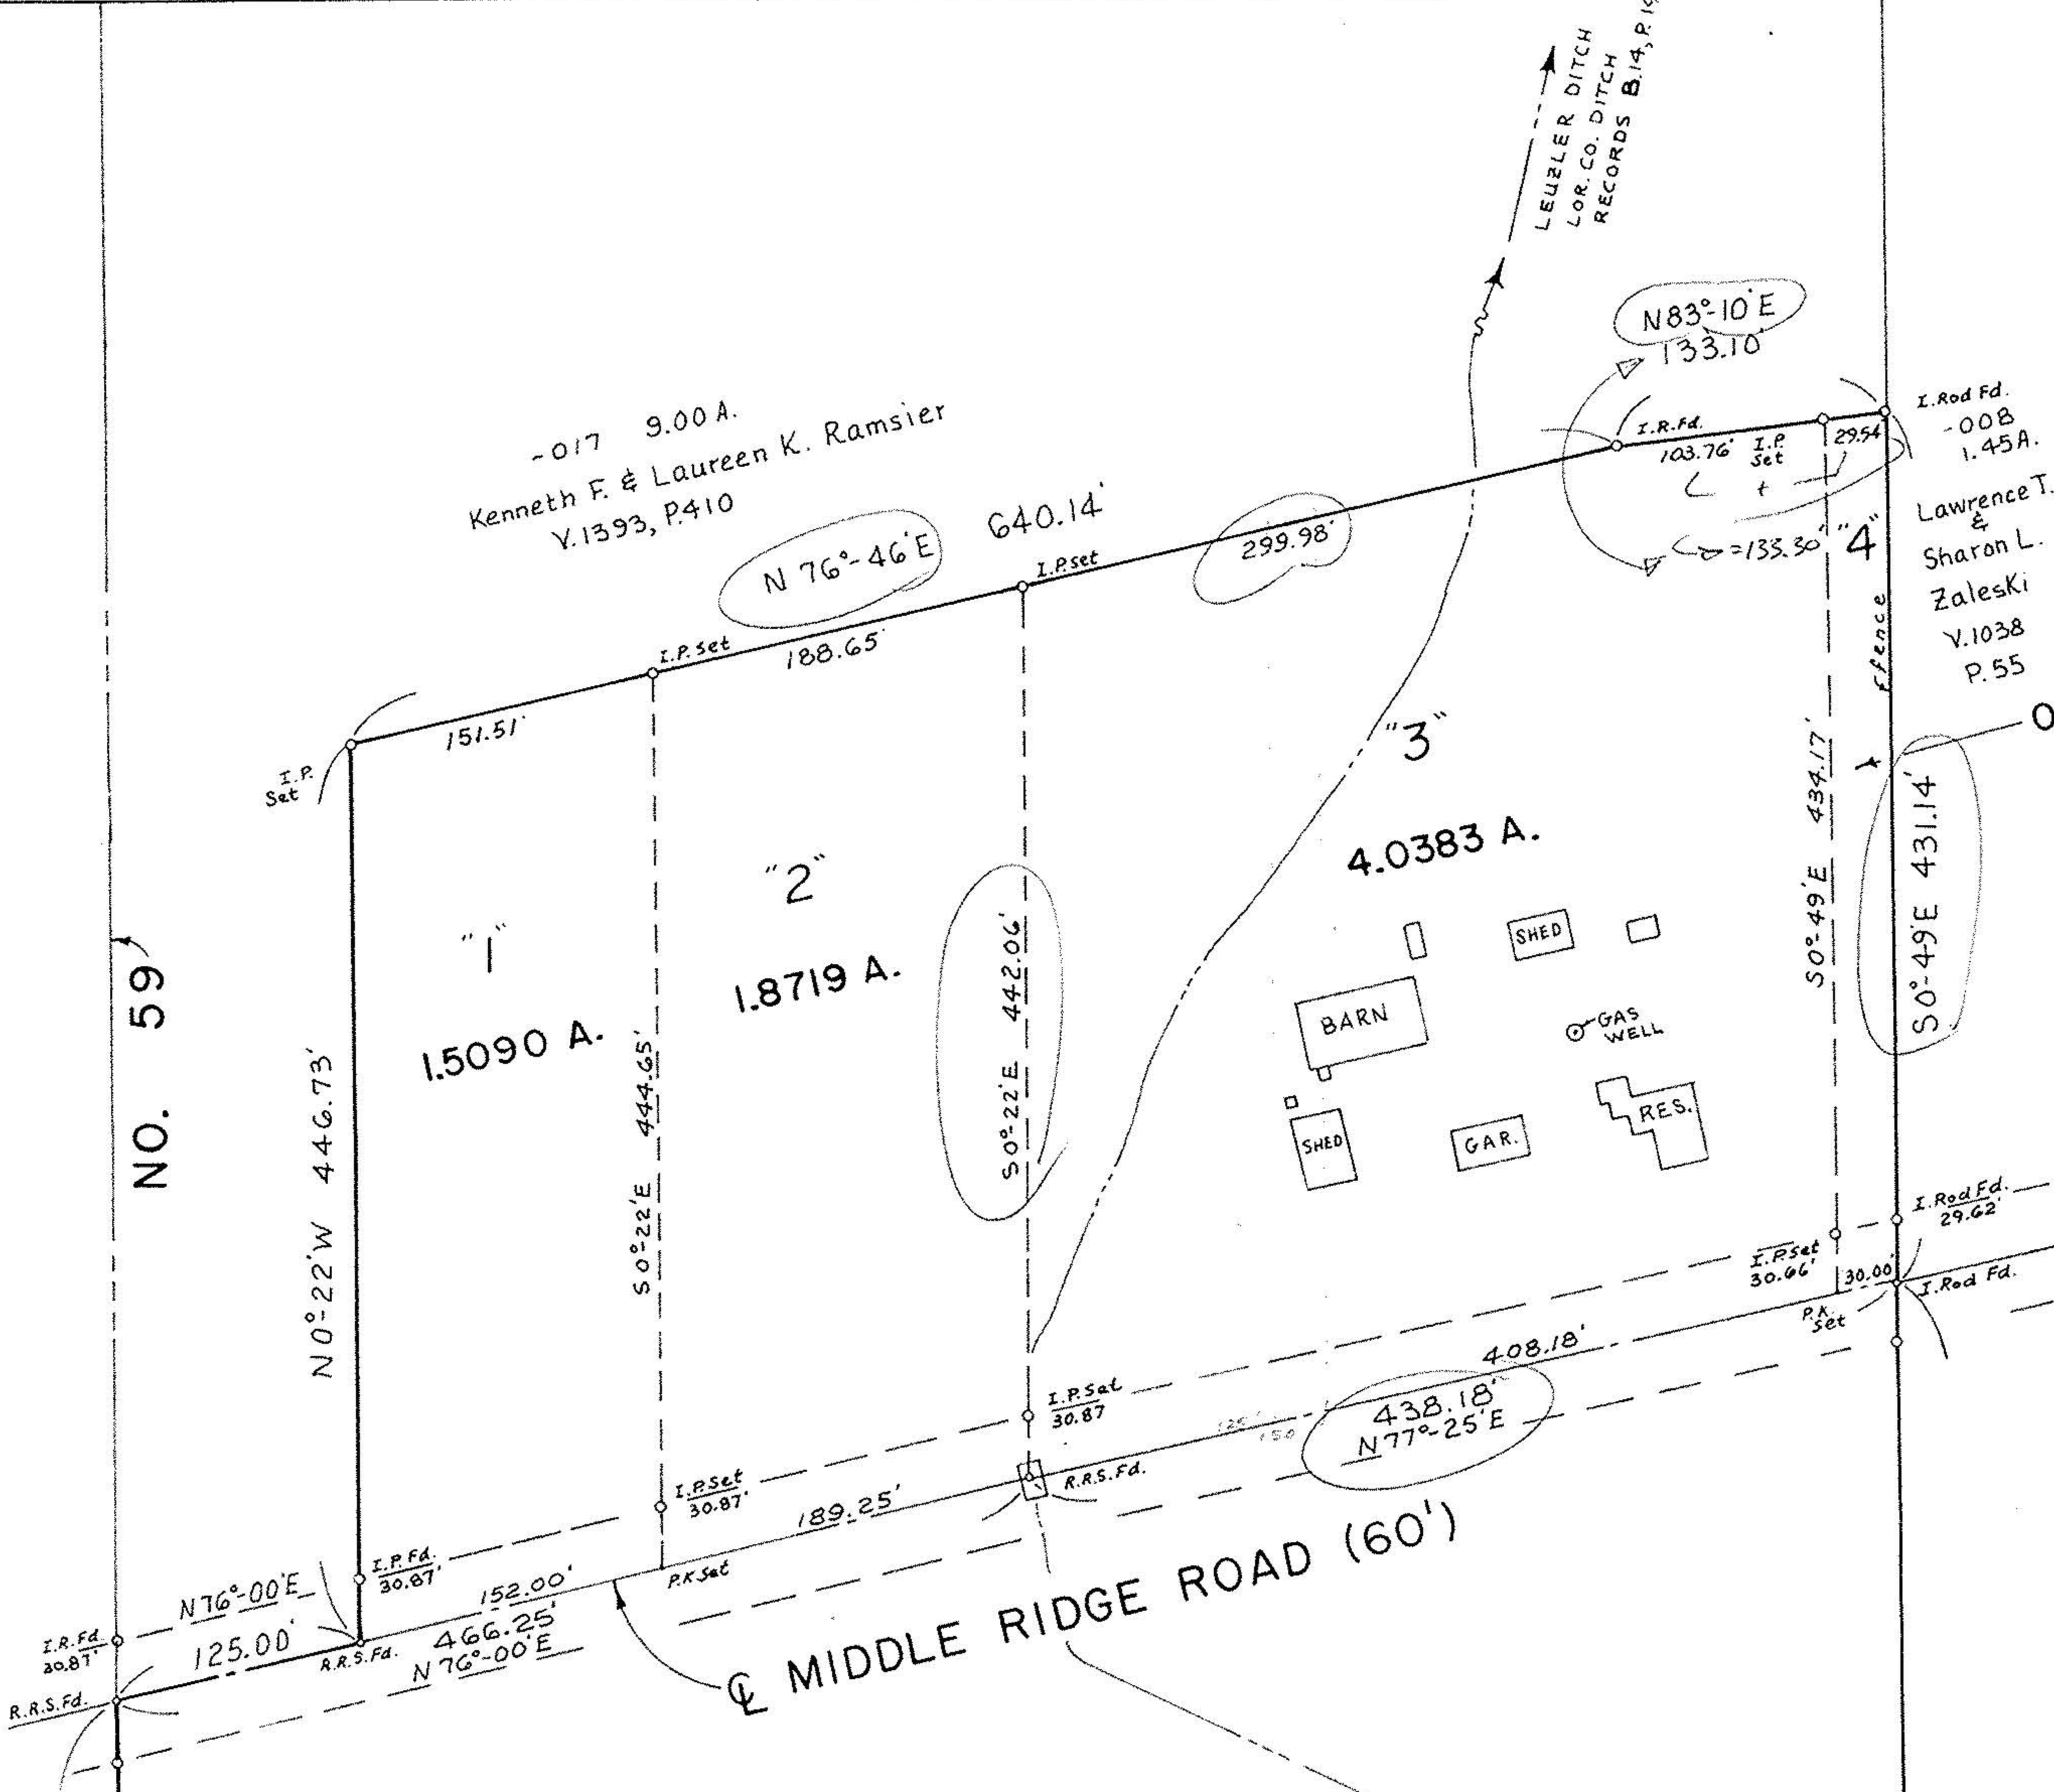

NO. 59  
LOT  
ORIG.  
LINE  
WEST

-018 41.00 A. Tax Dupl.  
Mabel E. Van Wagnen  
V.1237, P. 20

19798

|                    |
|--------------------|
| APPROVED           |
| LORAIN CO.         |
| MAP DEPT.          |
| DATE 2-26-92       |
| PAGE 1-K           |
| BY CAROLYN FRANGIS |
| VOID # 19793       |
| AFTER              |

-004 45.00A.  
Kenneth E. & Ruth E. Spiegelberg  
O.R.V. 276, P. 924

SUMMARY

- 1. 1.5090 Acres
- 2. 1.8719 "
- 3. 4.0383 "
- 4. 0.2918 "
- 5. 34.8446 "

Total = 42.5556 Acres  
By Survey

SURVEY REQUESTED BY:  
D.R. Goldthorpe, P. O. A.,  
Attorney

-025 28.13 A.  
Donald C. & Mary P. Baetz V.1361, P.470  
N 1°-03' W 1613.94'

O.L. 60  
O.L. 69  
-004 5.00A.  
D.C. & M.P. Baetz  
V.1361, P.470

O.L. 59  
O.L. 70  
N 88°-48'-14" W 872.28'

-001 50.00A.  
Donald C. & Mary P. Baetz  
V.1361, P.470