I-00 - 066
067
068
069

SURVEY FOR REUBEN MILLER ET AL

BROOKHELM TWP LORAIN CO OHIO

SCALE 1"200' MAY 3 1957

Revised March 29-75

BY A.F. KOFFP REG. SURVEYOR

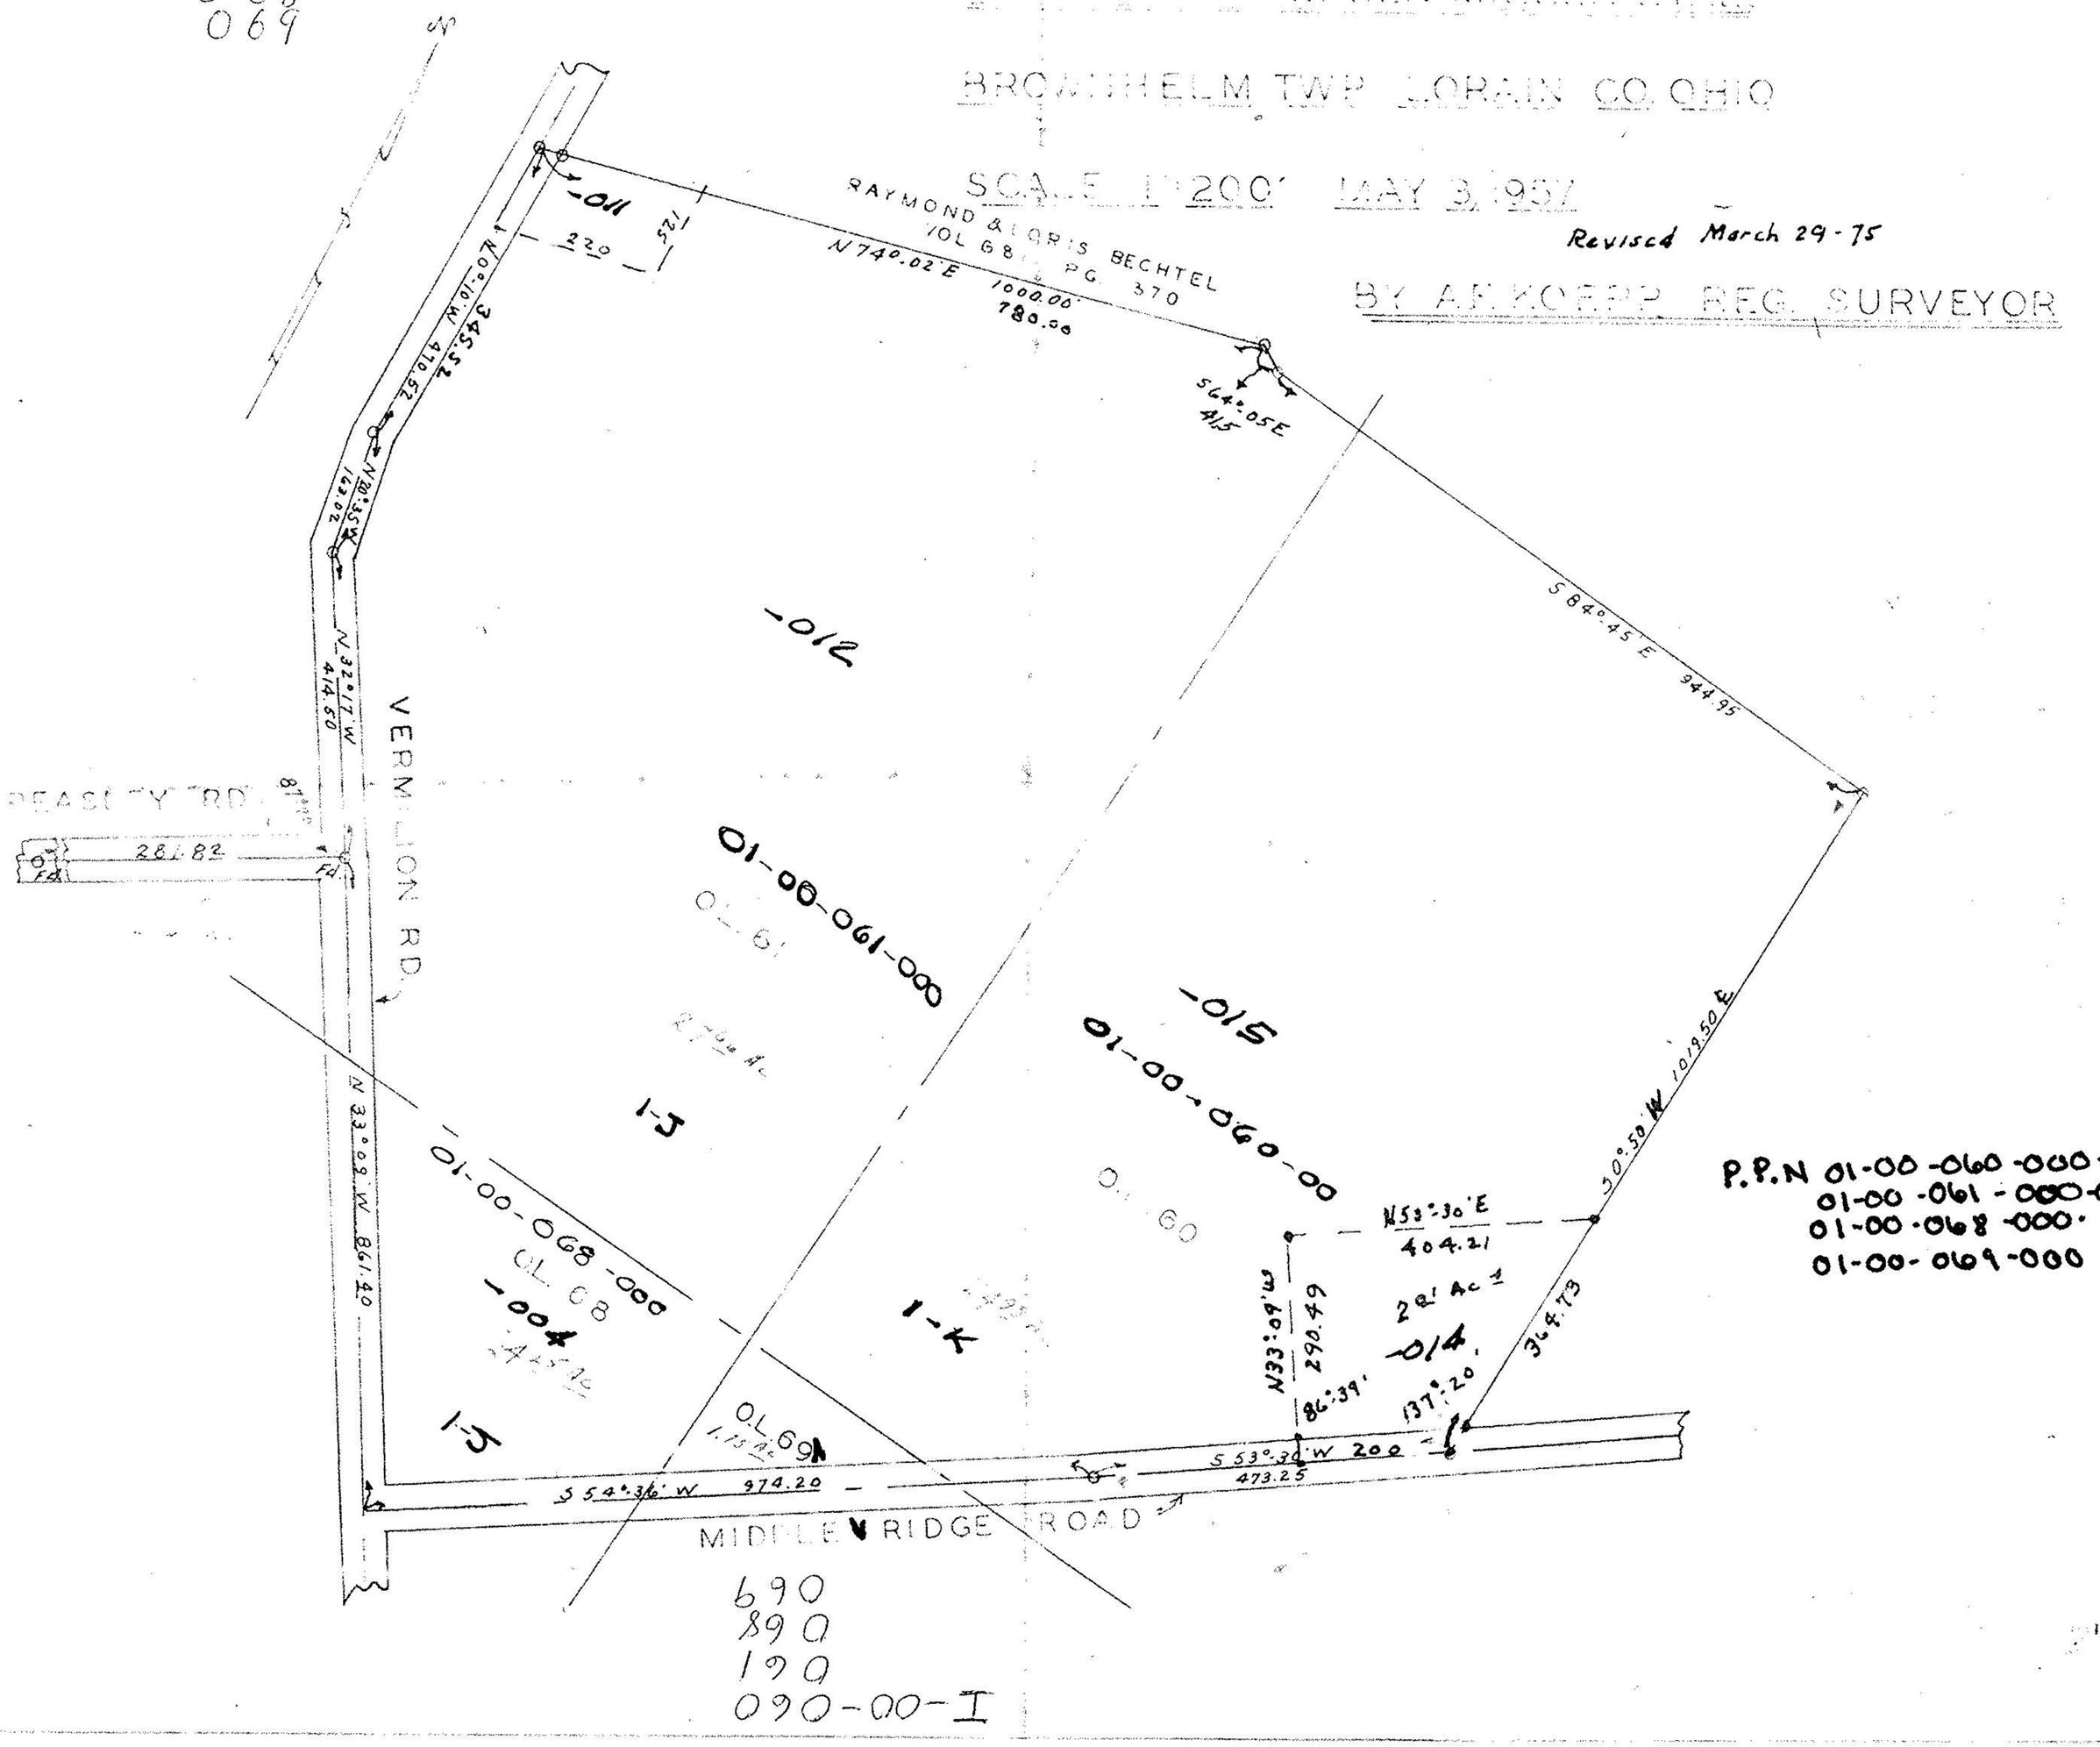

P.P.N 01-00-060-000-015
01-00-061-000-012
01-00-068-000-004
01-00-069-000

690
890
190
090-00-I