01-00-060-000-018

#17269

LAUNDON . SIMON . CAHL & ASSOC. INC.
CONSULTING ENGINEERS & SURVEYORS
219 COURT ST. ELYRIA, OHIO 44035

SURVEY FOR:

DONALD C. BAETZ

Orig. Lot 60	City of	Date JAN. '87 Scale 1"=200'
Orig. Sec	Village of	Dwn. by R.G.S. Chkd. by C.J.
Tract	County of LORAIN	Job No. 86-1560 F.B. —
Township of BROWNHELM	State of OHIO	Printed JAN 3 1 1987

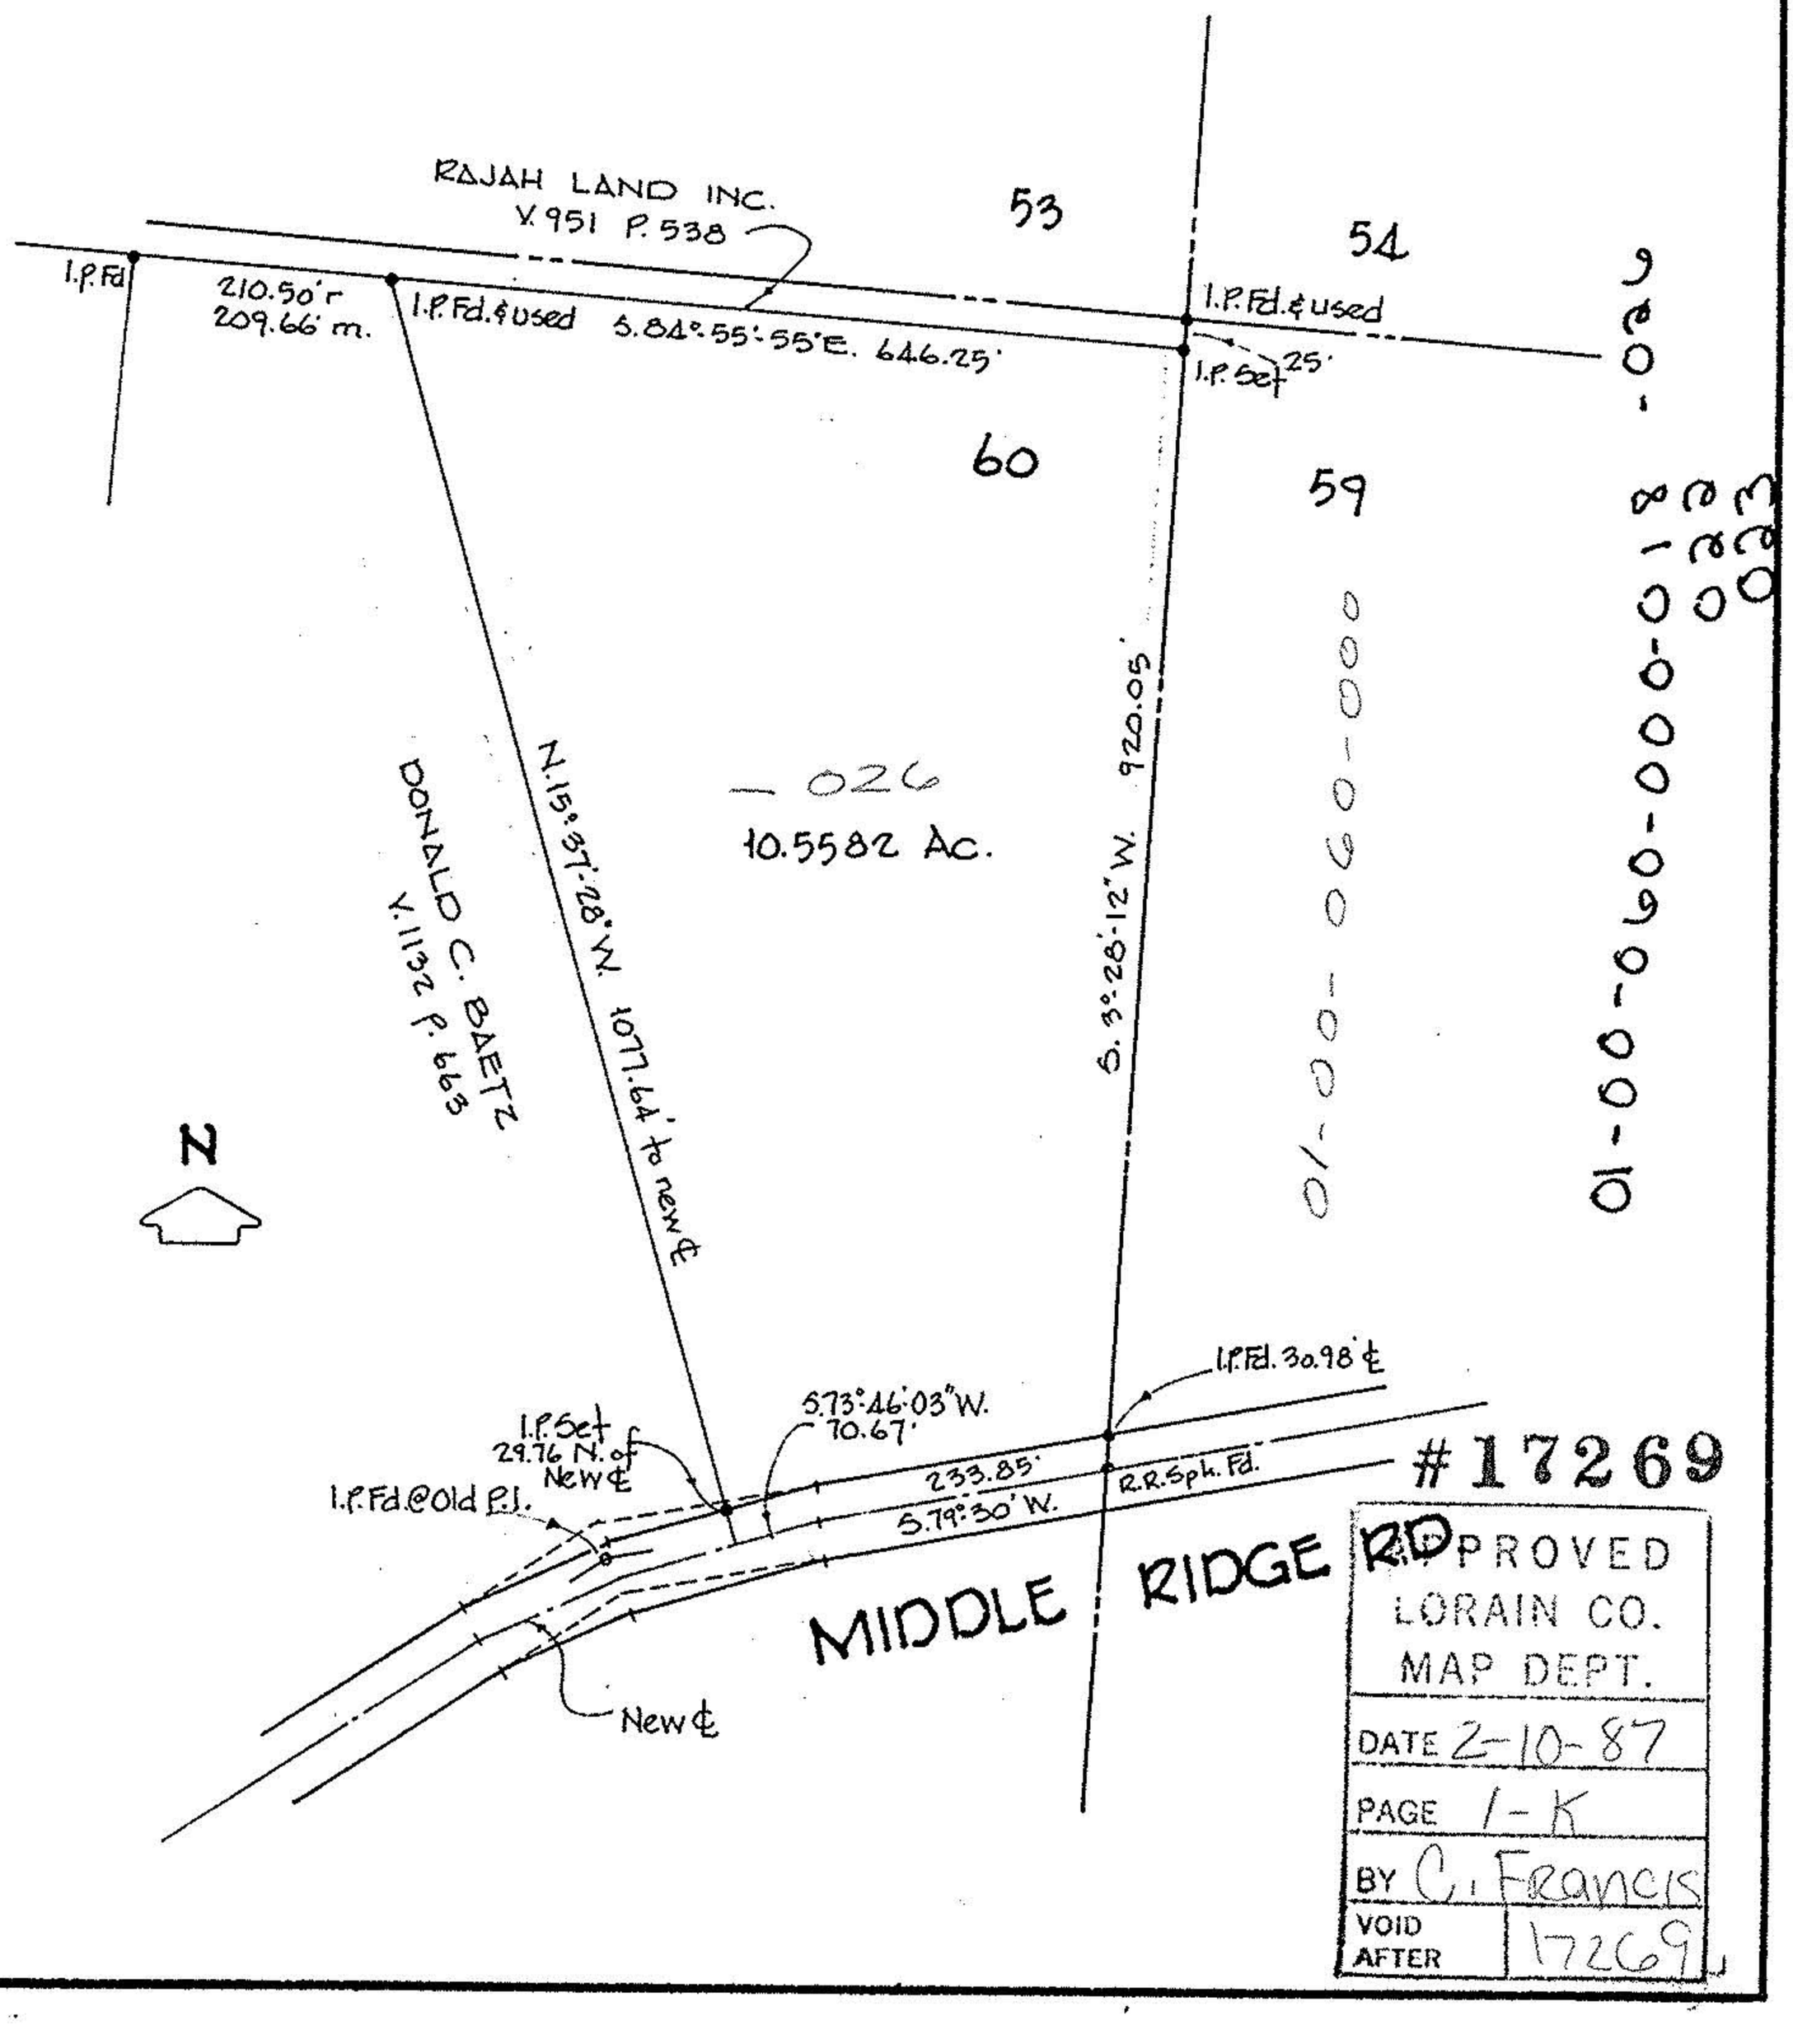

#17269

APPROVED
LORAIN CO.
MAP DEPT.
DATE 2-10-87
PAGE 1-K
BY C. Francis
VOID AFTER 17269

1-K