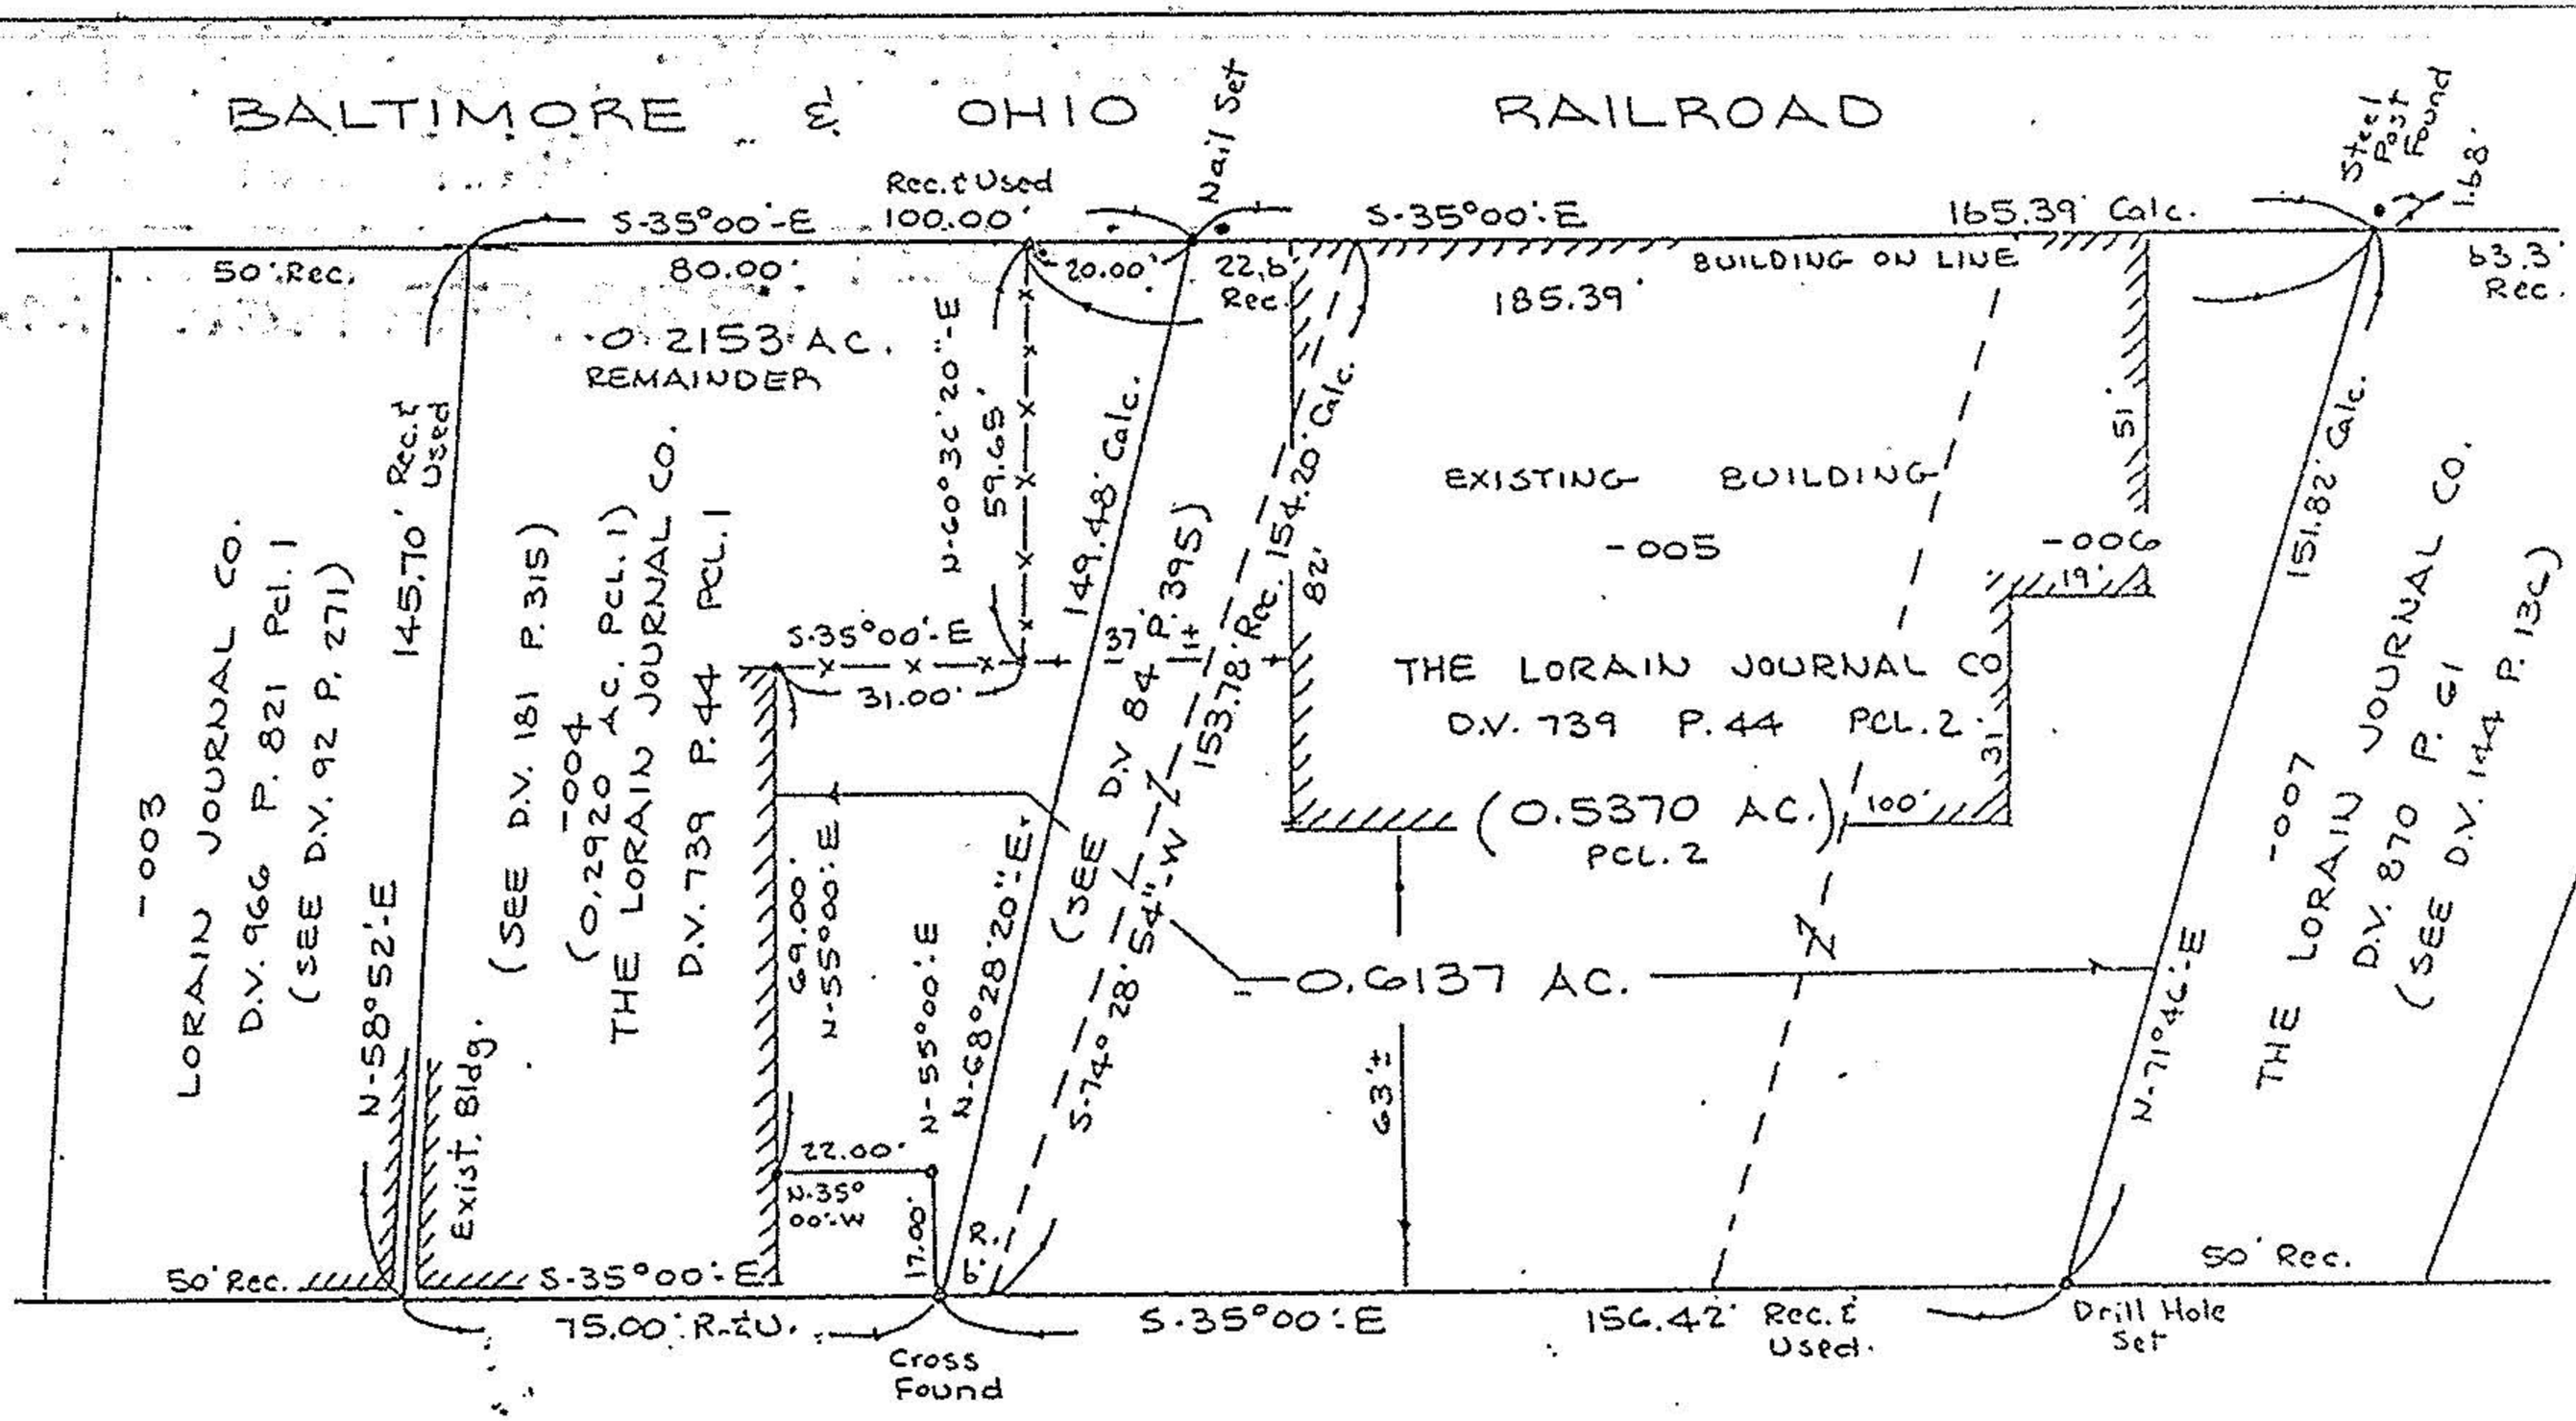

SCALE: 1" = 40'
JUNE 1987
REVISED 6-22-87

BEARINGS SHOWN ARE ASSUMED AND FOR THE PURPOSE OF DESCRIBING ANGLES ONLY.

BOUNDARY SURVEY

OF PART OF

BLACK RIVER TOWNSHIP

ORIGINAL LOT 3 TRACT 1

CITY OF LORAIN COUNTY OF LORAIN

STATE OF OHIO

PREPARED BY

KS ASSOCIATES INC.
CONSULTING ENGINEERS & SURV.

87-157

REV. 7-7-87

02-00-051-00-10-020
-010