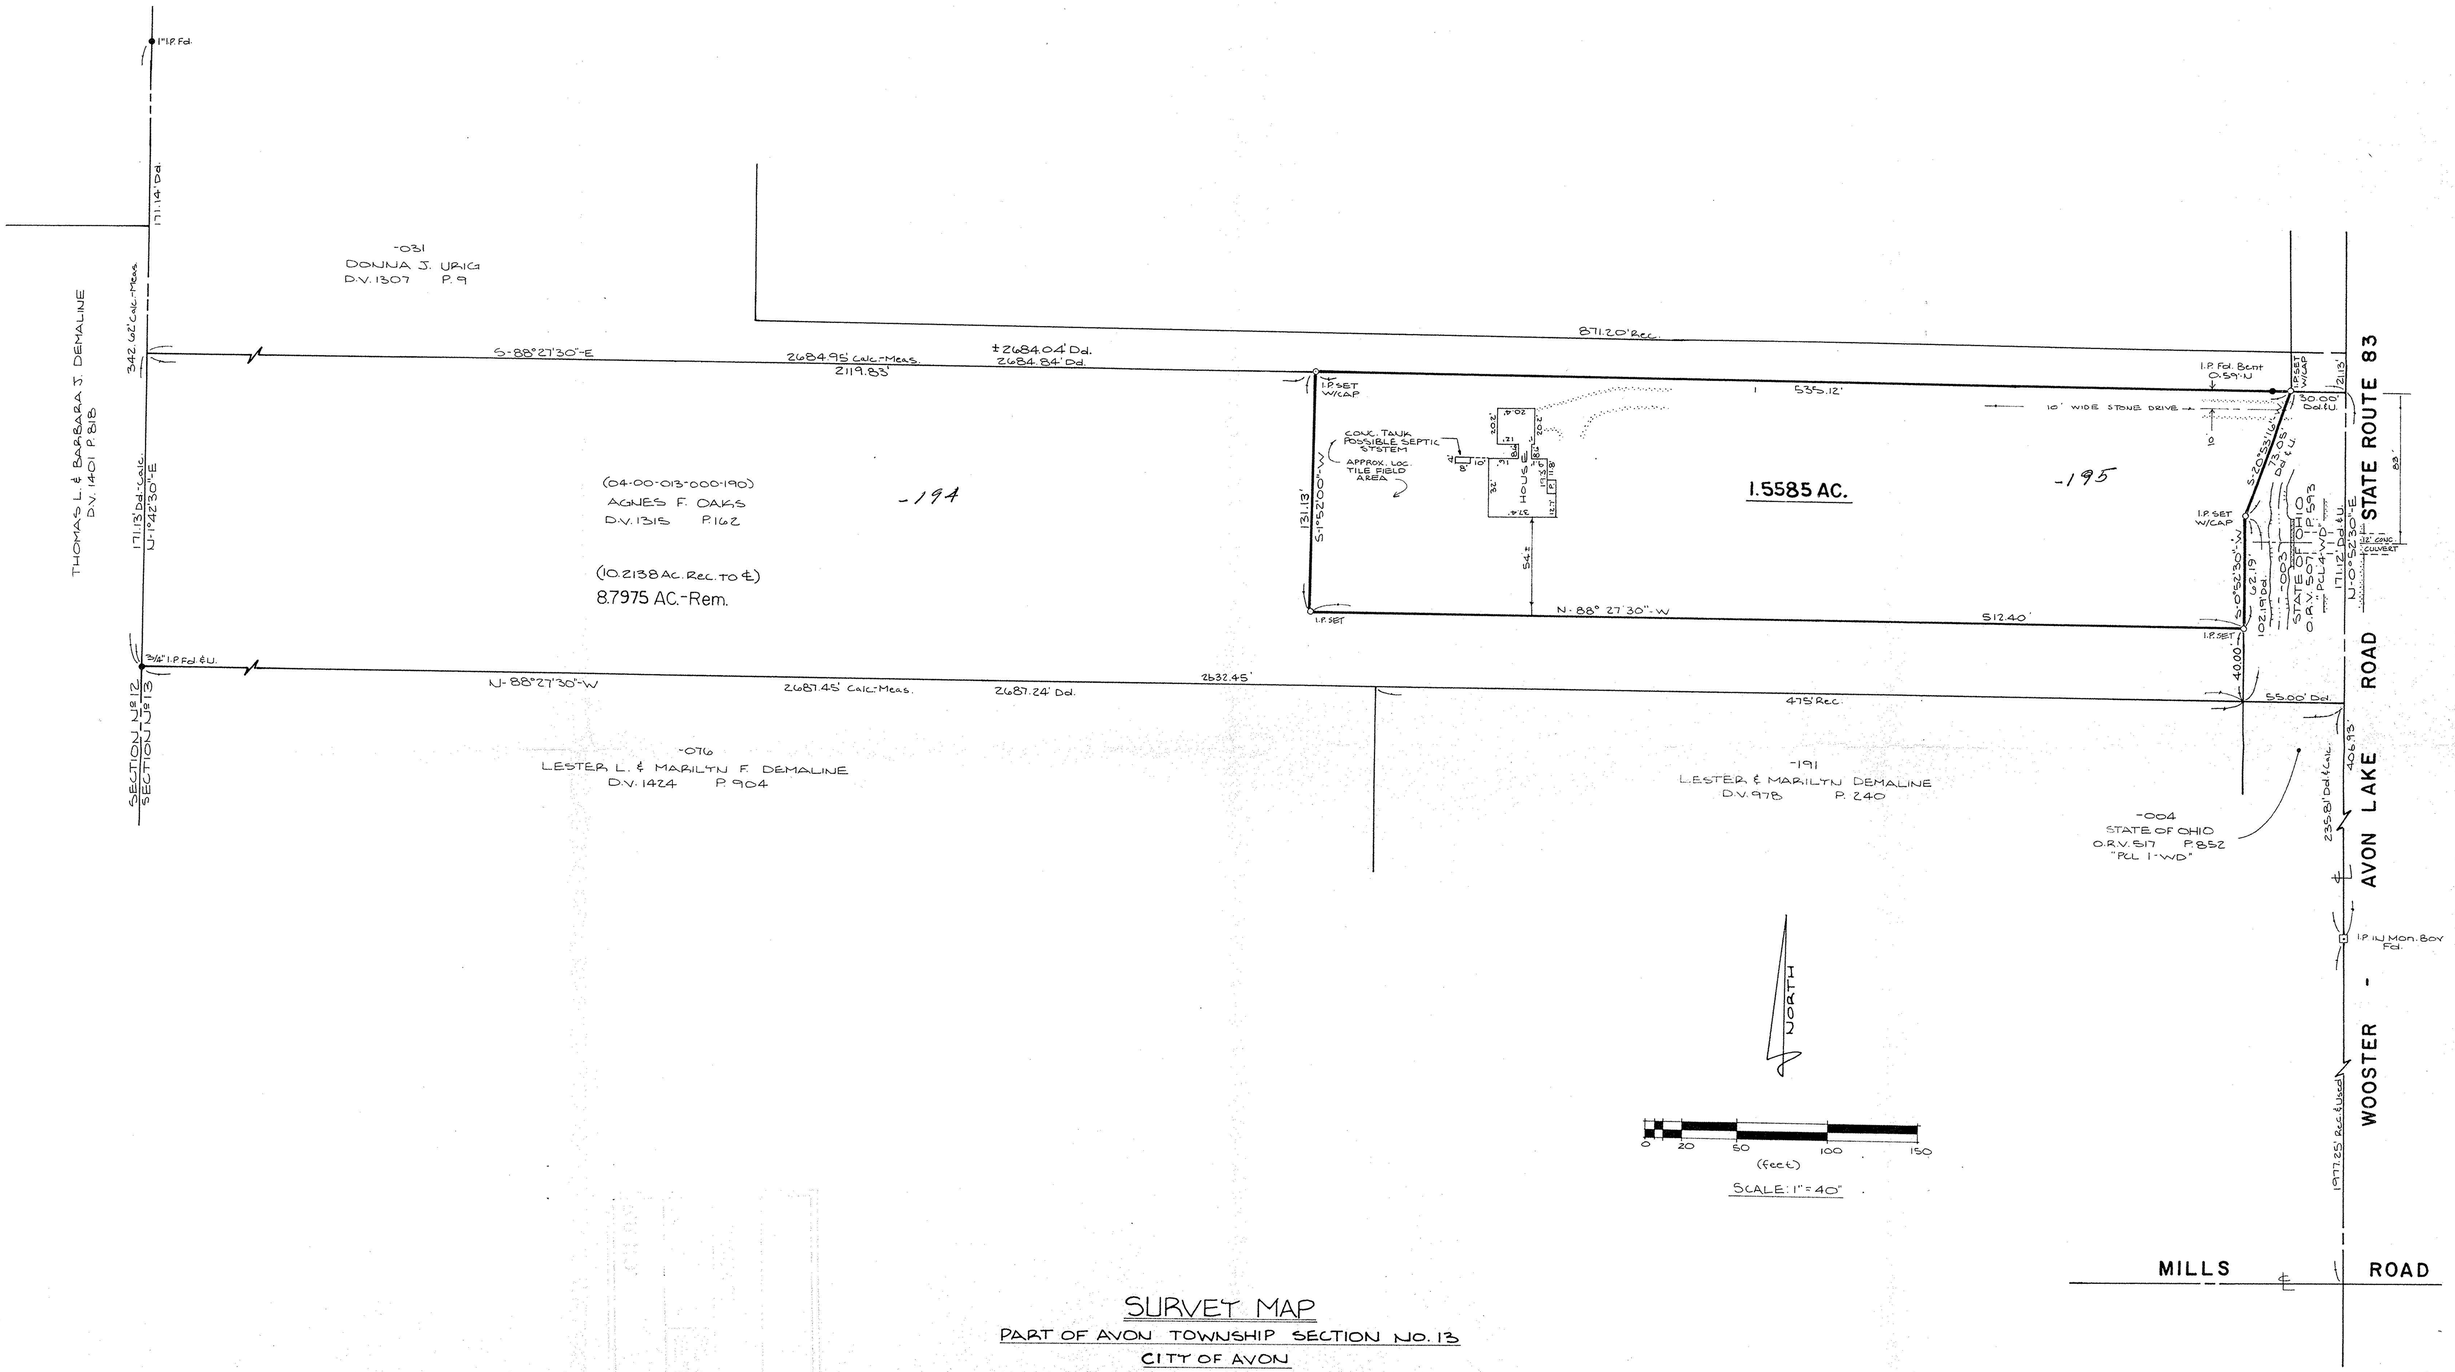

SURVEY MAP

PART OF AVON TOWNSHIP SECTION NO. 13

CITY OF AVON

COUNTY OF LORAIN — STATE OF OHIO

DATE: AUGUST 24, 1993
REV. JAN. 27, 1994

SCALE: 1" = 40'

PREPARED BY:
KS ASSOCIATES INC.
ENGINEERS SURVEYORS

Michael A. Straub
MICHAEL A. STRAUB, P.S.
REG. SURVEYOR NO. 7055

STATE OF OHIO — MICHAEL A. STRAUB — 7055 — REGISTERED PROFESSIONAL SURVEYOR

20789
APPROVED
LORAIN CO.
MAP DEPT.
DATE 4-1-94
PAGE 4-00-013 E / 4-00-013 F
BY CAROLYN FRANCIS
VOID AFTER # 20789

04-00-013-000-

93-4-16