02-01-004-114-014

SCHAFER, HURA & ASSOCIATES, INC.

ENGINEERS AND SURVEYORS
4656 OBERLIN AVE.
LORAIN, OHIO

10th STREET 66'

02-01-004-114-014

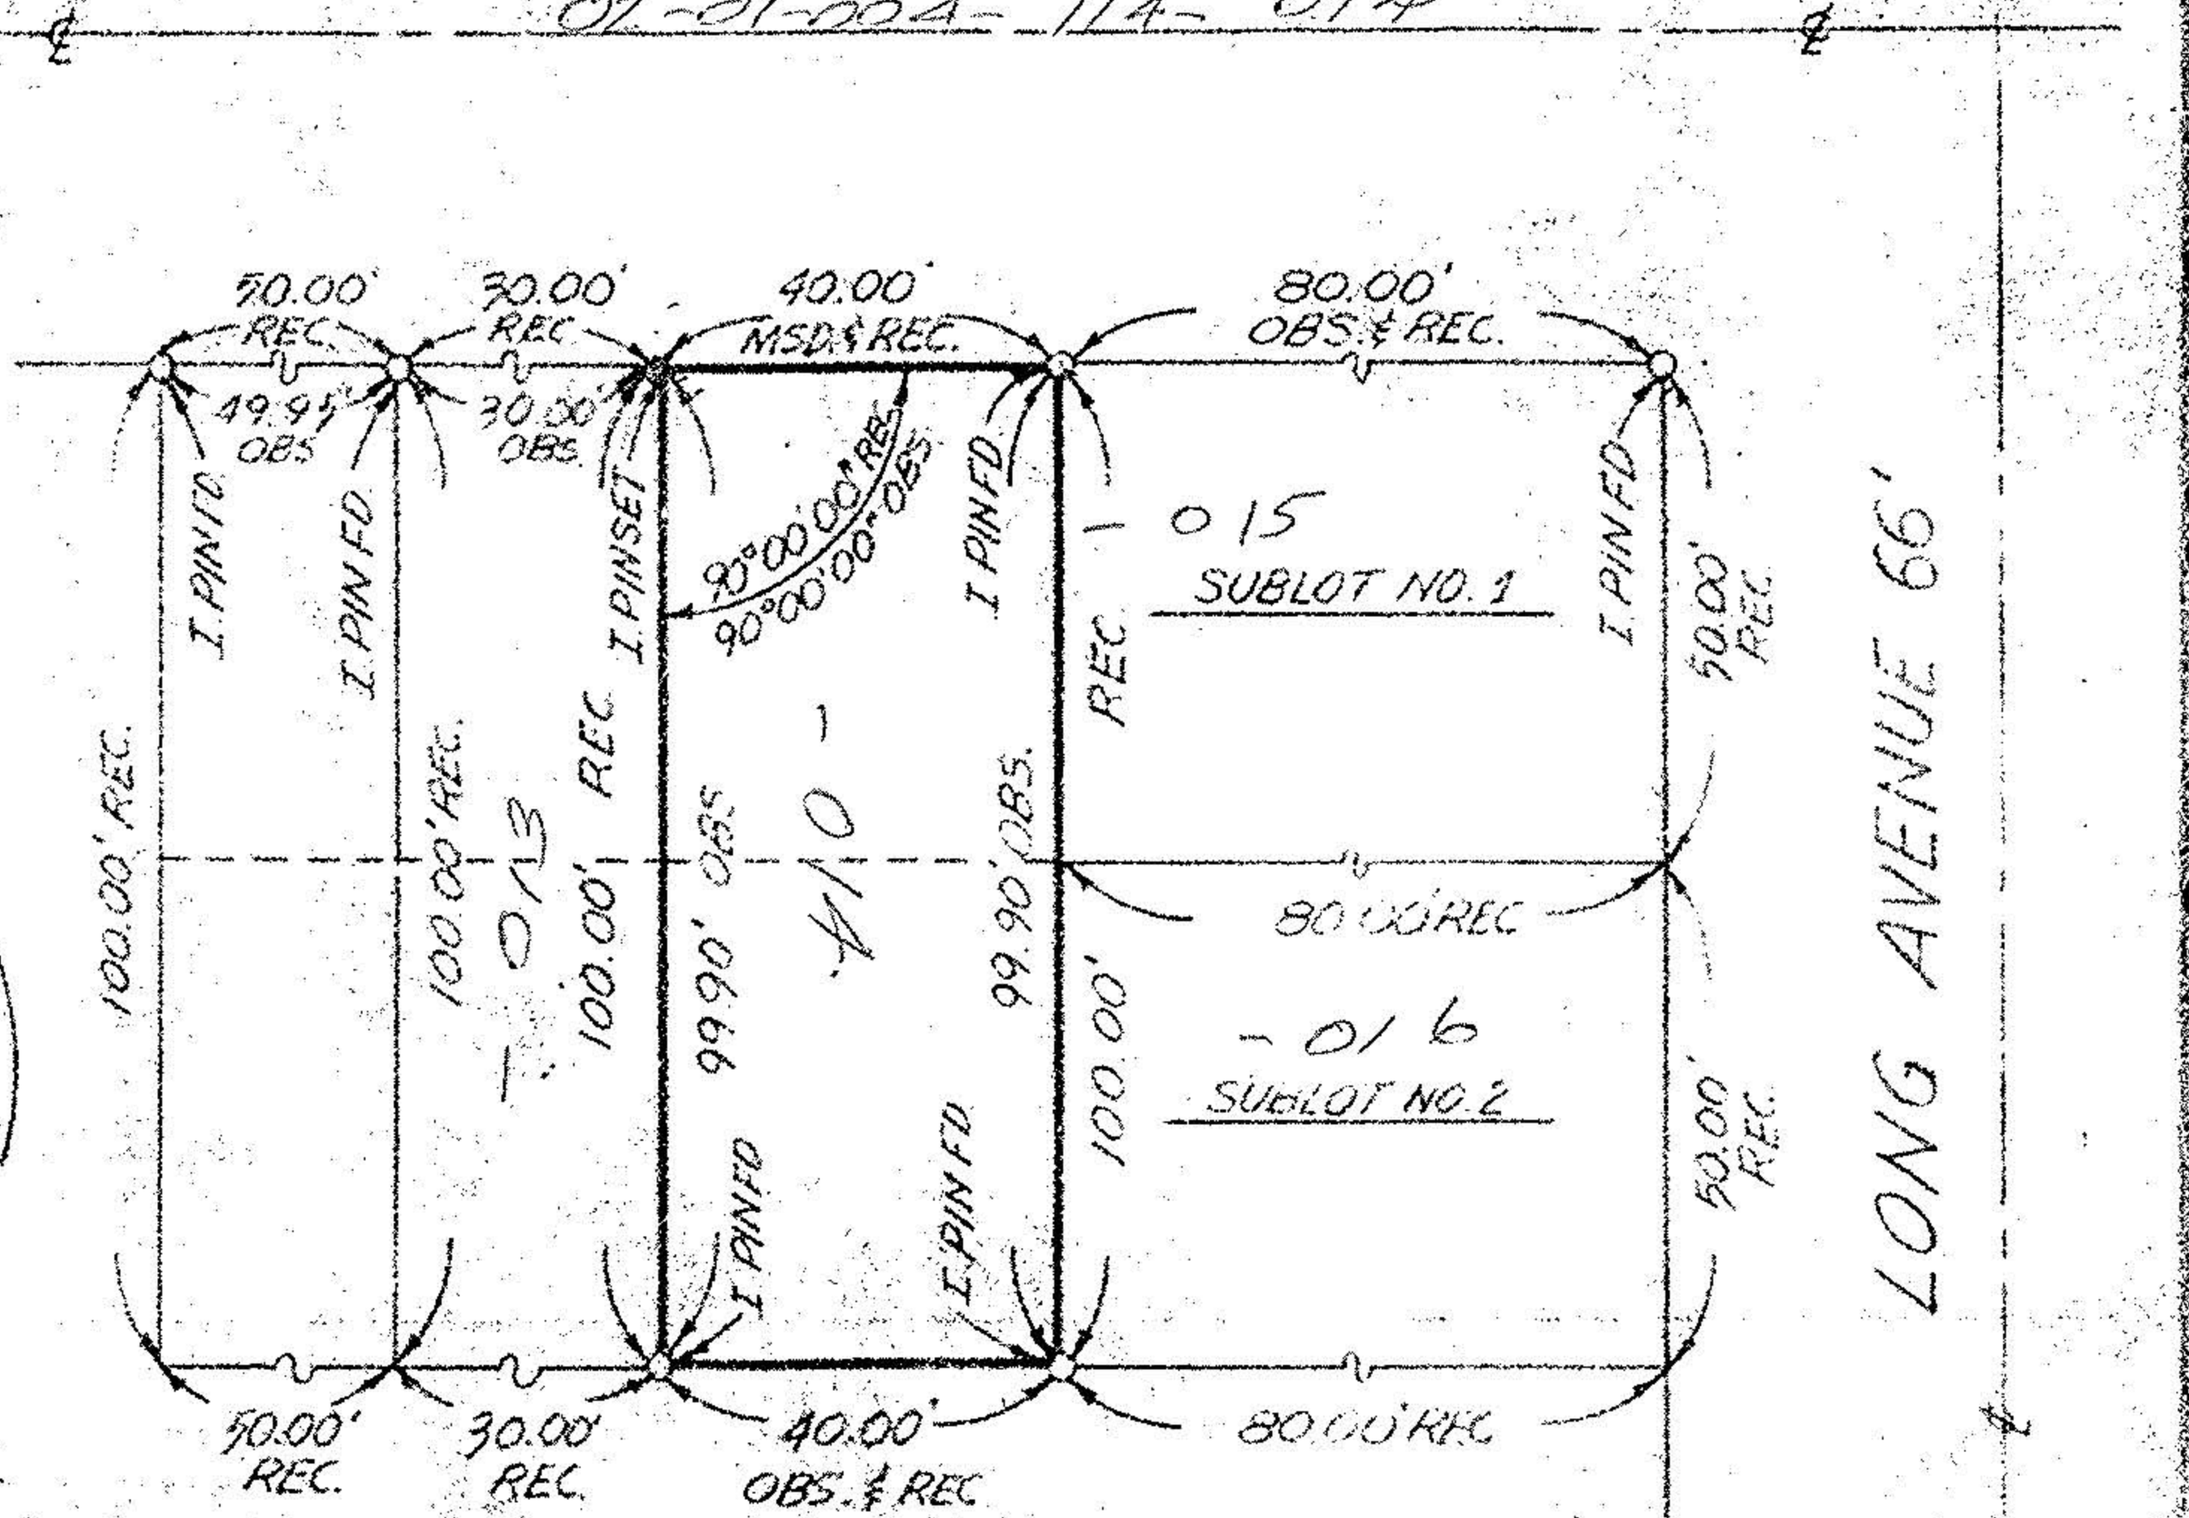


SURVEY OF THE WESTERLY 40.00' OF THE EASTERLY 120.00' OF SUBLOTS NO. 1 AND 2 OF CHAMBERLAIN'S ADDITION VOL. 2, PG. 11

DONALD THOMPSON
807 TENTH STREET
LORAIN, OHIO 44052

ORIGINAL LOT 4 TRACT 1	DATE JULY 17, 1974
TOWNSHIP OF BLACK RIVER	SCALE 1" = 30'
CITY OF LORAIN	FIELD BOOK 225 Pg. 107
COUNTY OF LORAIN	DRAWN BY R.W.H.
STATE OF OHIO	CHECKED BY JFK
W. O. 2145	FILE NO. 2-01-4

02-01-004-B