P.P.N 02-01-003-270

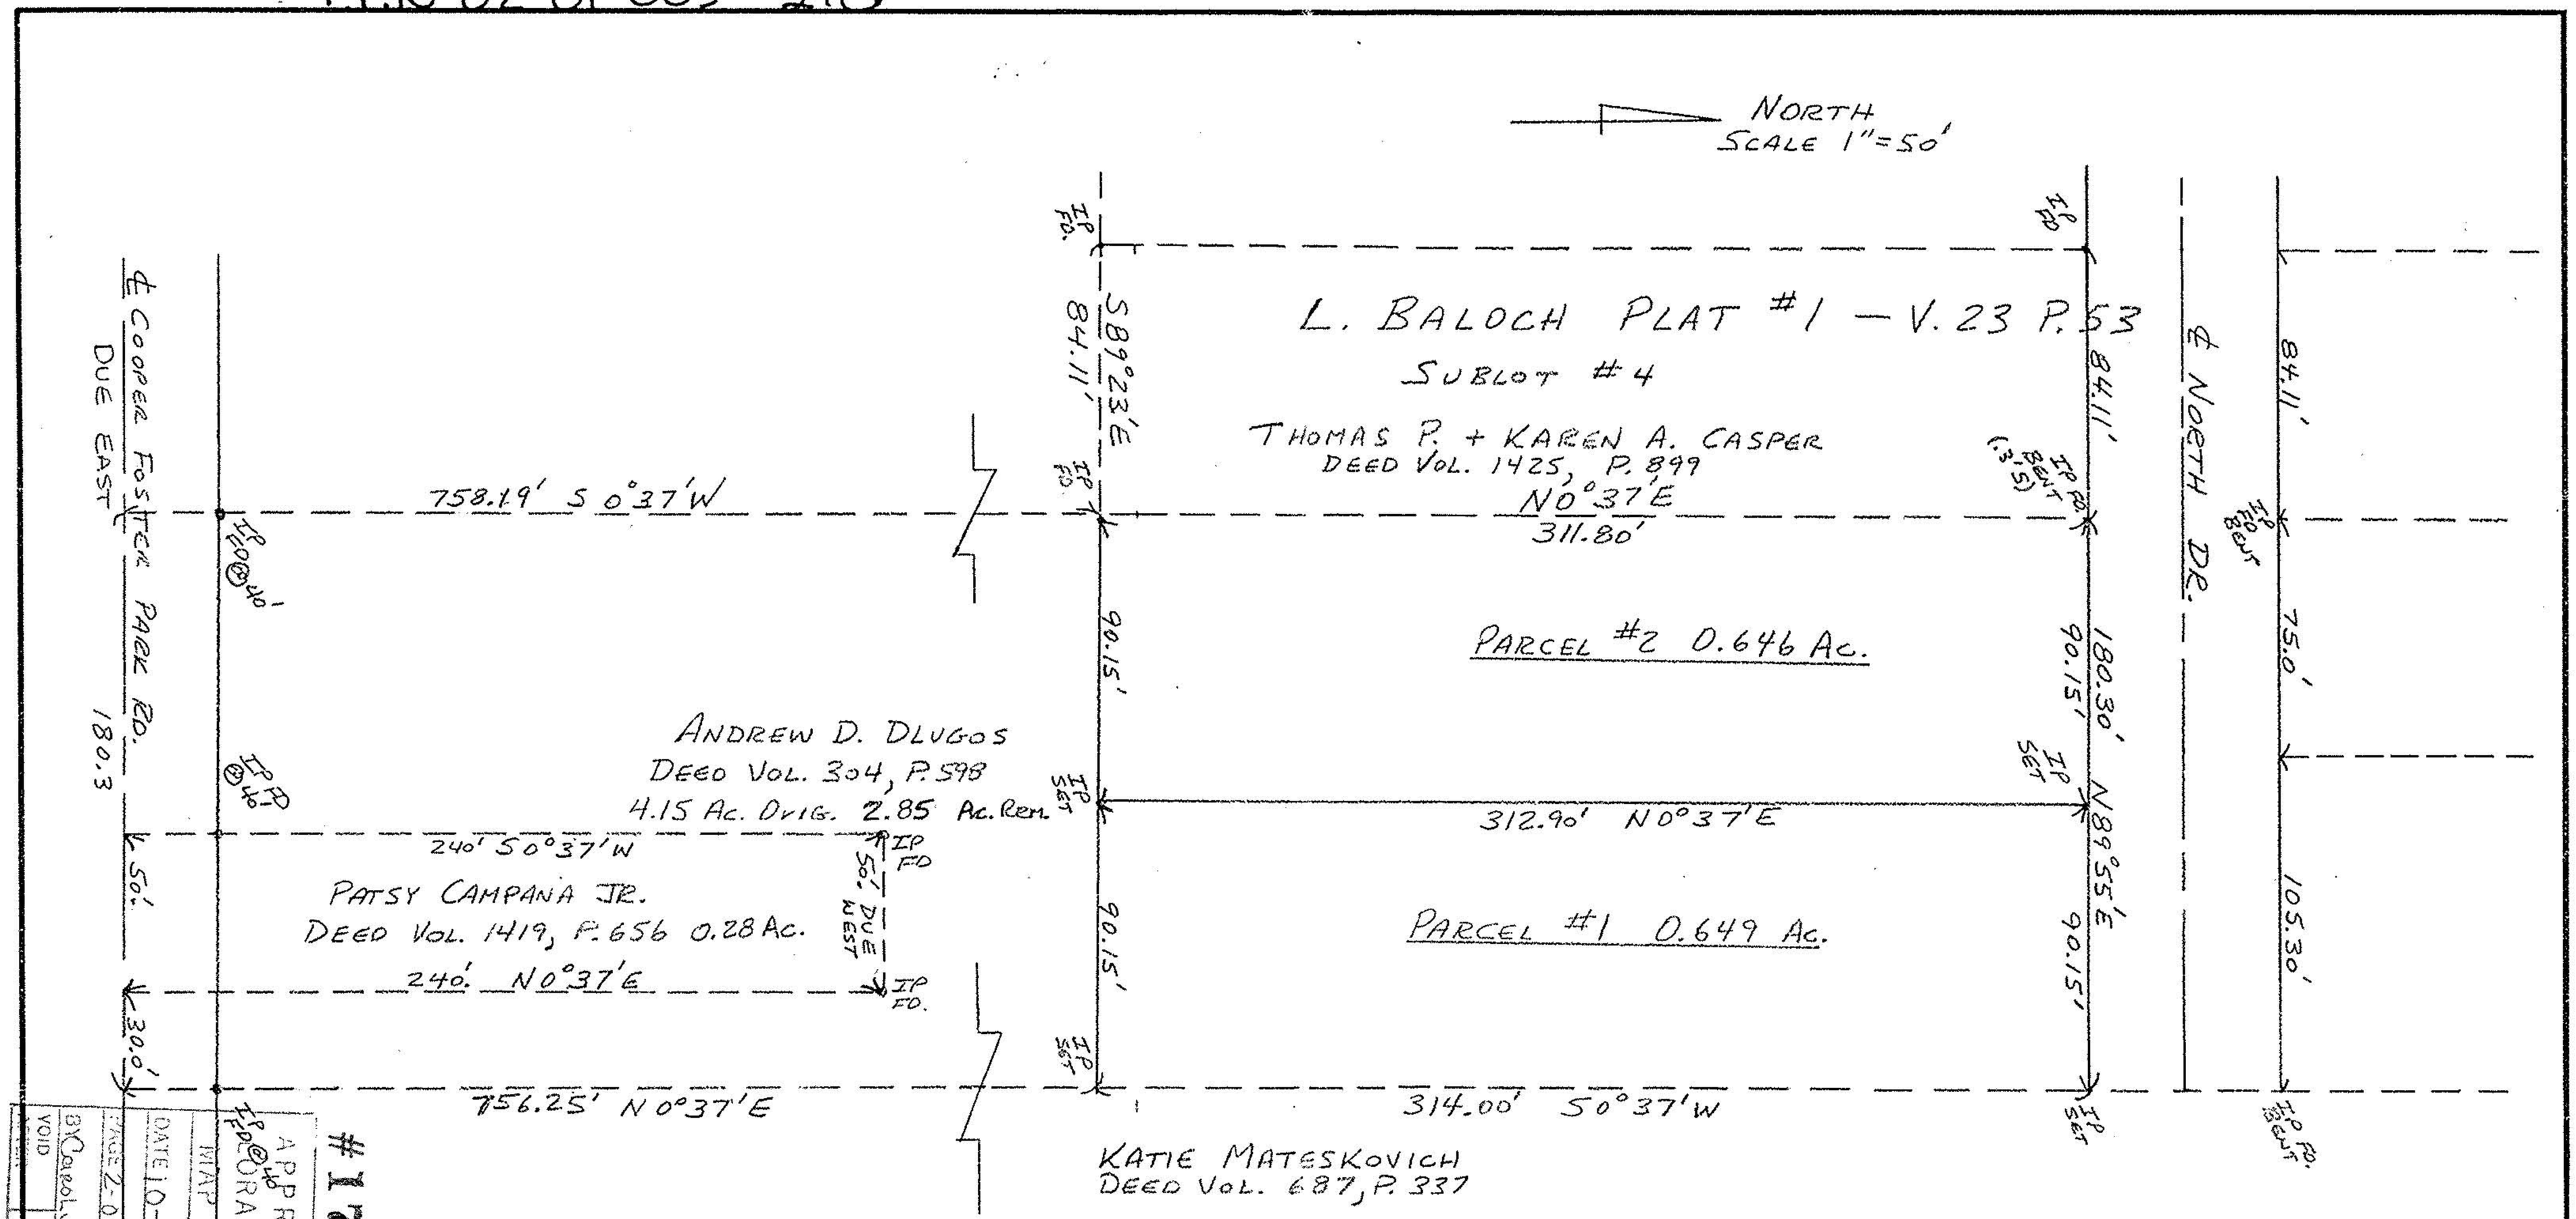

APPROVED
LORAIN CO.
MAP DEPT.
DATE 10-20-87
PAGE 2-01-003 N
BY Carolyn Francis
VOID 17730

#17730

APPROVED BY THE LORAIN CITY PLANNING COMMISSION 10-8-87 NO PLAT REQUIRED
SECRETARY LORAIN CITY PLANNING COMMISSION

STATE OF OHIO
JOHN R. HAMILTON
6861
REGISTERED
PROFESSIONAL SURVEYOR

APPROVED
AS TO DESCRIPTION ONLY
Date 13-October-1987
City of Lorain
Per Patrick McGannon
Engineering Dept.

SURVEY FOR ANDREW RUSIN
O.L. 3 — TRACT 1 — BLACK RIVER TWP.

SCALE: 1"=50'	APPROVED BY	DRAWN BY JRH
DATE: 8/24/87		
JOHN R. HAMILTON — REG. SURV. #6861		
		DRAWING NUMBER

NATIONAL NO. 185A-11X17