SURVEY OF
PART OF BLACK RIVER TOWNSHIP
ORIGINAL LOT Nº 7
TRACT Nº 1

CITY OF LORAIN COUNTY OF LORAIN STATE OF OHIO

SCALE : 1" = 60 SURVEY 1" = 20' LOCATION DETAIL

AUGUST 4, 1967

BY
RAY E. HOLLIS
REGISTERED SURVEYOR

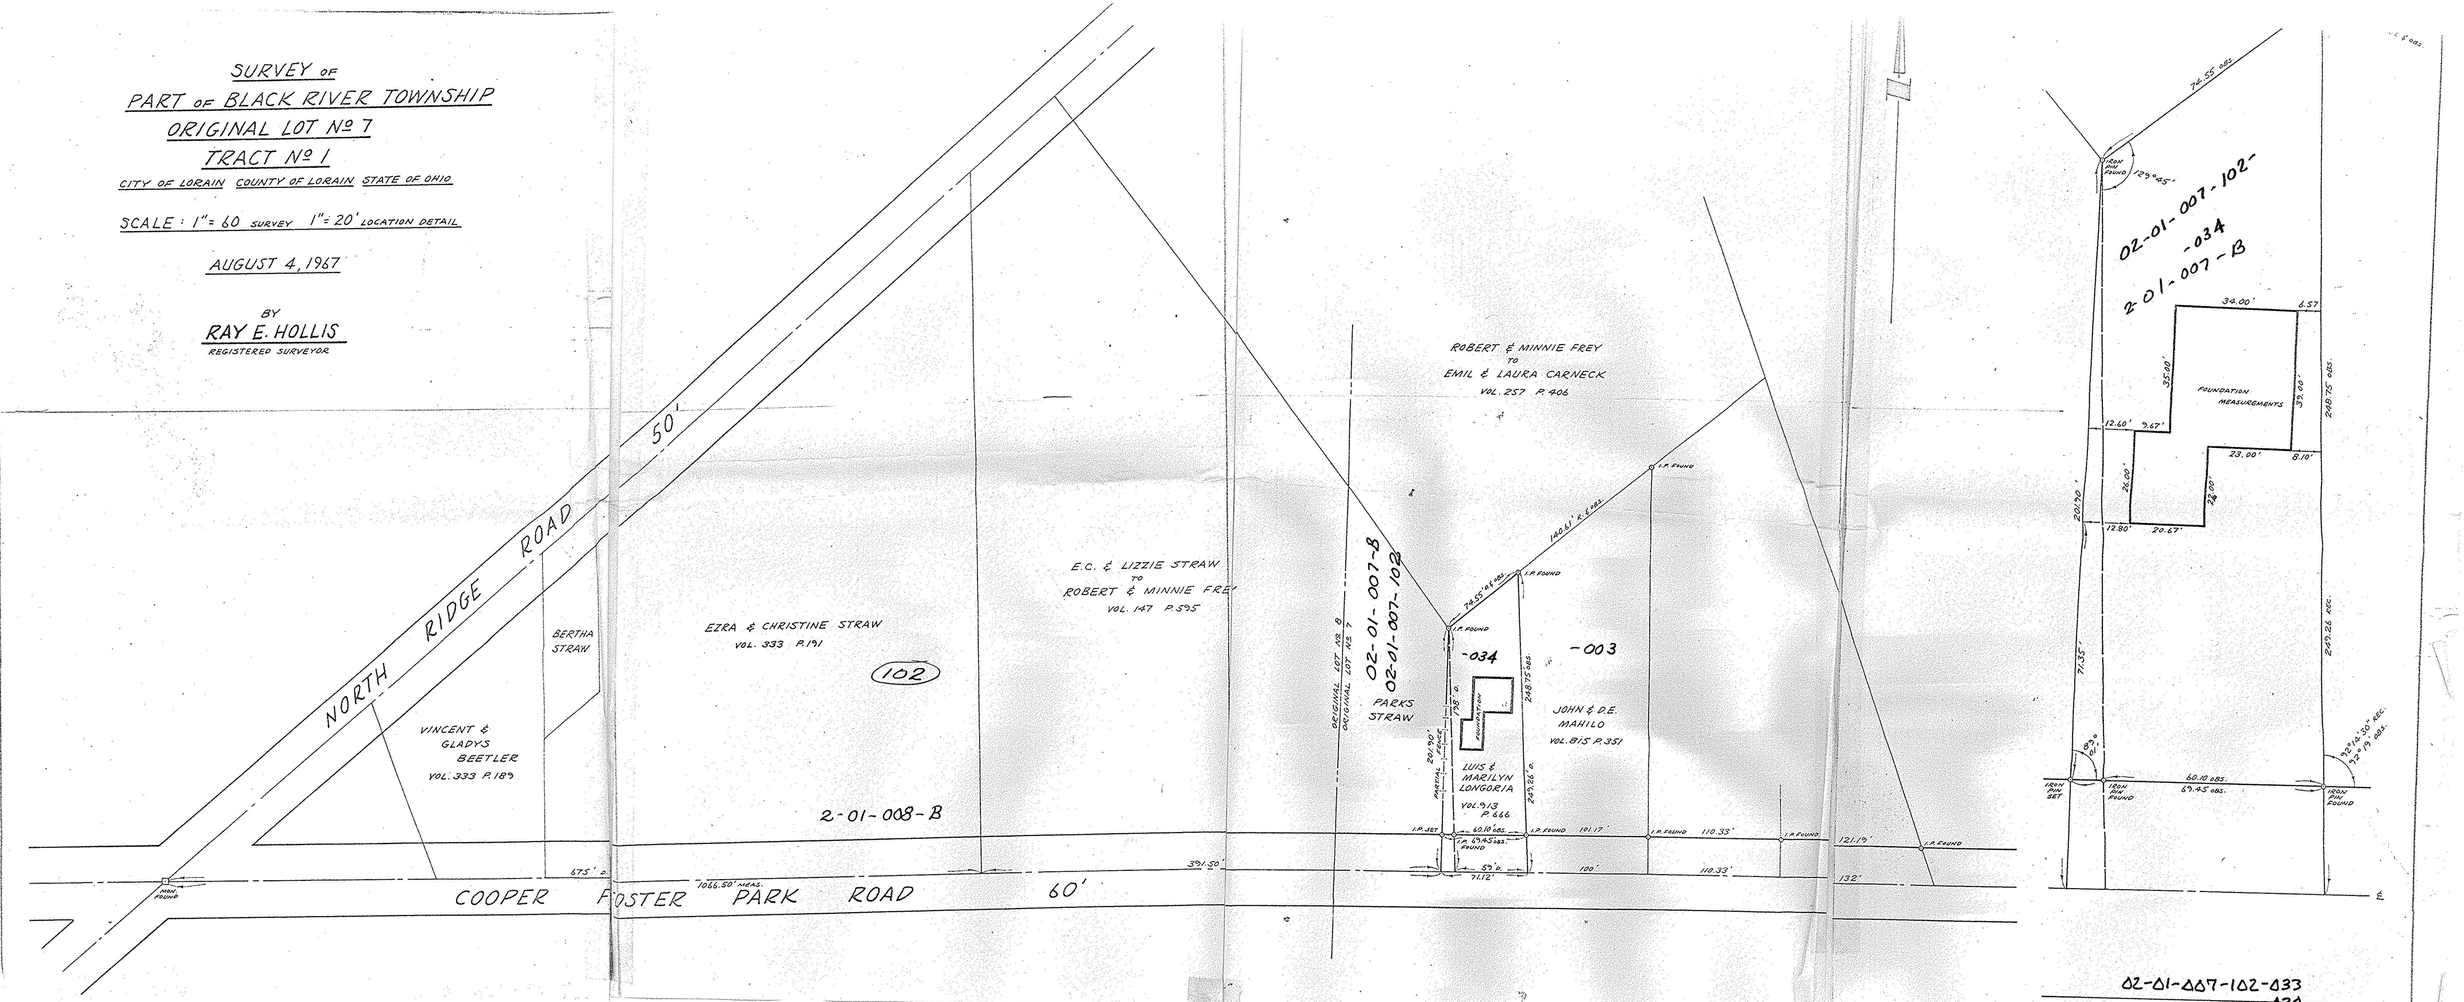

02-01-007-102-033
-034