LAUNDON • SIMON • CAHL and ASSOC
ENGINEERS — SURVEYORS
504 MIDDLE AVE — ELYRIA, OHIO 4035

FOR: ALLAN W. BOROSKI

TOWNSHIP BLACK RIVER	VILLAGE	DATE FEB. 27, 1980
ORIG. LOT or SEC.	COUNTY LORAIN	SCALE 1"=30'
CITY LORAIN	STATE OHIO	JOB NO. 80950 F.B. NONE

02-01-006-A

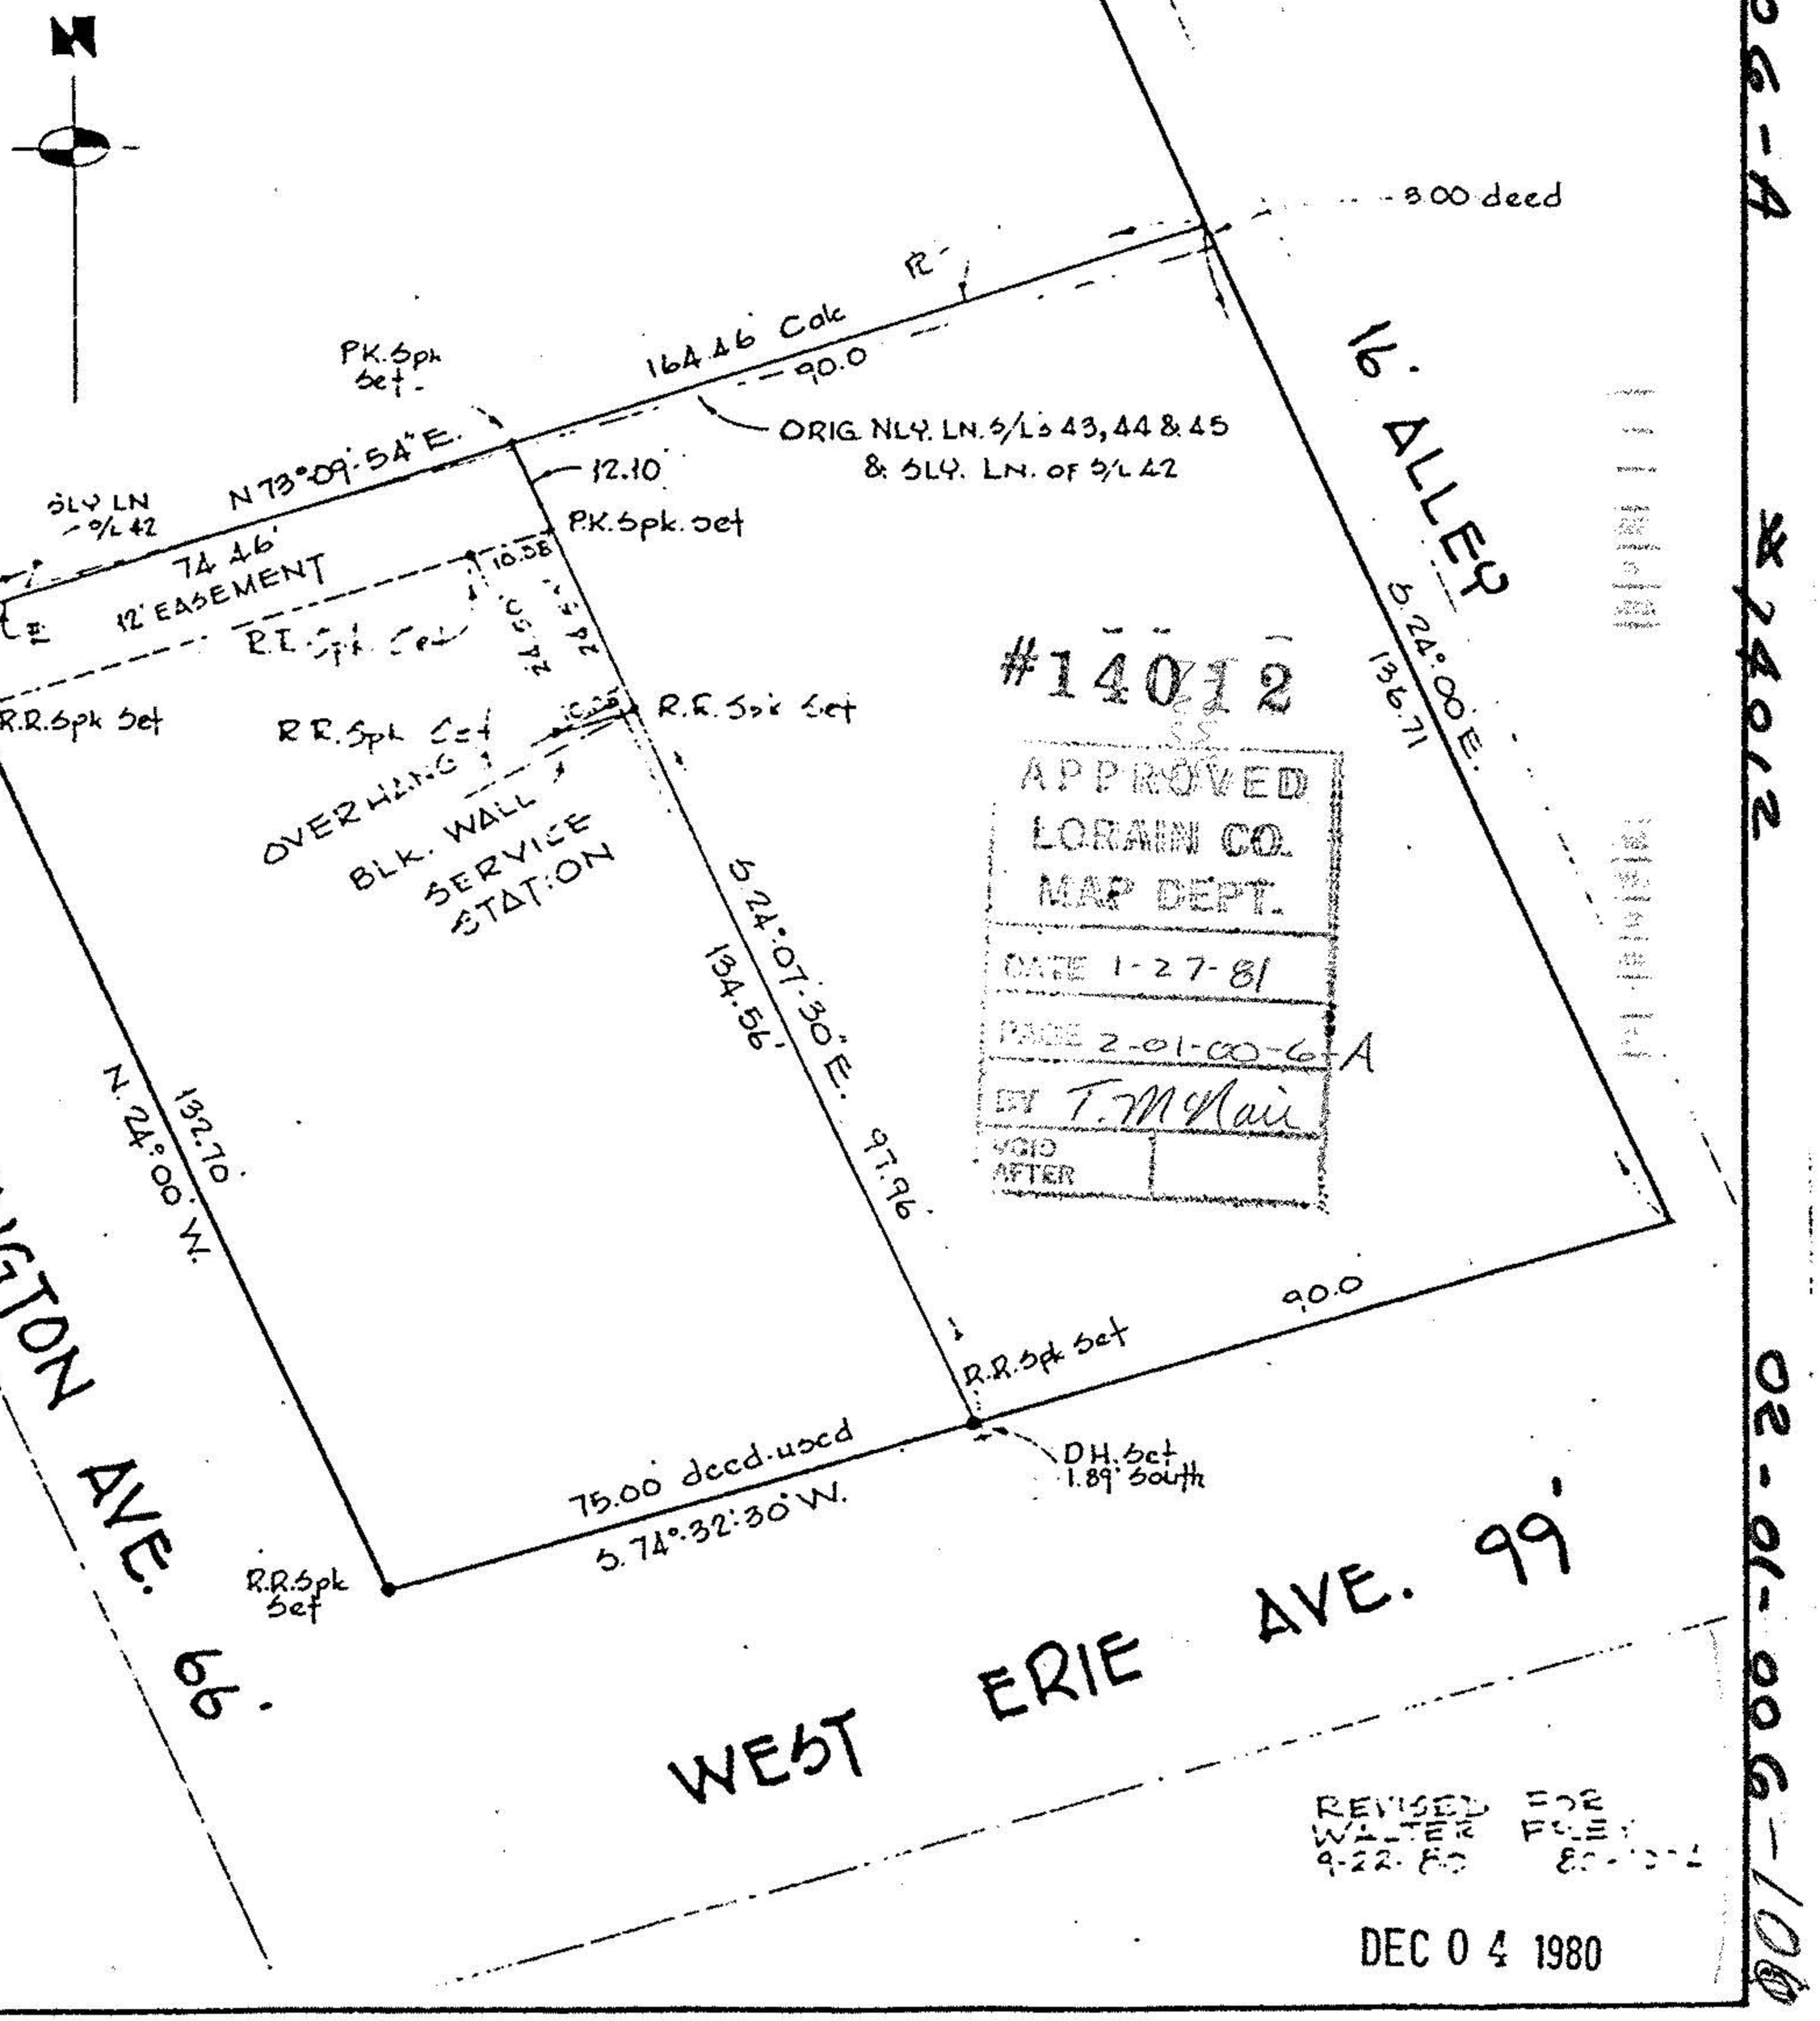

#14012

APPROVED
LORAIN CO.
MAP DEPT.
DATE 1-27-81
PAGE 2-01-00-6-A
BY T. McNair
VOID AFTER

REVISED FOR WATER FILE 9-22-80

DEC 0 4 1980

02-01-006-A