NEW DESCRIPTION. BLOCK "B":

SITUATED in the City of Lorain, County of Lorain and State of Chio. Being known as part of Block "B" of Hickory Hill Subdivision No.7 and part of Original Black River Township Lot 7 in Tract 2. bounded and described as follows:

BEGINNING at the northeast corner of Block"B" as recorded in Hickory Hill Subdivision No.7, Volume 41, Page 2 of Plat Records. THENCE South 88°45'40" West along the north line of Block "B", a distance of 184.19 feet to the northwest corner thereof. THENCE South 1°04'46" West, a distance of 32.20 feet to a point. THENCE South 0°36'00" East, a distance of 39.55 feet to a point. THENCE North 89°46'15" East, a distance of 185.96 feet to the place of beginning, embracing 0.312 acre of land, but being subject to all legal highways.

NEW DESCRIPTION, FLOWERS:

SITUATED in the City of Lorain, County of Lorain and State of Ohio. Being known as part of Block "B" of Hickory Hill Subdivision No. 7 and part of Original Black River Township Lot 7 in Tract 1, bounded and described as follows;

BEGINNING at the most southerly corner of Block "B" of Hickory Hill Subdivision No. 7 as recorded in Vloume 41, Page 2 of Lorain County Plat Records, said corner being in the westerly line of Washington Avenue. THENCE North 1°14'20" West along said westerly line, a distance of 116.61 feet to a point. THENCE South 89°46'15" West, a distance of North 35°09'30" East, a distance of 485.62 feet to the centerline of North Ridge Road. THENCE North 49°37'00" East along the centerline of NOrth Ridge Road, a distance of 80.00 feet to a point. THENCE North *33°33'00" West along a westerly line of Washington Avenue, a distance of 275.20 feet to the place of beginning, embracing 0.986 acre of land, but being subject to all legal

REGISTERED SURVEYOR #12706 - R.D. 2 MASON RD. - VERMILION, OHIO 44089 - PHONE 965-4040

1/10th ACRE, TOWNER TO FLOWERS:

SITUATED in the City of Lorain, County of Lorain and State of Ohio. Being known as part of Block "B" as recorded in Hickory Hill Subdivision No7, Volume 41, Page 2 of Plat Records, bounded and described as follows;

BEGINNING at a point in the westerly line of Washington Avenue being the most southerly corner of Block "B". THENCE North 1°14'20" West along the westerly line of Washington Avenue, a distance of 116.61 feet to a point. THENCE South 89°46'15" West, a distance of 74.59 feet to a point in the northeasterly line of lands conveyed to Nearl G. and Rheba Flowers as recorded in Volume 850, Page 133 of Deed Records. THENCE South 33°33'00" East along Flowers' northeasterly line, a distance of 139.53 feet to the place of beginning, embracing 0.10 acre of land, but being subject to all legal highways.

1/10th acre, FLOWERS TO TOWNER:

SITUATED in the City of Lorain, County of Lorain and State of Ohio. Being known as part of Original Black River Township Lot 7 in Tract 1, bounded and described as follows; BEGINNING at the southwest corner of Block "B" of Hickory Hill Subdivision No. 7 as recorded in Volume 41, Page 2 of Plat Records, being also the northwest corner of the Grantee. THENCE North 83°01'10" East along a south line of Block "B", a distance of 80.00 feet to a point. THENCE South 33°33'00" East along the northeasterly line of the Grantee, a distance of 58.59 feet to a point. THENCE South 89°46'15" West, a distance of 111.37 feet to a westerly corner of the Grantee. THENCE North 0°36'00" West, a distance of 39.55 feet to the place of beginning, embracing 0.10 acre of land, but being subject to all legal highways.

NEW DESCRIPTION, BLOCK "B":

SITUATED in the City of Lorain, County of Lorain and State of Ohio. Being known as part of Block "B" of Hickory Hill Subdivision No.7 and part of Original Black River Township Lot 7 in Tract 2. hounded and described as follows:

BEGINNING at the northeast corner of Block"B" as recorded in Hickory Hill Subdivision No.7, Volume 41, Page 2 of Plat Records. THENCE South 88°45'40" West along the north line of Block "B", a distance of 184.19 feet to the northwest corner thereof. THENCE South 1°04'46" West, a distance of 32.20 feet to a point. THENCE South 0°36'00" East, a distance of 39.55 feet to a point. THENCE North 89°46'15" East, a distance of 185.96 feet to the place of beginning, embracing 0.312 acre of land, but being subject to all legal highways.

NEW DESCRIPTION, FLOWERS:

SITUATED in the City of Lorain, County of Lorain and State of Ohio. Being known as part of Block "B" of Hickory Hill Subdivision No. 7 and part of Original Black River Township

Lot 7 in Tract 1, bounded and described as follows;

BEGINNING at the most southerly corner of Block "B" of Hickory Hill Subdivision No. 7 as recorded in Vloume 41, Page 2 of Lorain County Plat Records, said corner being in the westerly line of Washington Avenue. THENCE North 1°14'20" West along said westerly line. a distance of 116.61 feet to a point. THENCE South 89°46'15" West, a distance of Washington Avenue, a distance of 185.96 feet to a point. THENCE South 35°09'30" East, a distance of 485.62 feet to the centerline of North Ridge Road. THENCE North 49°37'00" East along the centerline of NOrth Ridge Road, a distance of 80.00 feet to a point. THENCE North *33°33'00" West along a westerly line of Washington Avenue, a distance of 275.20 feet to the place of beginning, embracing 0.986 acre of land, but being subject to all legal highways.

IN SELLAH CHAMBERLAIN TRS. ALLOT. P.V. Z P. 11 F.B. REF. 120 F. ST F.B. REF. 120 F. ST F.B. REF. 120 F. ST 4VMCIY026 125 yds 72d - 15K 20t D. 0 K N 8591-18 ON 901 DWN. by RGS Chkd County of LORAIN Date NON 1987 Ser 10 egolliy G. ¢ 5. CORP. CILY OF LORAIN 219 COURT ST. ELYRIA, OHIO 44035 CONSULTING ENGINEERS & SURVEYORS CONSULTING ENGINEERS & SURVEYORS

MICHAEL G. HURA REGISTERED SURVEYOR #12706 - R.D. 2 MASON RD. - VERMILION, OHIO 44089 - PHONE 965-4040

San A

1/10th ACRE, TOWNER TO FLOWERS: SITUATED in the City of Lorain, County of Lorain and State of Ohio. Being known as part of Block "B" as recorded in Hickory Hill Subdivision No7, Volume 41, Page 2 of Plat Records, bounded and described as follows:

BEGINNING at a point in the westerly line of Washington Avenue being the most southerly corner of Block "B". THENCE North 1°14'20" West along the westerly line of Washington Avenue, a distance of 116.61 feet to a point. THENCE South 89°46'15" West. a distance of 74.59 feet to a point in the northeasterly line of lands conveved to Nearl G. and Rheba Flowers as recorded in Volume 850, Page 133 of Deed Records. THENCE South 33°33'00" East along Flowers' northeasterly line, a distance of 139.53 feet to the place of beginning, embracing 0.10 acre of land, but being subject to all legal highways.

1/10th acre, FLOWERS TO TOWNER:

SITUATED in the City of Lorain, County of Lorain and State of Ohio. Being known as part of Original Black River Township Lot 7 in Tract 1, bounded and described as follows; BEGINNING at the southwest corner of Block "B" of Hickory Hill Subdivision No. 7 as recorded in Volume 41, Page 2 of Plat Records, being also the northwest corner of the Grantee. THENCE North 83°01'10" East along a south line of Block "B", a distance of 80.00 feet to a point. THENCE South 33°33'00" East along the northeasterly line of the Grantee, a distance of 58.59 feet to a point. THENCE South 89°46'15" West, a distance of 111.37 feet to a westerly corner of the Grantee. THENCE North 0°36'00" West, a distance of 39.55 feet to the place of beginning, embracing 0.10 acre of land, but being subject to all legal highways.

NEW DESCRIPTION. BLOCK "B":


SITUATED in the City of Lorain, County of Lorain and State of Ohio. Being known as part of Block "B" of Hickory Hill Subdivision No.7 and part of Original Black River Township Lot 7 in Tract 2, bounded and described as follows:


BEGINNING at the northeast corner of Block"B" as recorded in Hickory Hill Subdivision No.7, Volume 41, Page 2 of Plat Records. THENCE South 88°45'40" West along the north line of Block "B", a distance of 184.19 feet to the northwest corner thereof. THENCE South 1°04'46" West, a distance of 32.20 feet to a point. THENCE South 0°36'00" East, a distance of 39.55 feet to a point. THENCE North 89°46'15" East, a distance of 185.96 feet to the place of beginning, embracing 0.312 acre of land, but being subject to all legal highways.

NEW DESCRIPTION, FLOWERS:

SITUATED in the City of Lorain, County of Lorain and State of Ohio. Being known as part of Block "B" of Hickory Hill Subdivision No. 7 and part of Original Black River Township Lot 7 in Tract !, bounded and described as follows:


BEGINNING at the most southerly corner of Block "B" of Hickory Hill Subdivision No. 7 as recorded in Vloume 41, Page 2 of Lorain County Plat Records, said corner being in the westerly line of Washington Avenue. THENCE North 1°14'20" West along said westerly line, a distance of 116.61 feet to a point. THENCE South 89°46'15" West, a distance of Washington Avenue, a distance of 185.96 feet to a point. THENCE South 35°09'30" East, a distance of 485.62 feet to the centerline of North Ridge Road. THENCE North 49°37'00" East along the centerline of North Ridge Road, a distance of 80.00 feet to a point. THENCE North *33°33'00" West along a westerly line of Washington Avenue, a distance of 275.20 feet to the place of beginning, embracing 0.985 acre of land, but being subject to all legal highways.

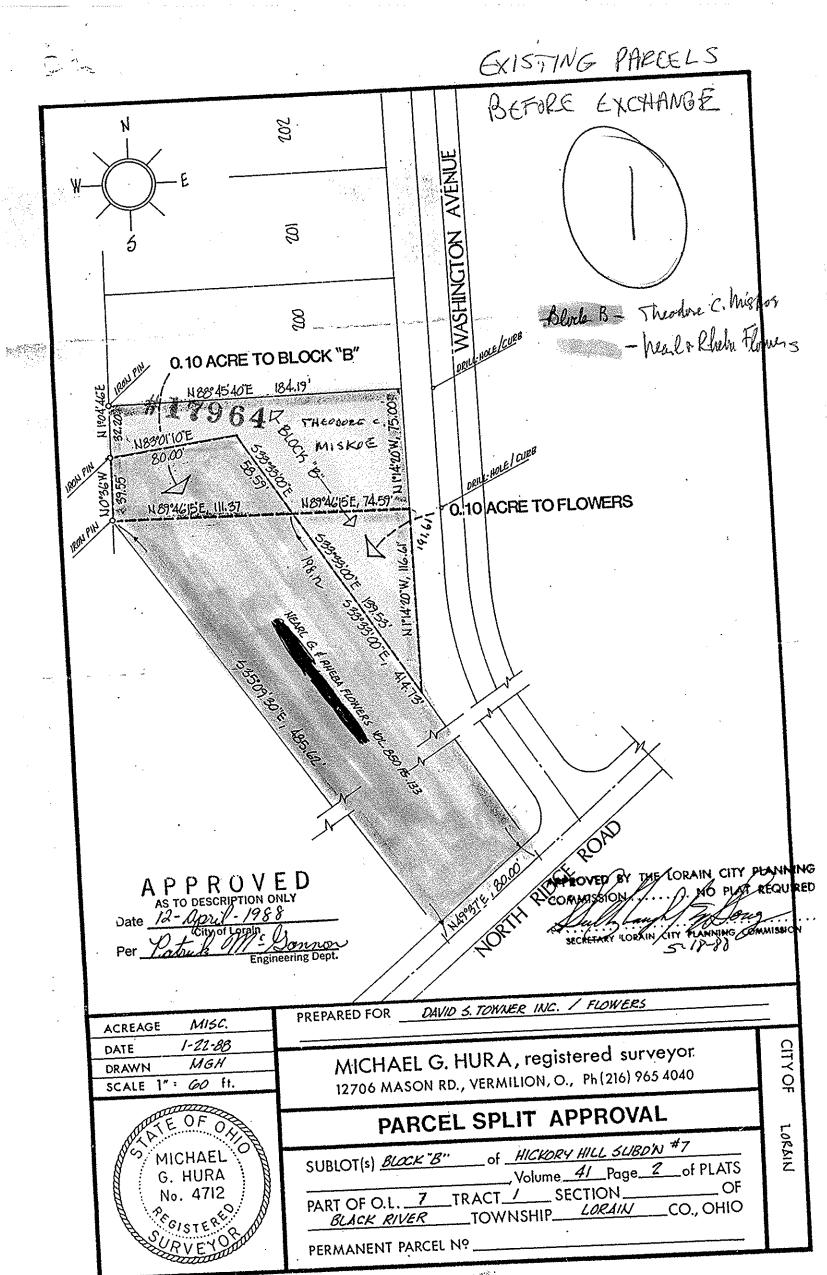

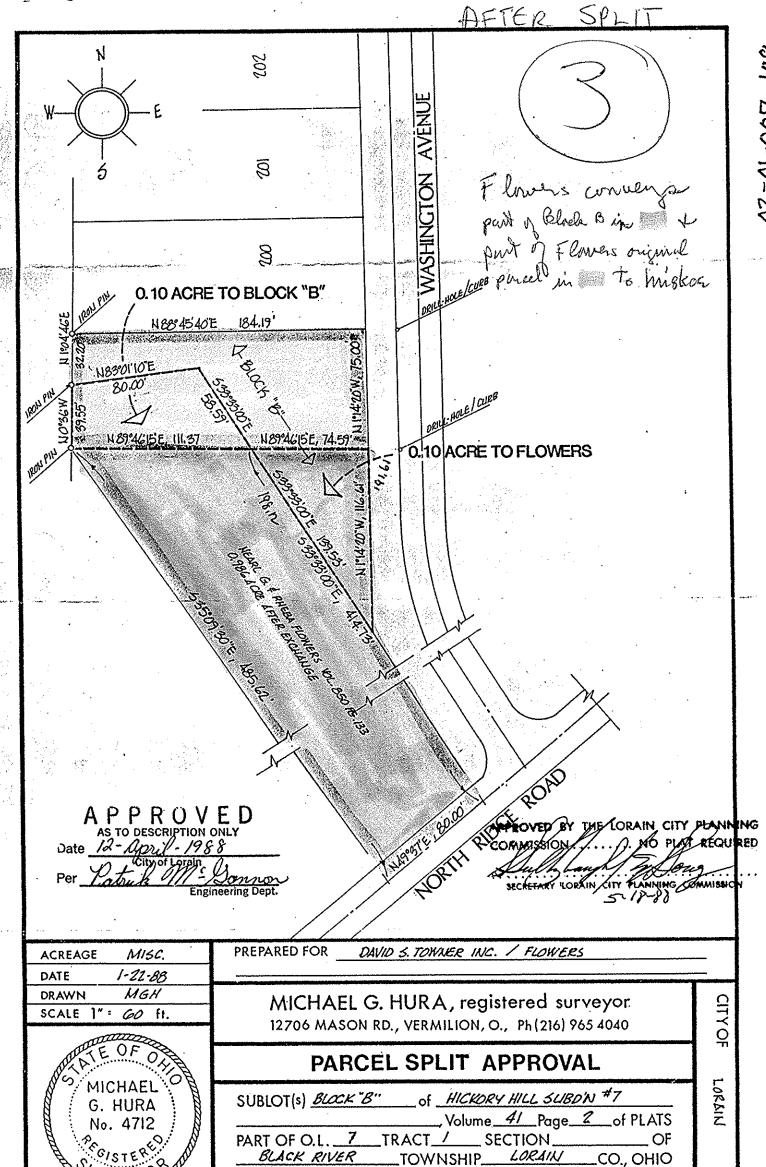

PERMANENT PARCEL Nº

WEW PARCELS

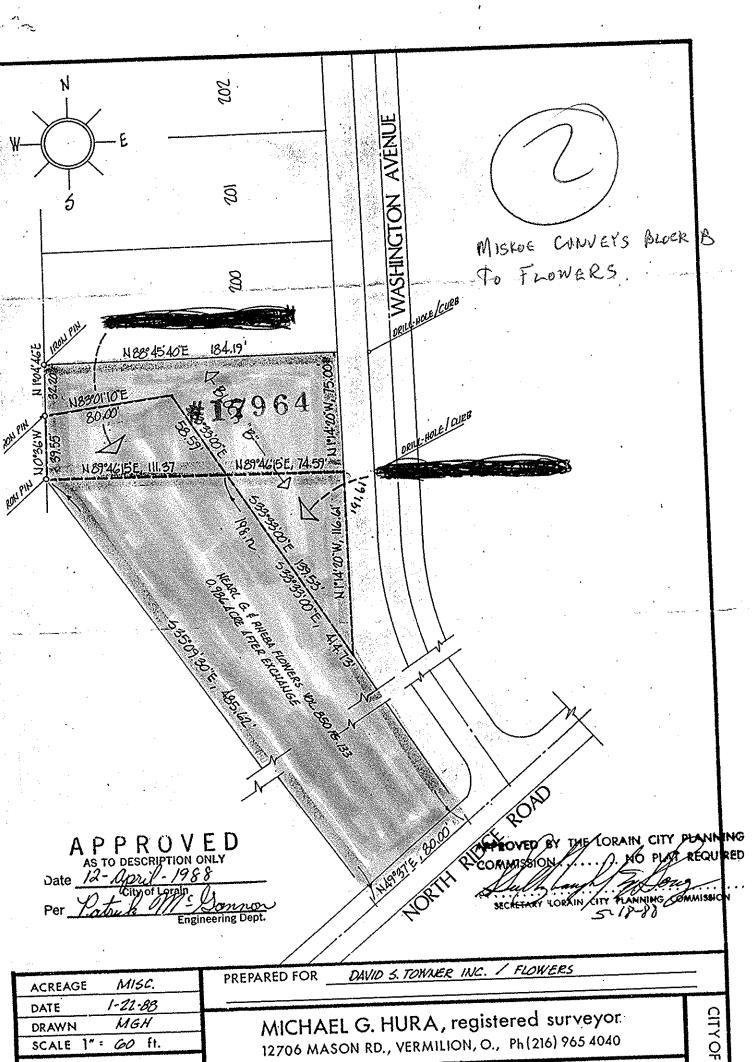

8 : No. 4/12 : 8 7 TRACT / SECTION	DRAWN MGH SCALE 1": GO ft.	MICHAEL G. HURA, registered surveyor. 12706 MASON RD., VERMILION, O., Ph (216) 965 4040
No. 4712 Volume 47 rage	E OF OU	PARCEL SPLIT APPROVAL
PERMANENT PARCEL NO.	G. HURA No. 4712	PART OF O.L. 7 TRACT / SECTION OF BLACK RIVER TOWNSHIP LORAIN CO., OHIO

WARRANTY DEED-No. 102A

Chat. NEARL G. FLOWERS and RHEBA FLOWERS, Husband and Wife,

, the Grantors who claim title by or through instrument , recorded in Volume County Recorder's Office, for the consideration of Ten and 00/100----------Dollars (\$ 10.00 received to our full satisfaction of THEODORE C. MISKOE

the Grantee whose TAX MAILING ADDRESS will be P.O. Box 402, Lorain, Ohio 44052

Give. Grant. Bargain. Sell and Couvey unto the said Grantee, his heirs and assigns, the following described premises, situated in the City Lorain and State of Ohio: , County of Lorain

Situated in the City of Lorain, County of Lorain and State of Ohio. Being known as part of Block "B" of Hickory Hill Subdivision No. 7 and part of Original Black River Township Lot 7 in Tract 2, bounded and described as follows:

Beginning at the northeast corner of Block "B" as recorded in Beginning at the northeast corner of Block B as recorded in Hickory Hill Subdivision No. 7, Volume 41, Page 2 of Plat Records. Thence South 88° 45' 40" West along the north line of Block "B", a distance of 184.19 feet to the northwest corner thereof. Thence south 1° 04' 46" West, a distance of 32.20 feet to a point. Thence South 0° 36' 00" East, a distance of 39.55 feet to a point. Thence North 89° 46' 15" East, a distance of 185.96 feet to the West line of Washington Avenue. Thence North 1° 14' 20" West along the OF Washington Avenue. Thence North 1, 14, 20, West along the West line of Washington Avenue a distance of 75.00 feet to the place of beginning, embracing 0.312 acres of land, but being subject to all legal highways.

APPROVED BY THE LORAIN CITY PLANNING

AS TO DESCRIPTION ONLY

be the same more or less, but subject to all legal highways.

WARRANTY DEED-No. 102A The Ohio Legal Blank Co, Cleveland Publishers and Dealers Since 1883

THEODORE C. MISKOE, Married

, the Grantor who claim title by or through instrument, recorded in Volume , Page County Recorder's Office, for the consideration of Ten and 00/100----______ Dollars (\$ 10.00 full satisfaction of NEARL G. FLOWERS and RHEBA FLOWERS,

the Grantees. whose TAX MAILING ADDRESS will be 866 North Ridge Road West Lorain, Ohio

Give, Grant, Bargain, Sell and Convey unto the said Grantees, their heirs and assigns, the following described premises, situated in the City Lorain , County of Lorain and State of Ohio:

Situated in the City of Lorain, County of Lorain and State of Ohio, and being known as all of Block "B" as recorded in Hickory Hills Subdivsiion No. 7, in Volume 41, Page 2 of Lorain County Plat Records.

be the same more or less, but subject to all legal highways.