10-108

J-D1-007-B

02-01-007-102

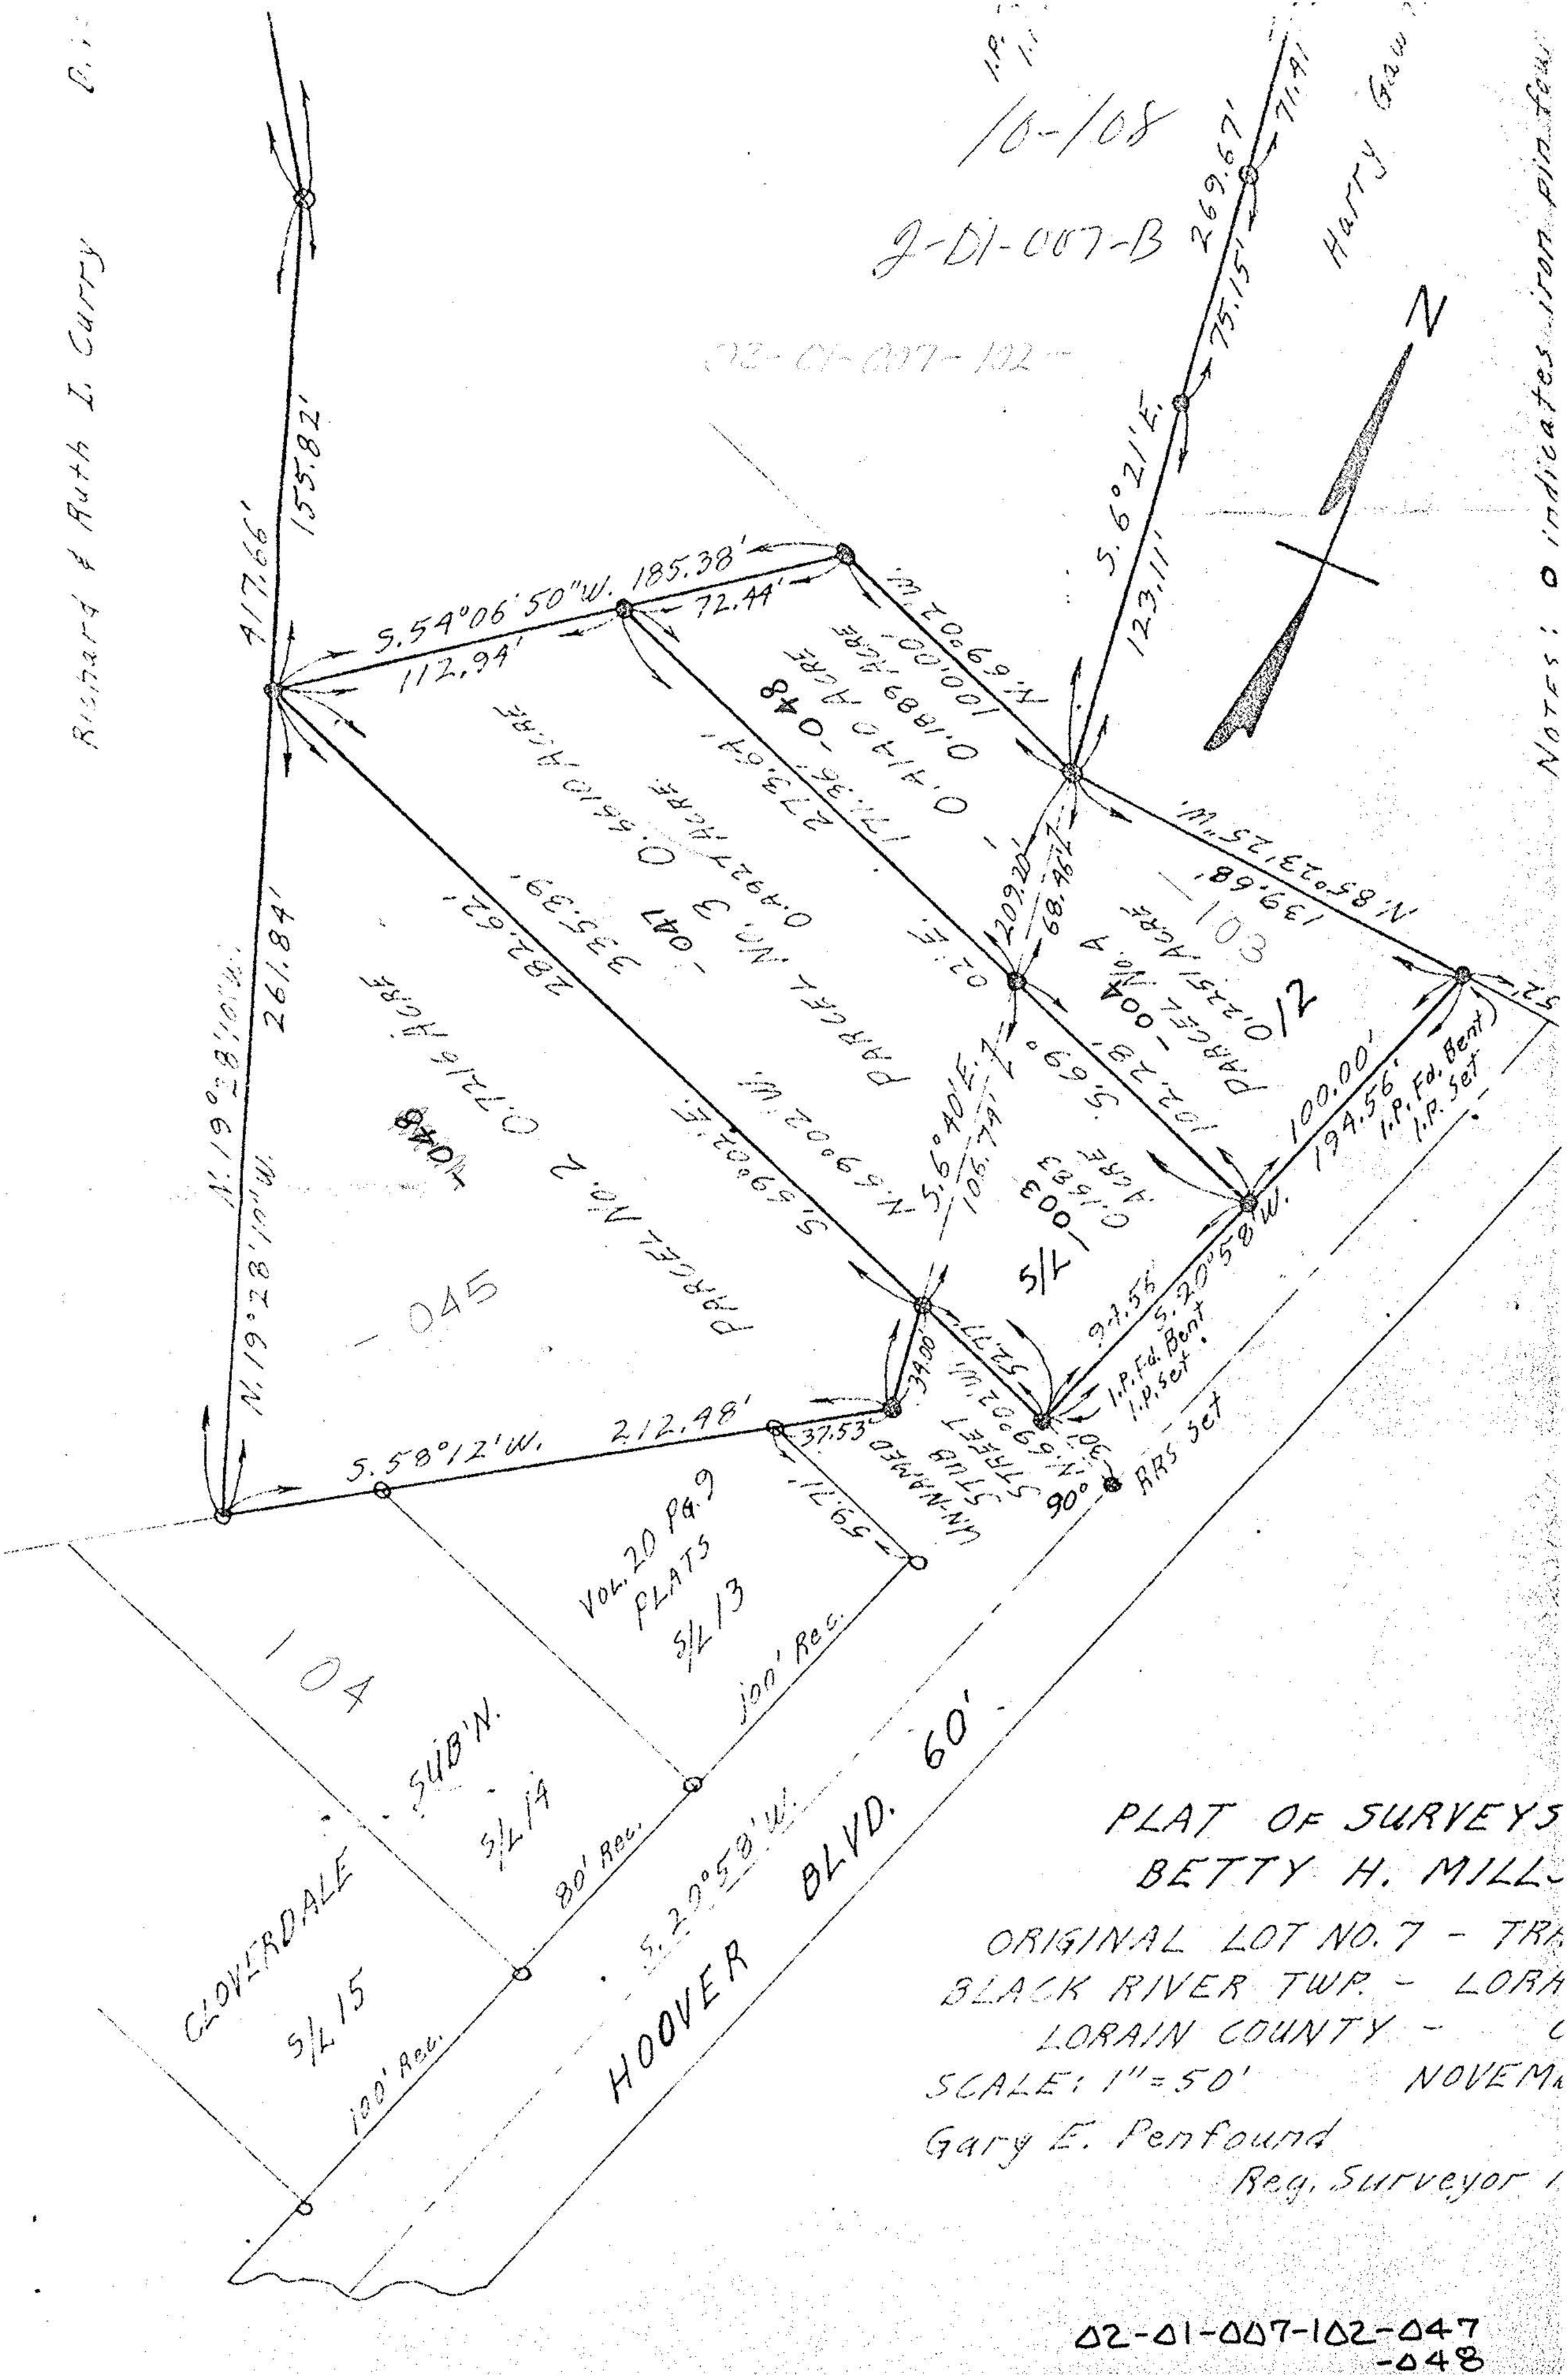

PLAT OF SURVEYS
BETTY H. MILL
ORIGINAL LOT NO. 7 - TR
BLACK RIVER TWP. - LORA
LORAIN COUNTY - O
SCALE: 1" = 50' NOVEM
Gary E. Penfound
Reg. Surveyor

02-01-007-102-047
-048