SURVEY OF

PART OF BLACK RIVER TOWNSHIP

ORIGINAL LOT Nº 7

TRACT Nº 1

CITY OF LORAIN COUNTY OF LORAIN STATE OF OHIO

SCALE : 1" = 60 SURVEY 1" = 20' LOCATION DETAIL

AUGUST 4, 1967

BY

RAY E. HOLLIS
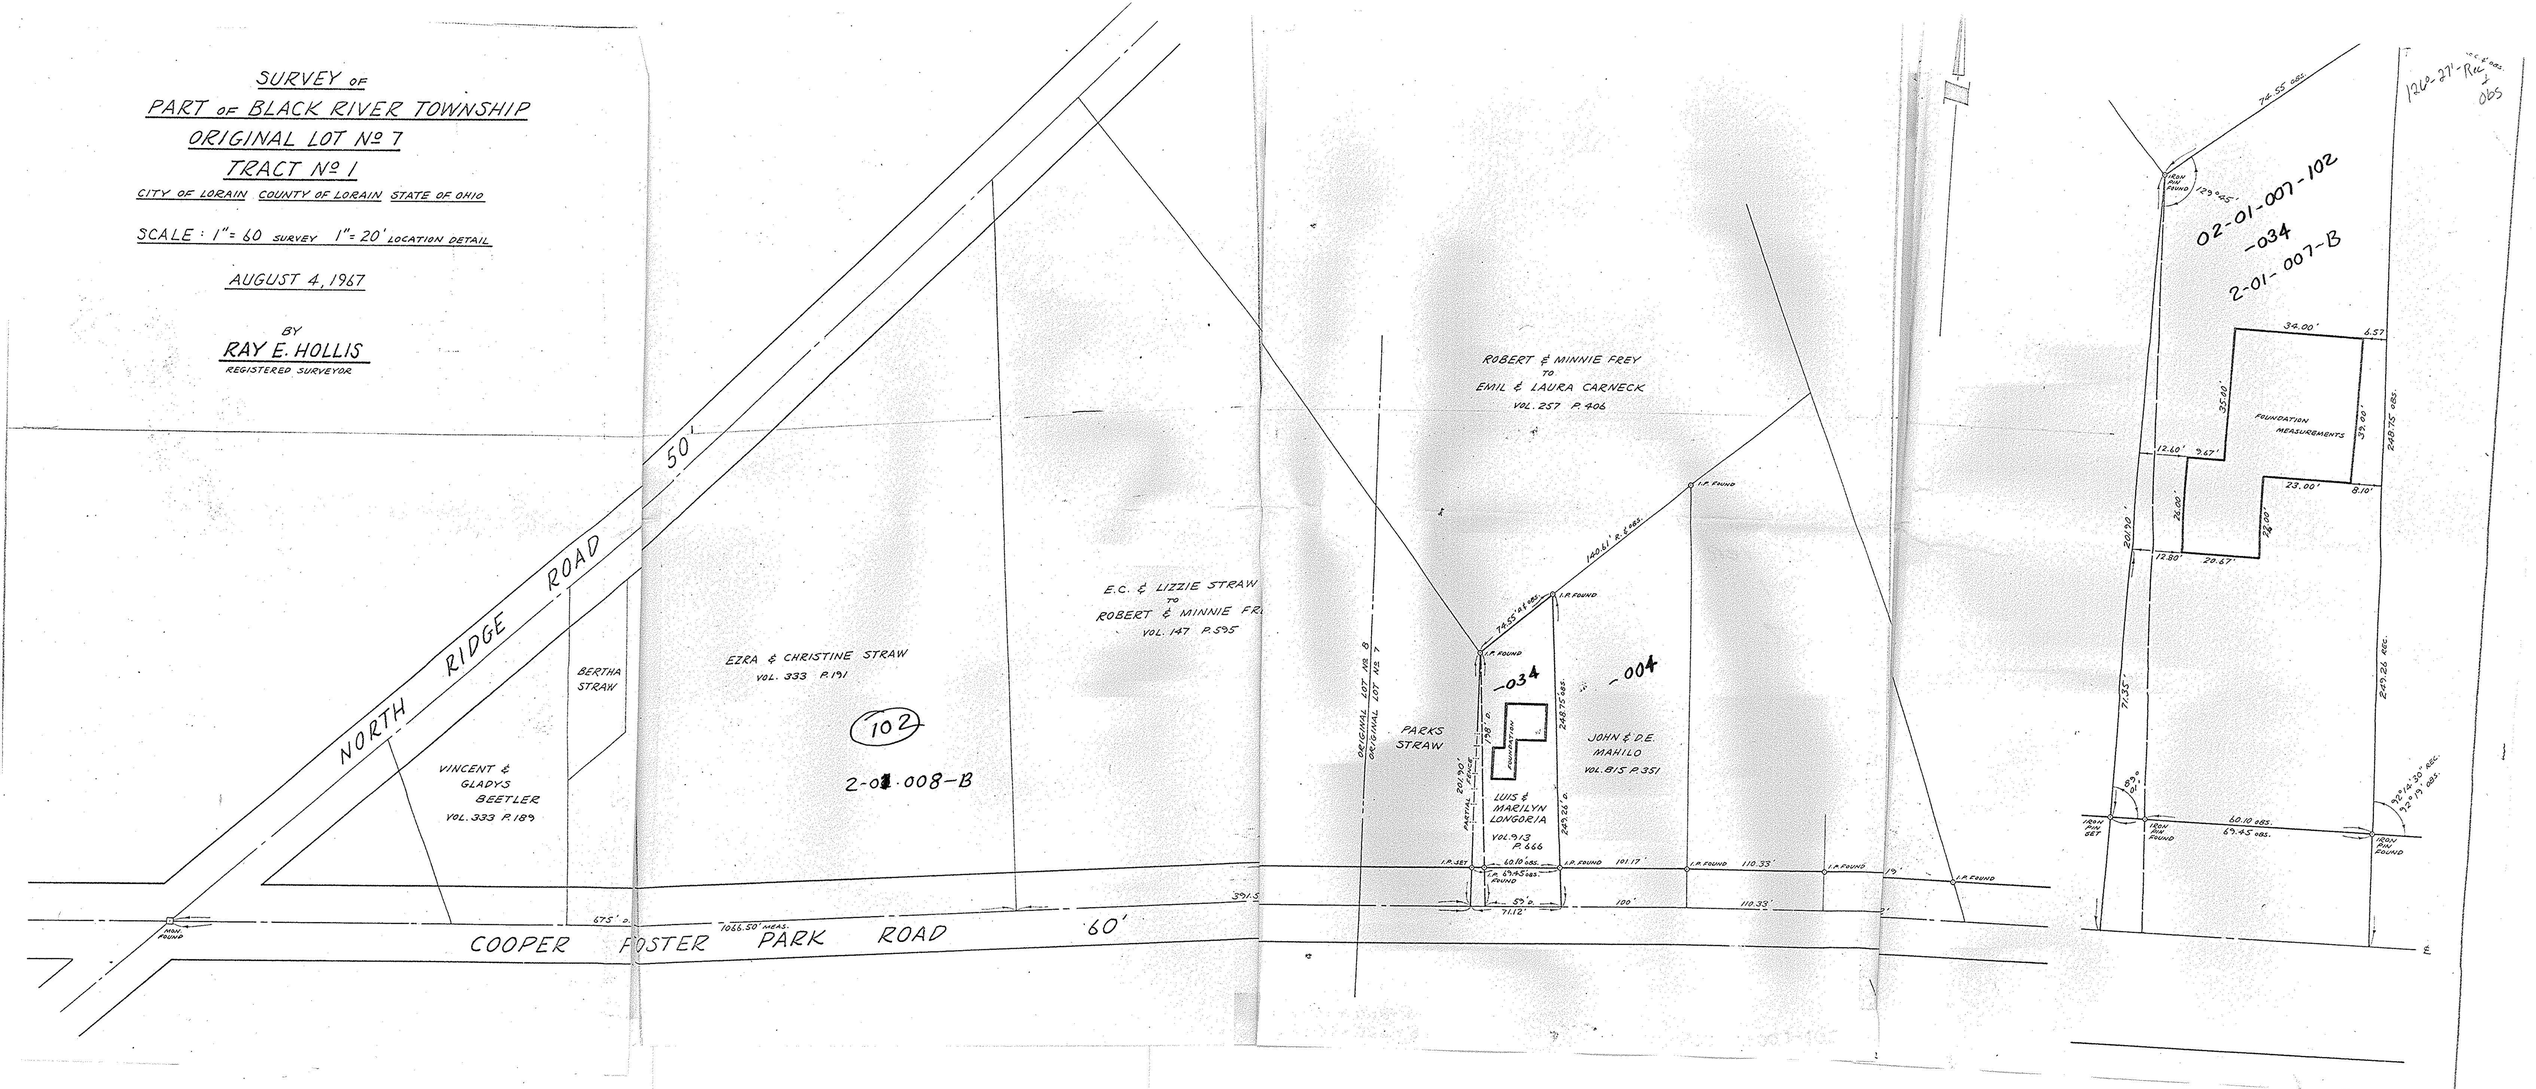
REGISTERED SURVEYOR