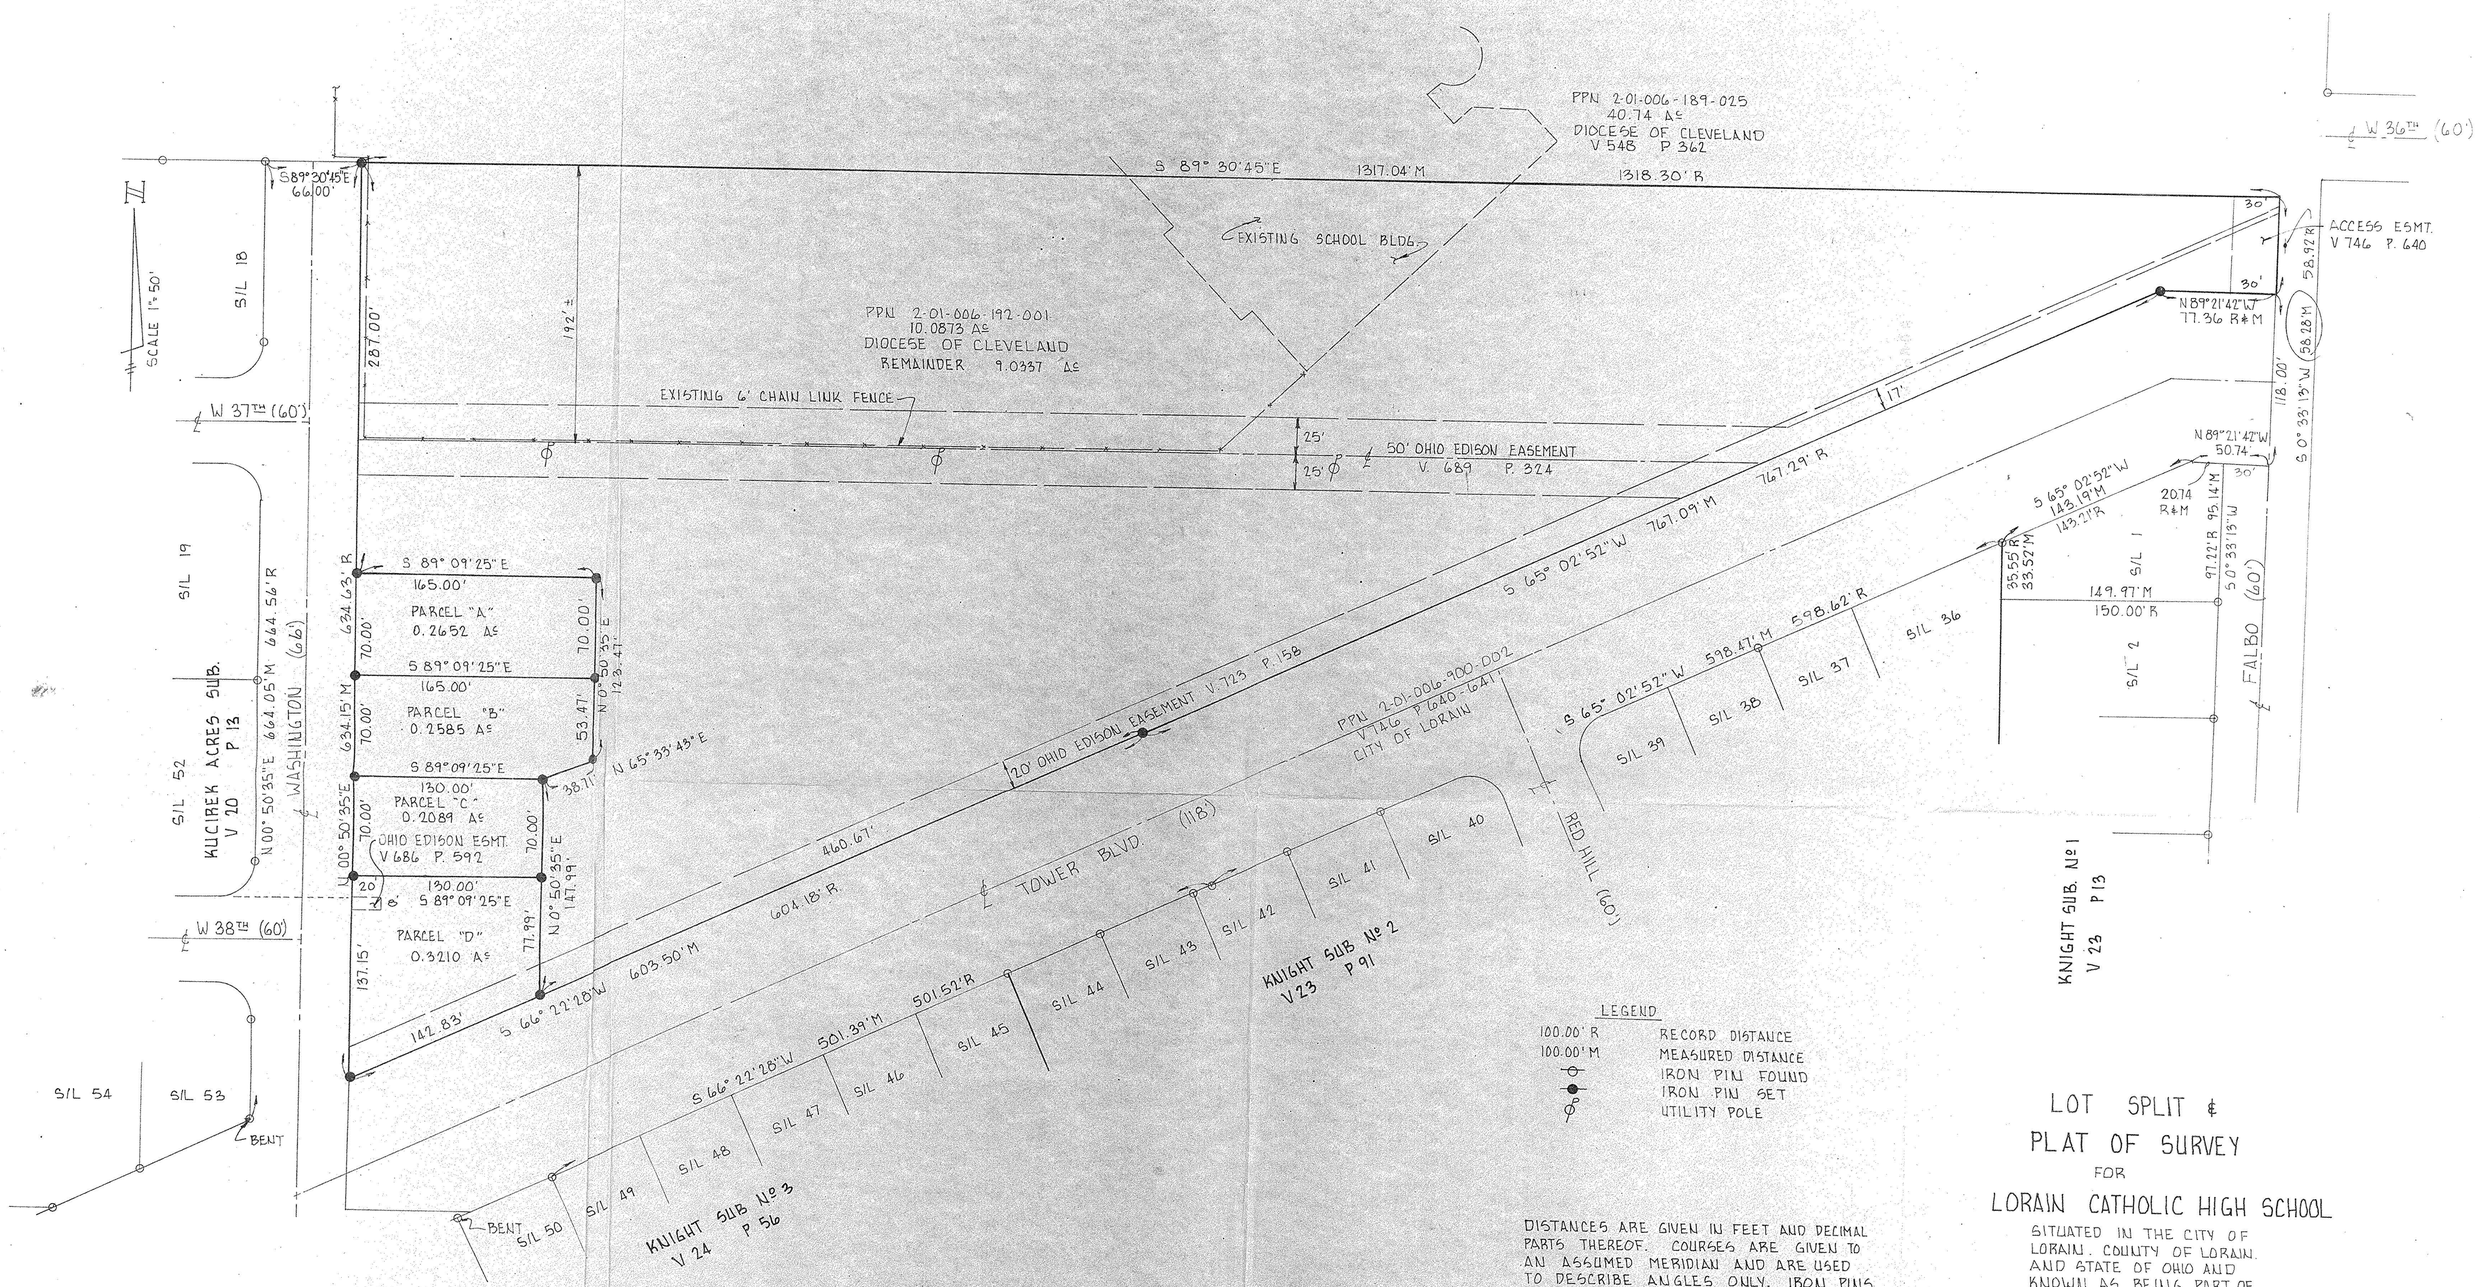

LEGEND

100.00' R	RECORD DISTANCE
100.00' M	MEASURED DISTANCE
	IRON PIN FOUND
	IRON PIN SET
	UTILITY POLE

DISTANCES ARE GIVEN IN FEET AND DECIMAL PARTS THEREOF. COURSES ARE GIVEN TO AN ASSUMED MERIDIAN AND ARE USED TO DESCRIBE ANGLES ONLY. IRON PINS WERE SET AT ALL POINTS INDICATED THUSLY —●— UNLESS NOTED OTHERWISE, ALL OF WHICH I CERTIFY TO BE CORRECT TO THE BEST OF MY PROFESSIONAL KNOWLEDGE, INFORMATION AND BELIEF.

Richard Rosebeck

RICHARD ROSEBECK PE, PS
SURVEYOR Nº 7400

STATE OF OHIO
RICHARD A. ROSEBECK
7400
REGISTERED
PROFESSIONAL SURVEYOR

LOT SPLIT & PLAT OF SURVEY

FOR

LORAIN CATHOLIC HIGH SCHOOL

SITUATED IN THE CITY OF LORAIN, COUNTY OF LORAIN, AND STATE OF OHIO AND KNOWN AS BEING PART OF ORIGINAL BLACK RIVER TOWNSHIP LOT Nº 6, TRACT Nº 1
PPN 2-01-006-192-001

19906

APPROVED
LORAIN CO.
MAP DEPT.
DATE 5-13-92
PAGE 01-006-H
BY GORDON FRANCIS
WHO NOTICE # 19906

Δ2-01-006-192-001