

HAPONEK & ASSOCIATES, INC. Engineers & Surveyors

100 Center Ridge Road • NORTH RIDGEVILLE, OHIO 44039 • (216) 327-4776 • Lorain 288-4400

SURVEY OF SUBLOTS 17, 18, 14 & VACATED ALLEY

IN
J.B. HOGES ADDN.

CITY OF LORAIN


COUNTY OF LORAIN

STATE OF OHIO

PREPARED FOR:

ROGER MILLARD
1116 W. 17th ST.
LORAIN, OH.
244-1150

DATE: FEB. 1998
SCALE: 1" = 40'

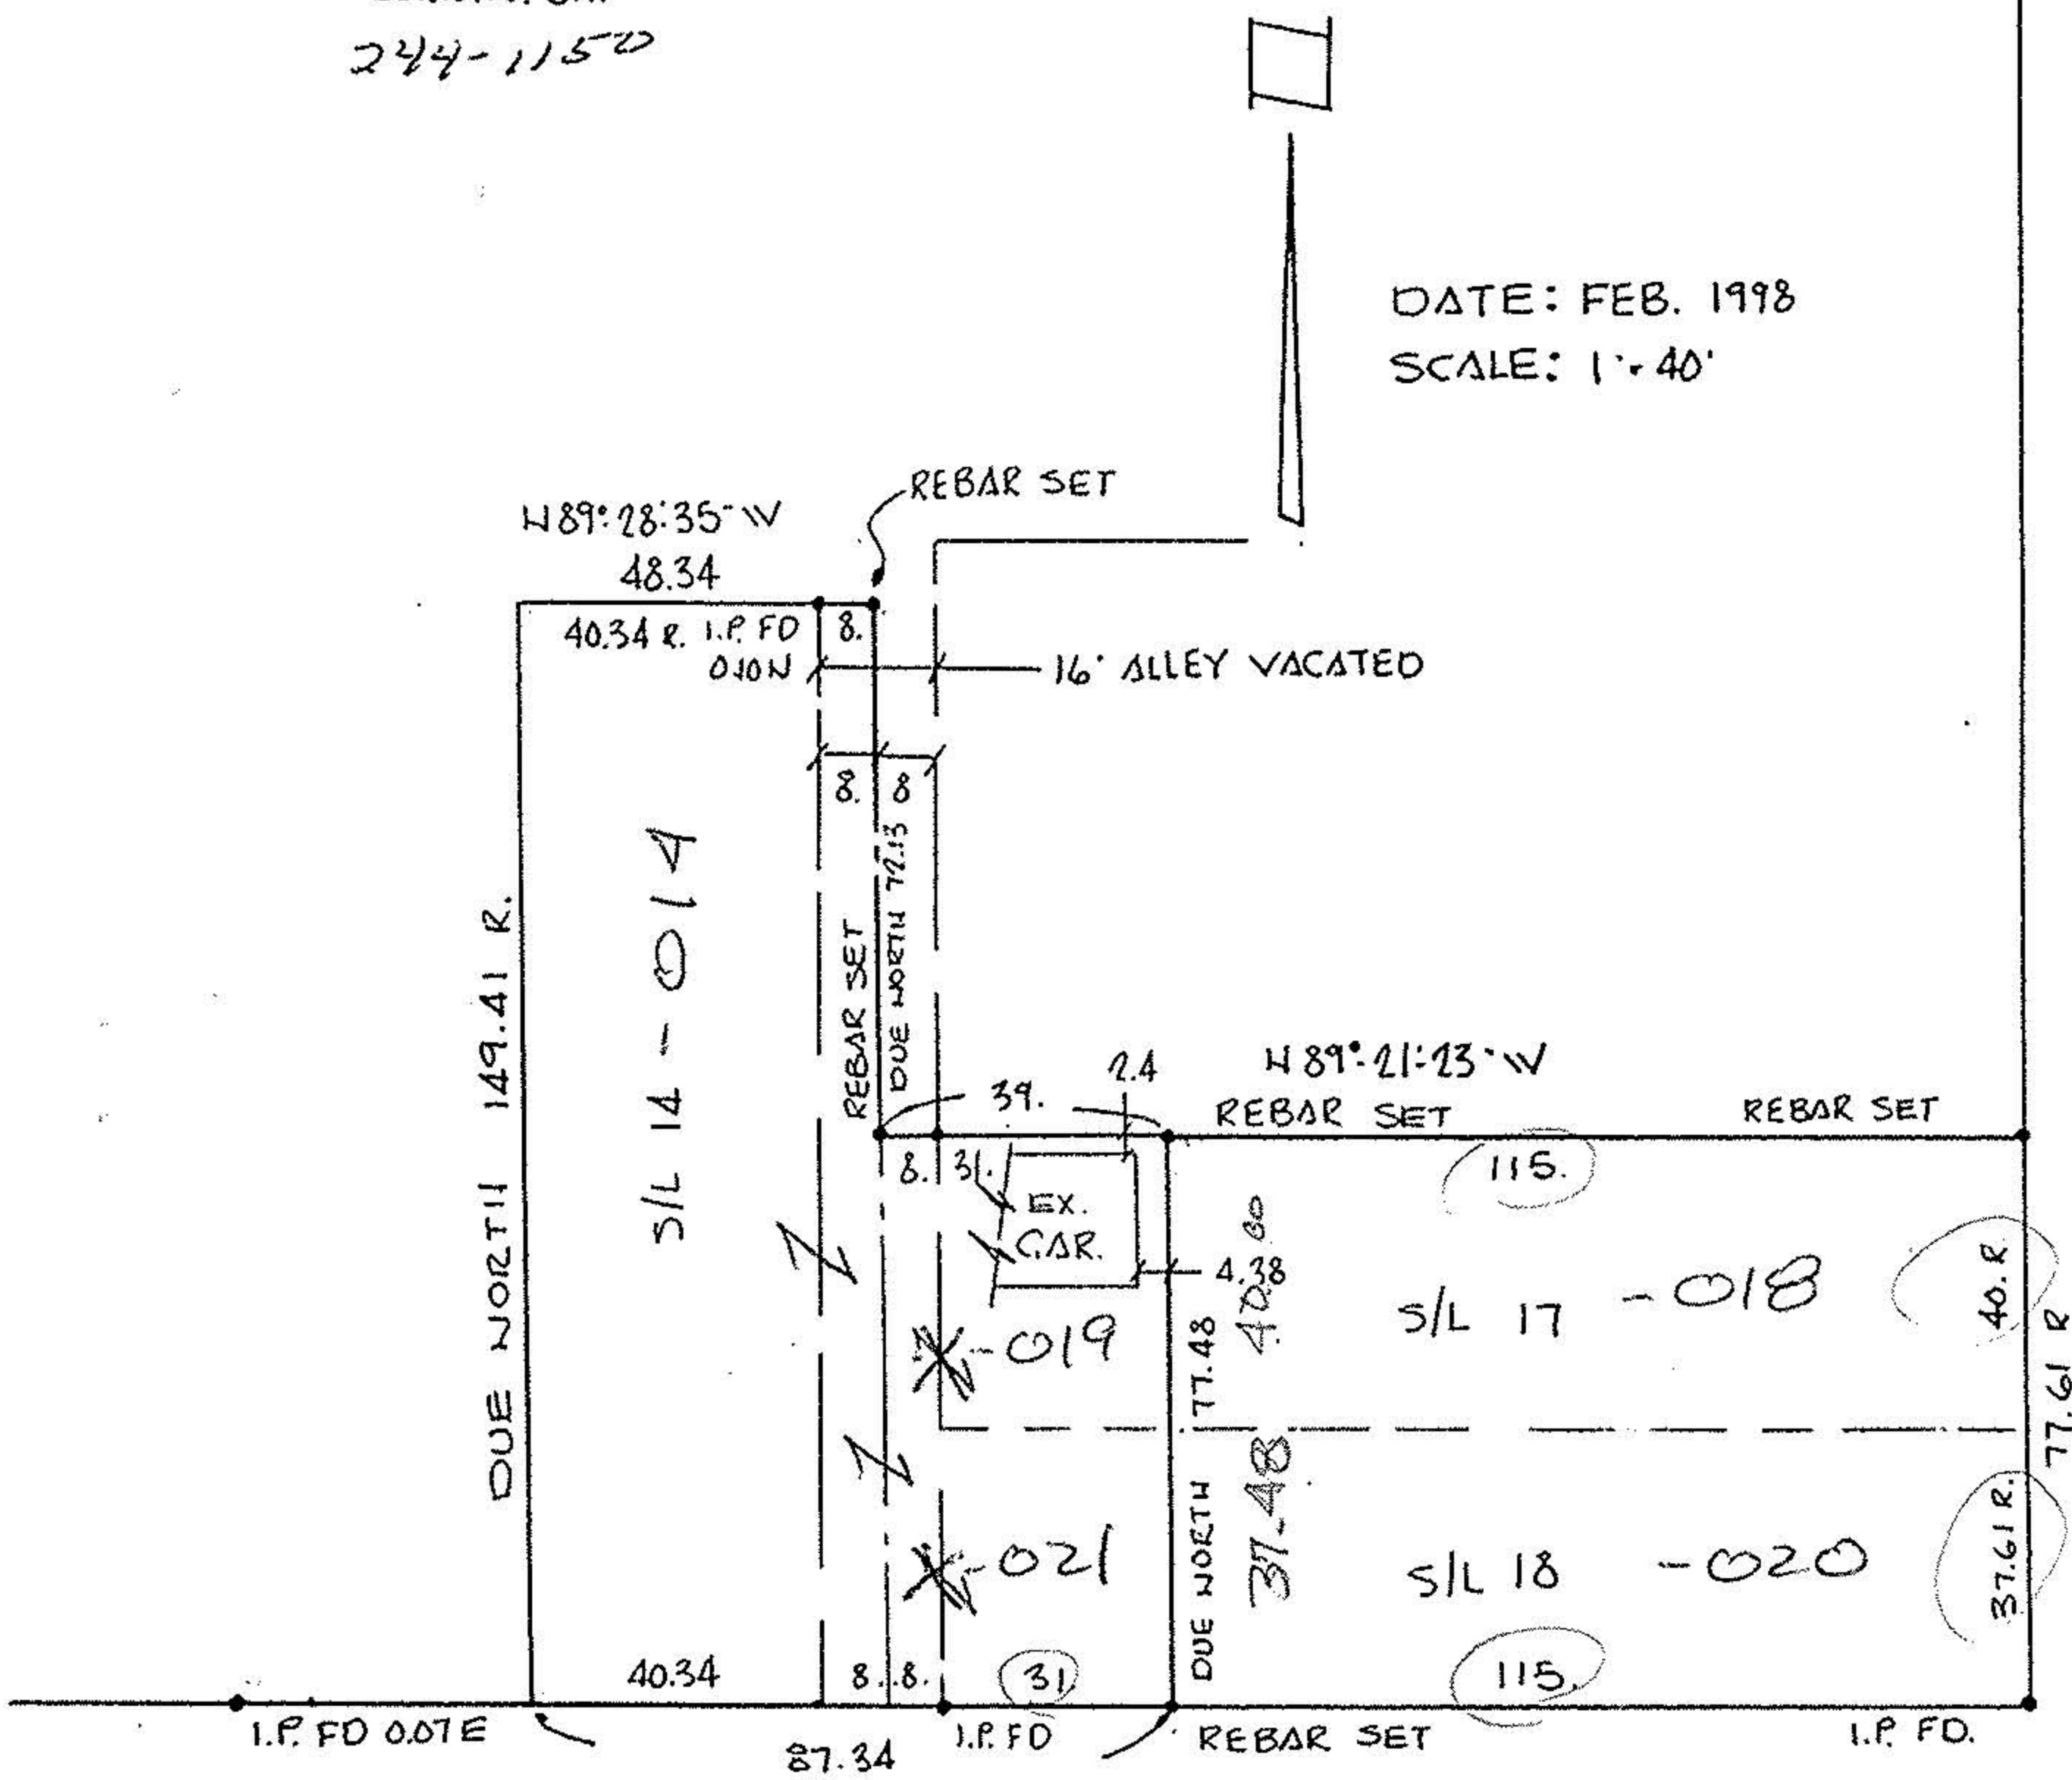

HAMILTON 60' AVE.
DUE NORTH

02-01-006-131-018 thru -020

APPROVED BY THE LORAIN CITY PLANNING COMMISSION..... NO PLAT REQUIRED
William E. Dobis 4-2-98
SECRETARY LORAIN CITY PLANNING COMMISSION

WEST 17th ST. 60'

APPROVED
AS TO DESCRIPTION ONLY
Date March 20 1998
City of Lorain
Per Kimberly Hoskin
Engineering Dept.



#22540

APPROVED LORAIN CO. MAP DEPT.	
DATE	6/2/98
PAGE	2-01-006-0
BY	TJS
NO.	22540