LAUNDON • SIMON • CAHL & ASSOC., INC.
PROFESSIONAL LAND SURVEYORS
110 MIDDLE AVE., ELYRIA, O. 44035

SURVEY FOR:
# DUANE I. FLANDERS
PT. of S/L 28 SKYLINE PARK SUB'N. 3 P.V. 23 P. 71
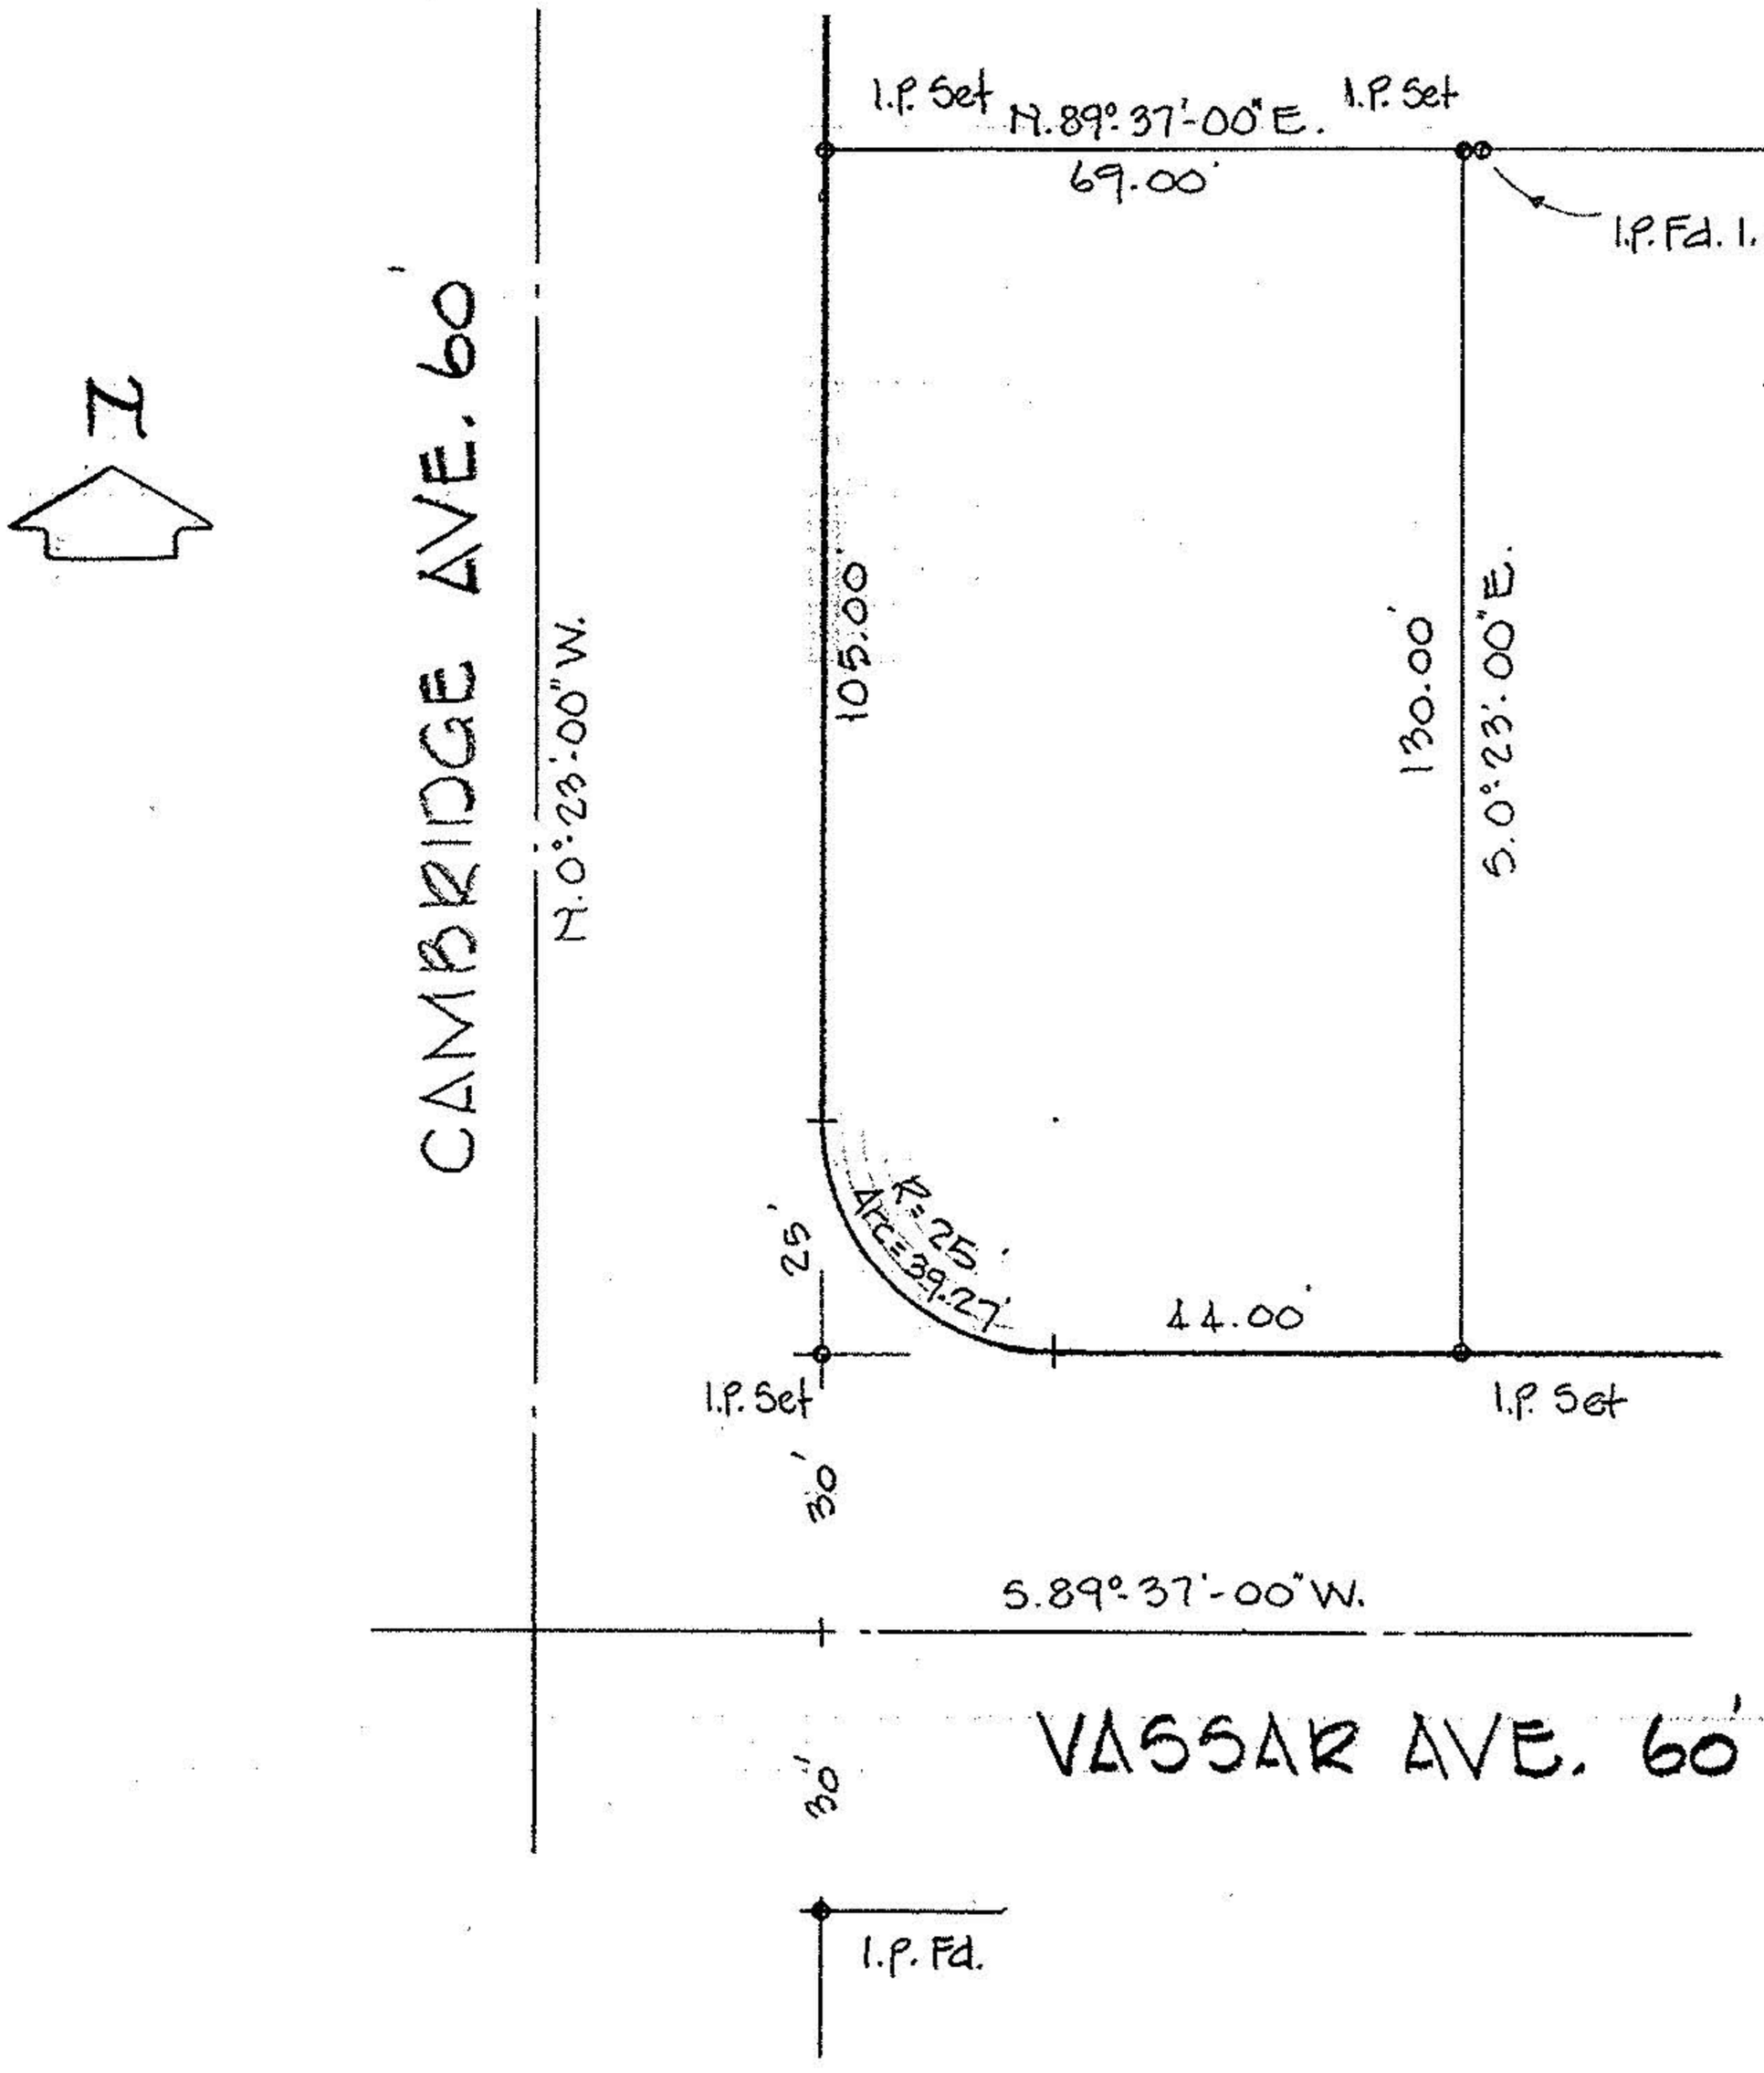
| | | |
|---|---|---|
| Orig. Lot No. 2 | City of LORAIN | Date 3-21-97 Scale 1" = 30' |
| Orig. Sec No. | Village of | Dwn. by R.G.S. Chkd. by R.C. |
| Tract 2 | County of LORAIN | Job No. 97-2939 F.B. 240/52 |
| Township of BLACK RIVER | State of Ohio | Printed |