


ARNOLD F. KOEPP
 REGISTERED SURVEYOR
 629 BRENNAN DRIVE
 AMHERST, OHIO 44001
 (216) 984-2158

Scale 1"=200'


PART of lot 1 TRACT 2 former
 BLACK RIVER TWP NOW City of Amherst
 MAP of Parcel of LAND -
 To Be conveyed 2.167 AC ±
 Sept. 24-1993

SKETCH BY Arnold F. Koepf
 Reg. Surveyor No. 4206

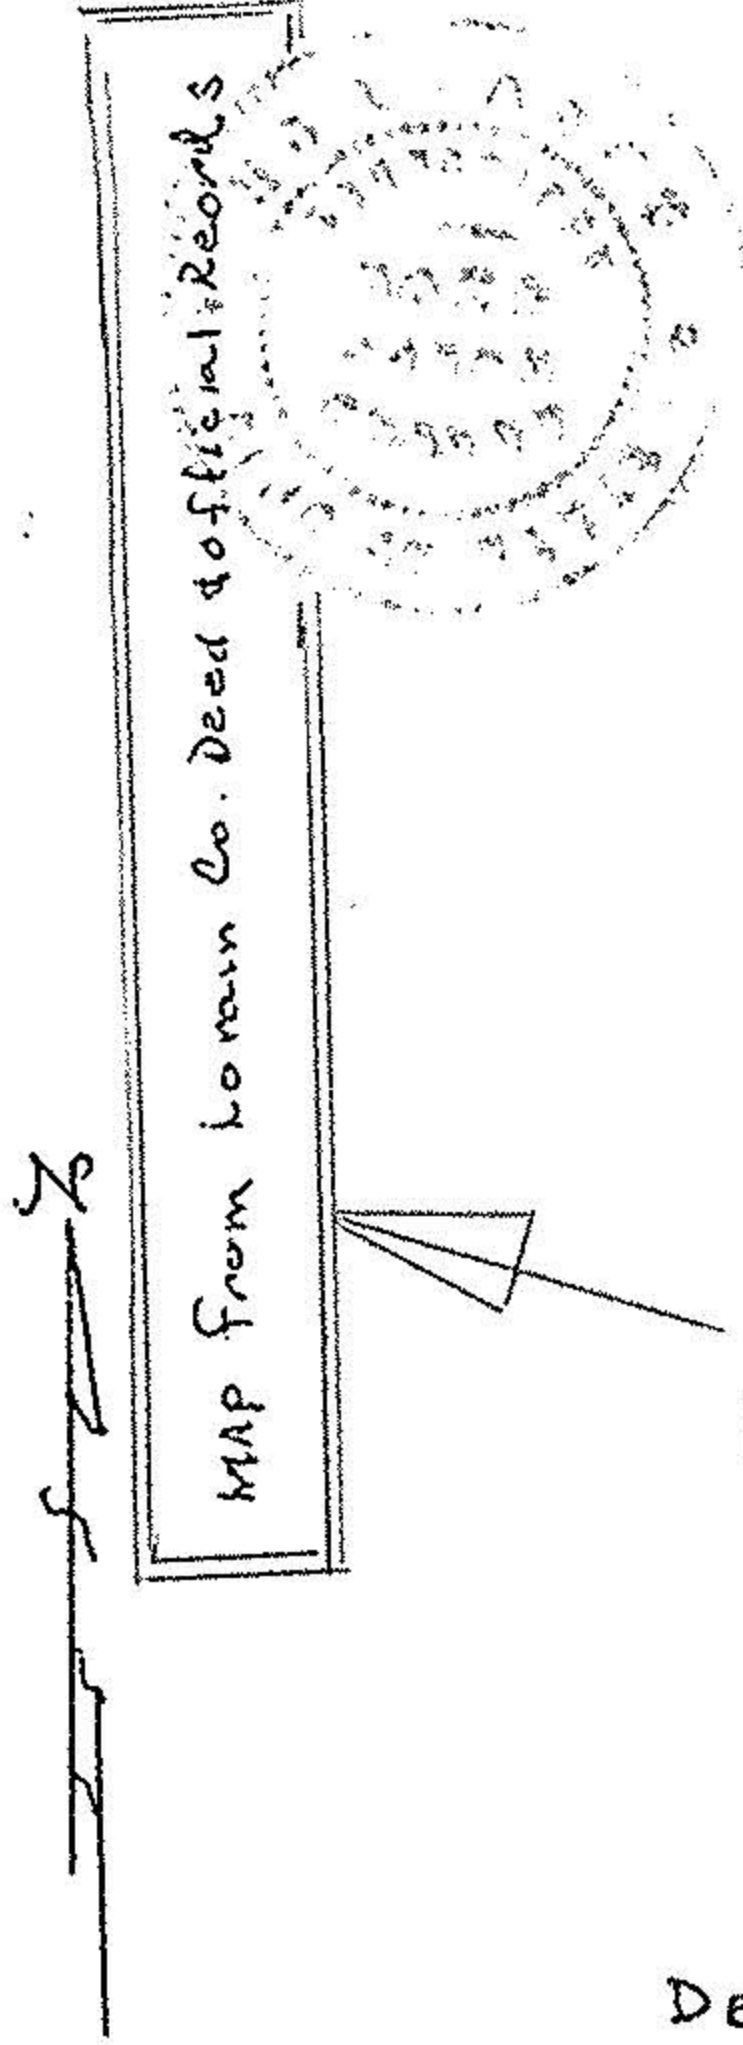

NOTE

NO PLEAS
 N

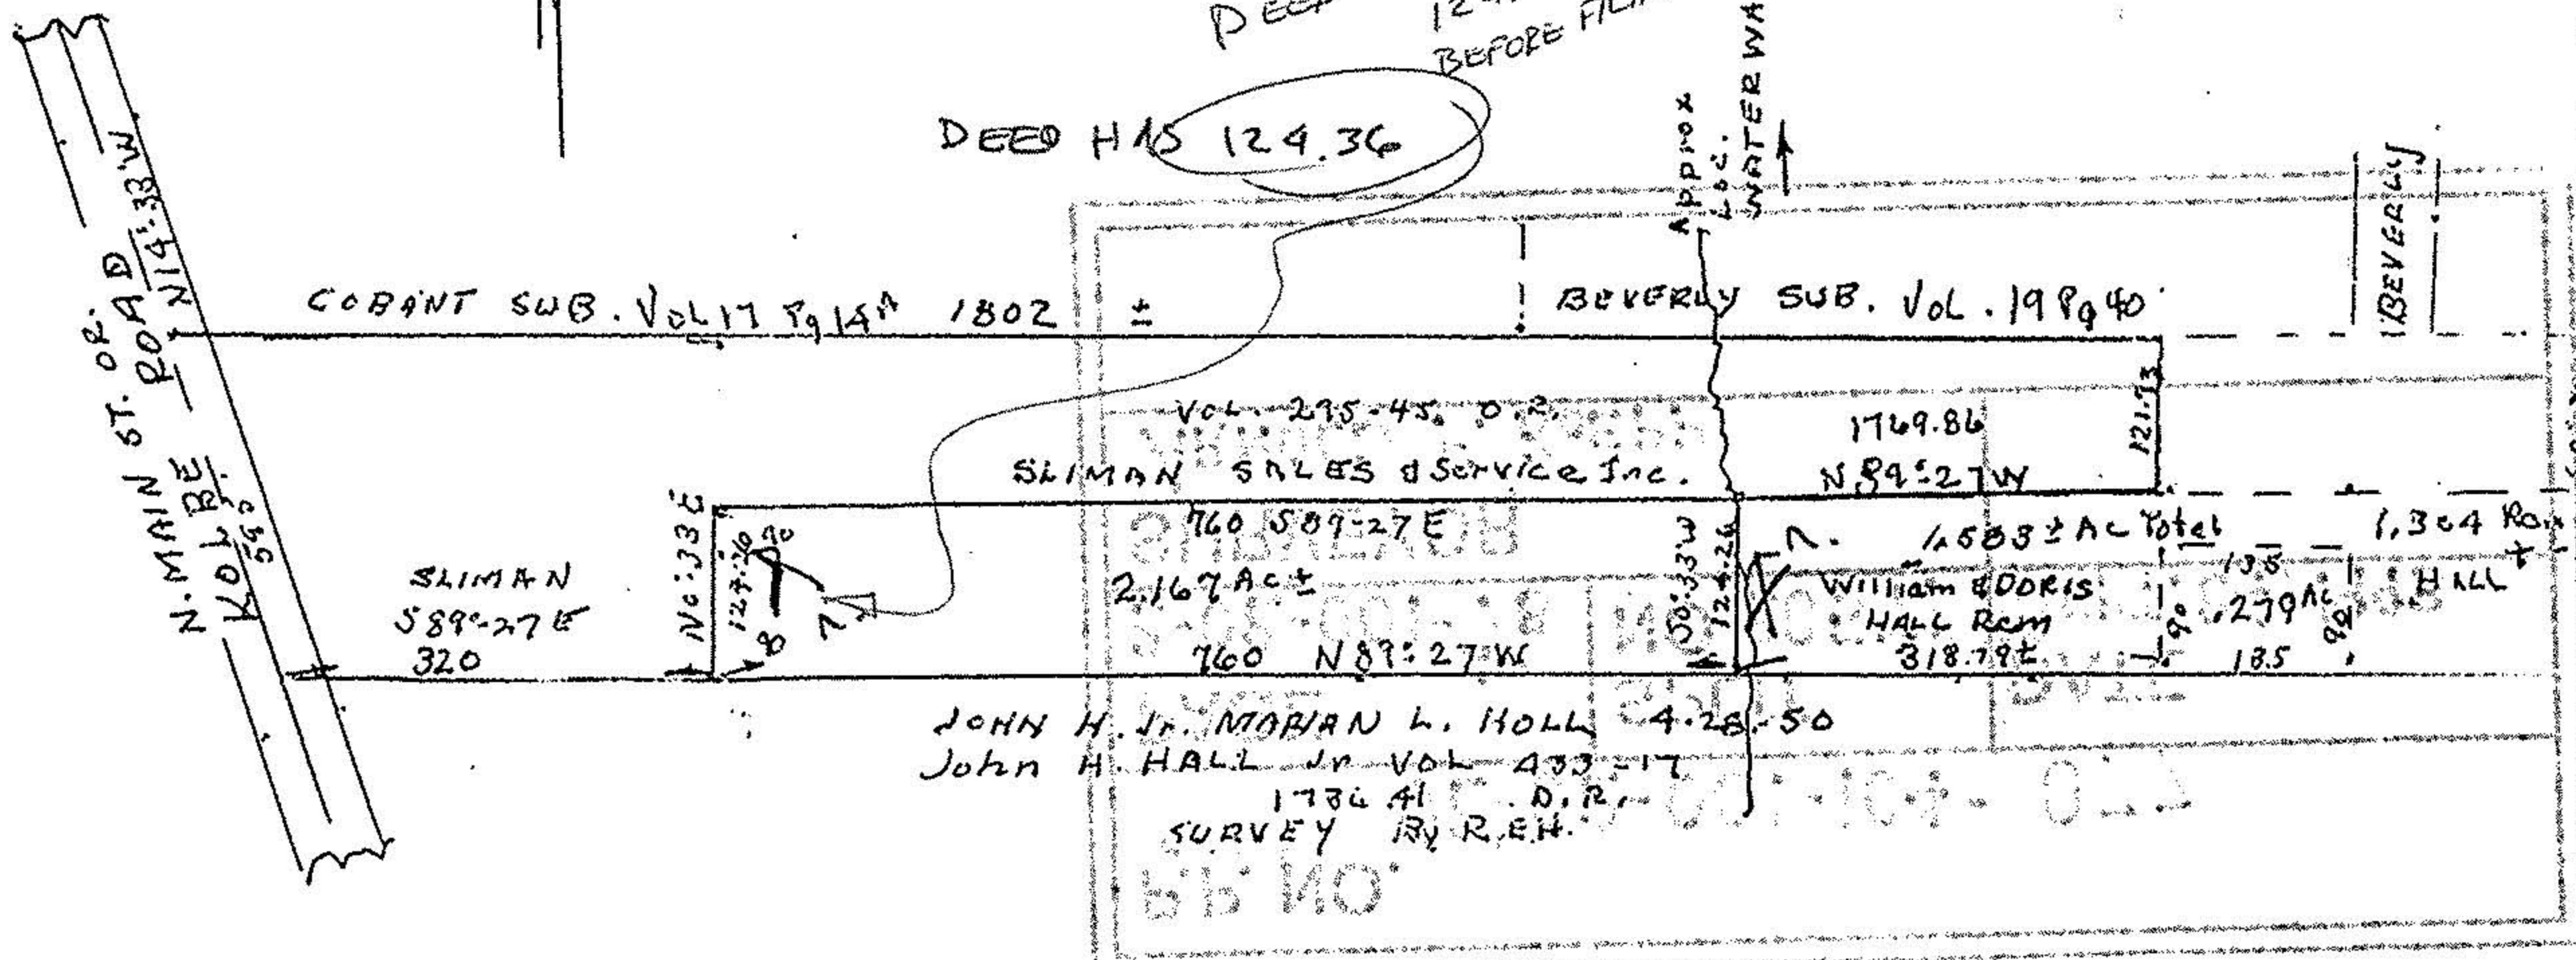

20571
 APPROVED
 LORAIN CO.
 MAP DEPT.
 DATE 10-22-93
 PAGE 2-02-001-
 BY CAROLYN
 FRANCIS
 VOID AFTER # 20571

02-02-001-104-

