JOB NO. 97039

NOTE:
R = RECORD
U = USED

50 0 50 100
SCALE IN FEET
SCALE: 1" = 50'

NOTE: BEARINGS ARE TO AN ASSUMED MERIDIAN AND ARE TO BE USED TO DENOTE ANGLES ONLY

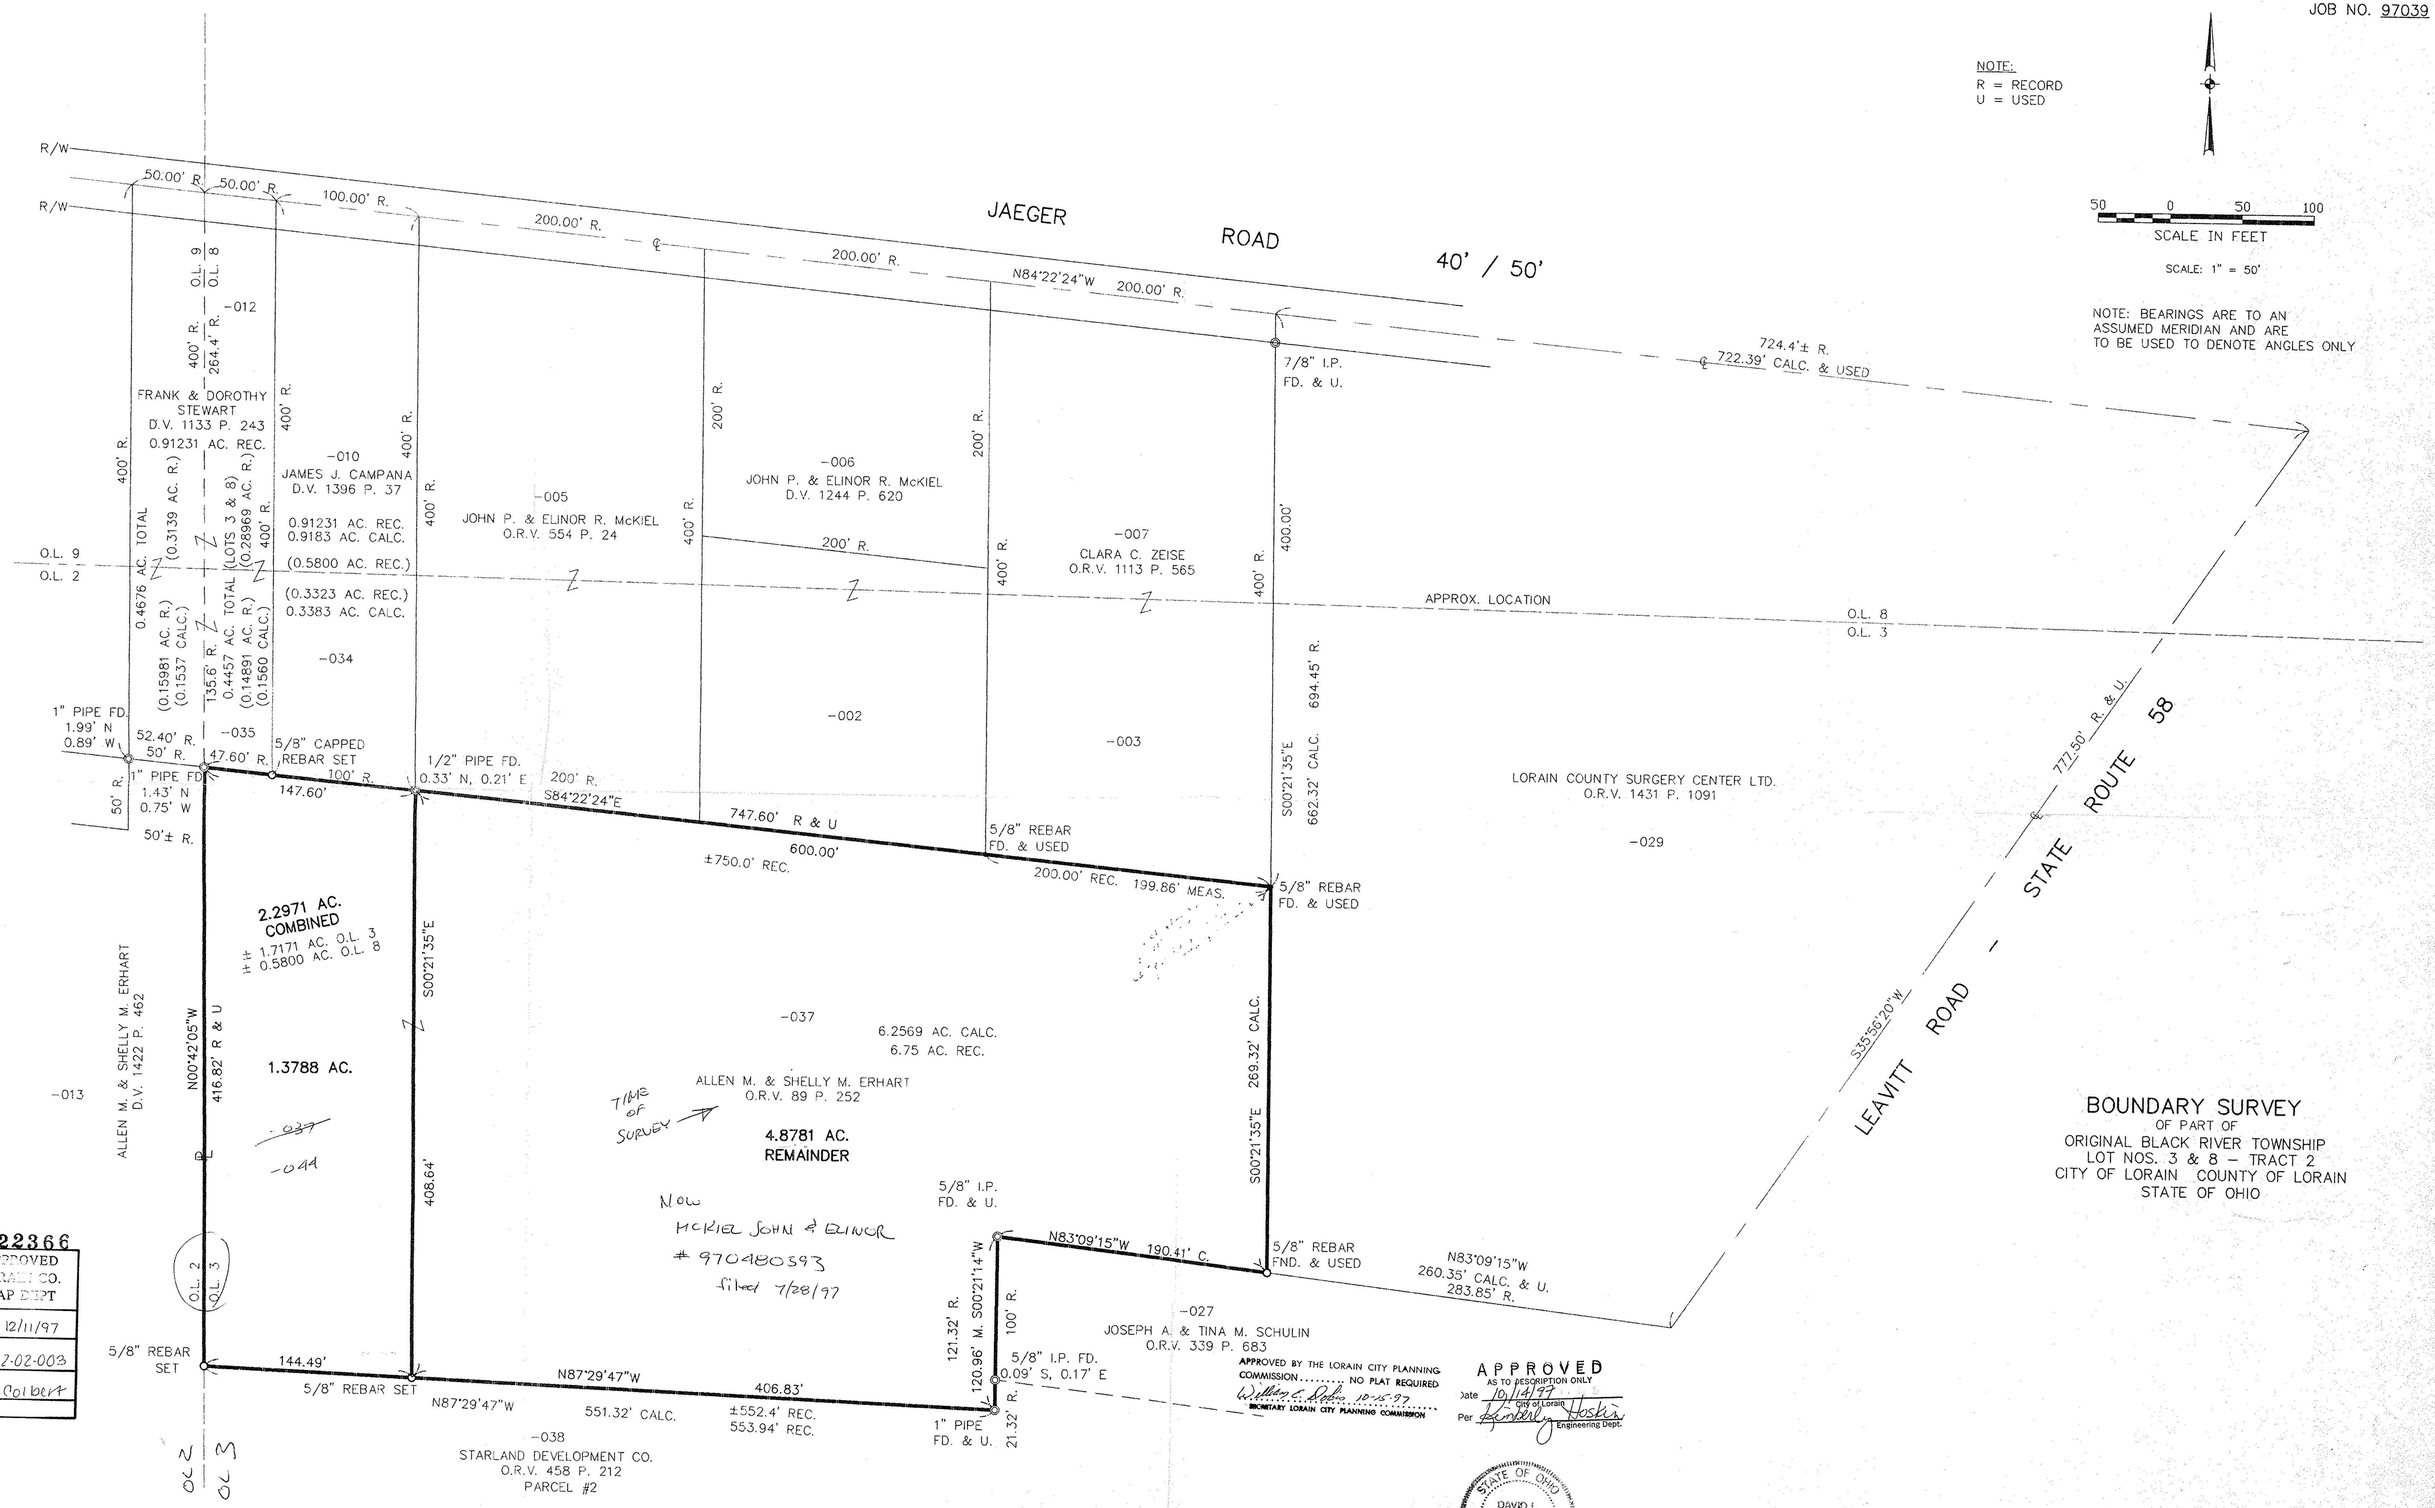

BOUNDARY SURVEY
OF PART OF
ORIGINAL BLACK RIVER TOWNSHIP
LOT NOS. 3 & 8 – TRACT 2
CITY OF LORAIN COUNTY OF LORAIN
STATE OF OHIO

#22366
APPROVED
LORAIN CO.
MAP DEPT
DATE 12/11/97
PAGE 2-02-003
BY K Colbert

APPROVED BY THE LORAIN CITY PLANNING COMMISSION..... NO PLAT REQUIRED
William C. Dobie 10-15-97
SECRETARY LORAIN CITY PLANNING COMMISSION

APPROVED
AS TO DESCRIPTION ONLY
Date 10/14/97
City of Lorain
Per Kimberly Hoskin
Engineering Dept.

STATE OF OHIO
DAVID L. ELWELL
6333
REGISTERED SURVEYOR

David L. Elwell
DAVID L. ELWELL REG. SURVEYOR NO. 6333
5-21-97

KS ASSOCIATES, INC.
ENGINEERS-SURVEYORS
424 Middle Avenue
P.O. Box 69
Elyria, Ohio 44036
PHONE (216) 322-6327 * FAX (216) 284-0023
KS ASSOCIATES INCORPORATED

L:\97039\DWGS\0-SURV01