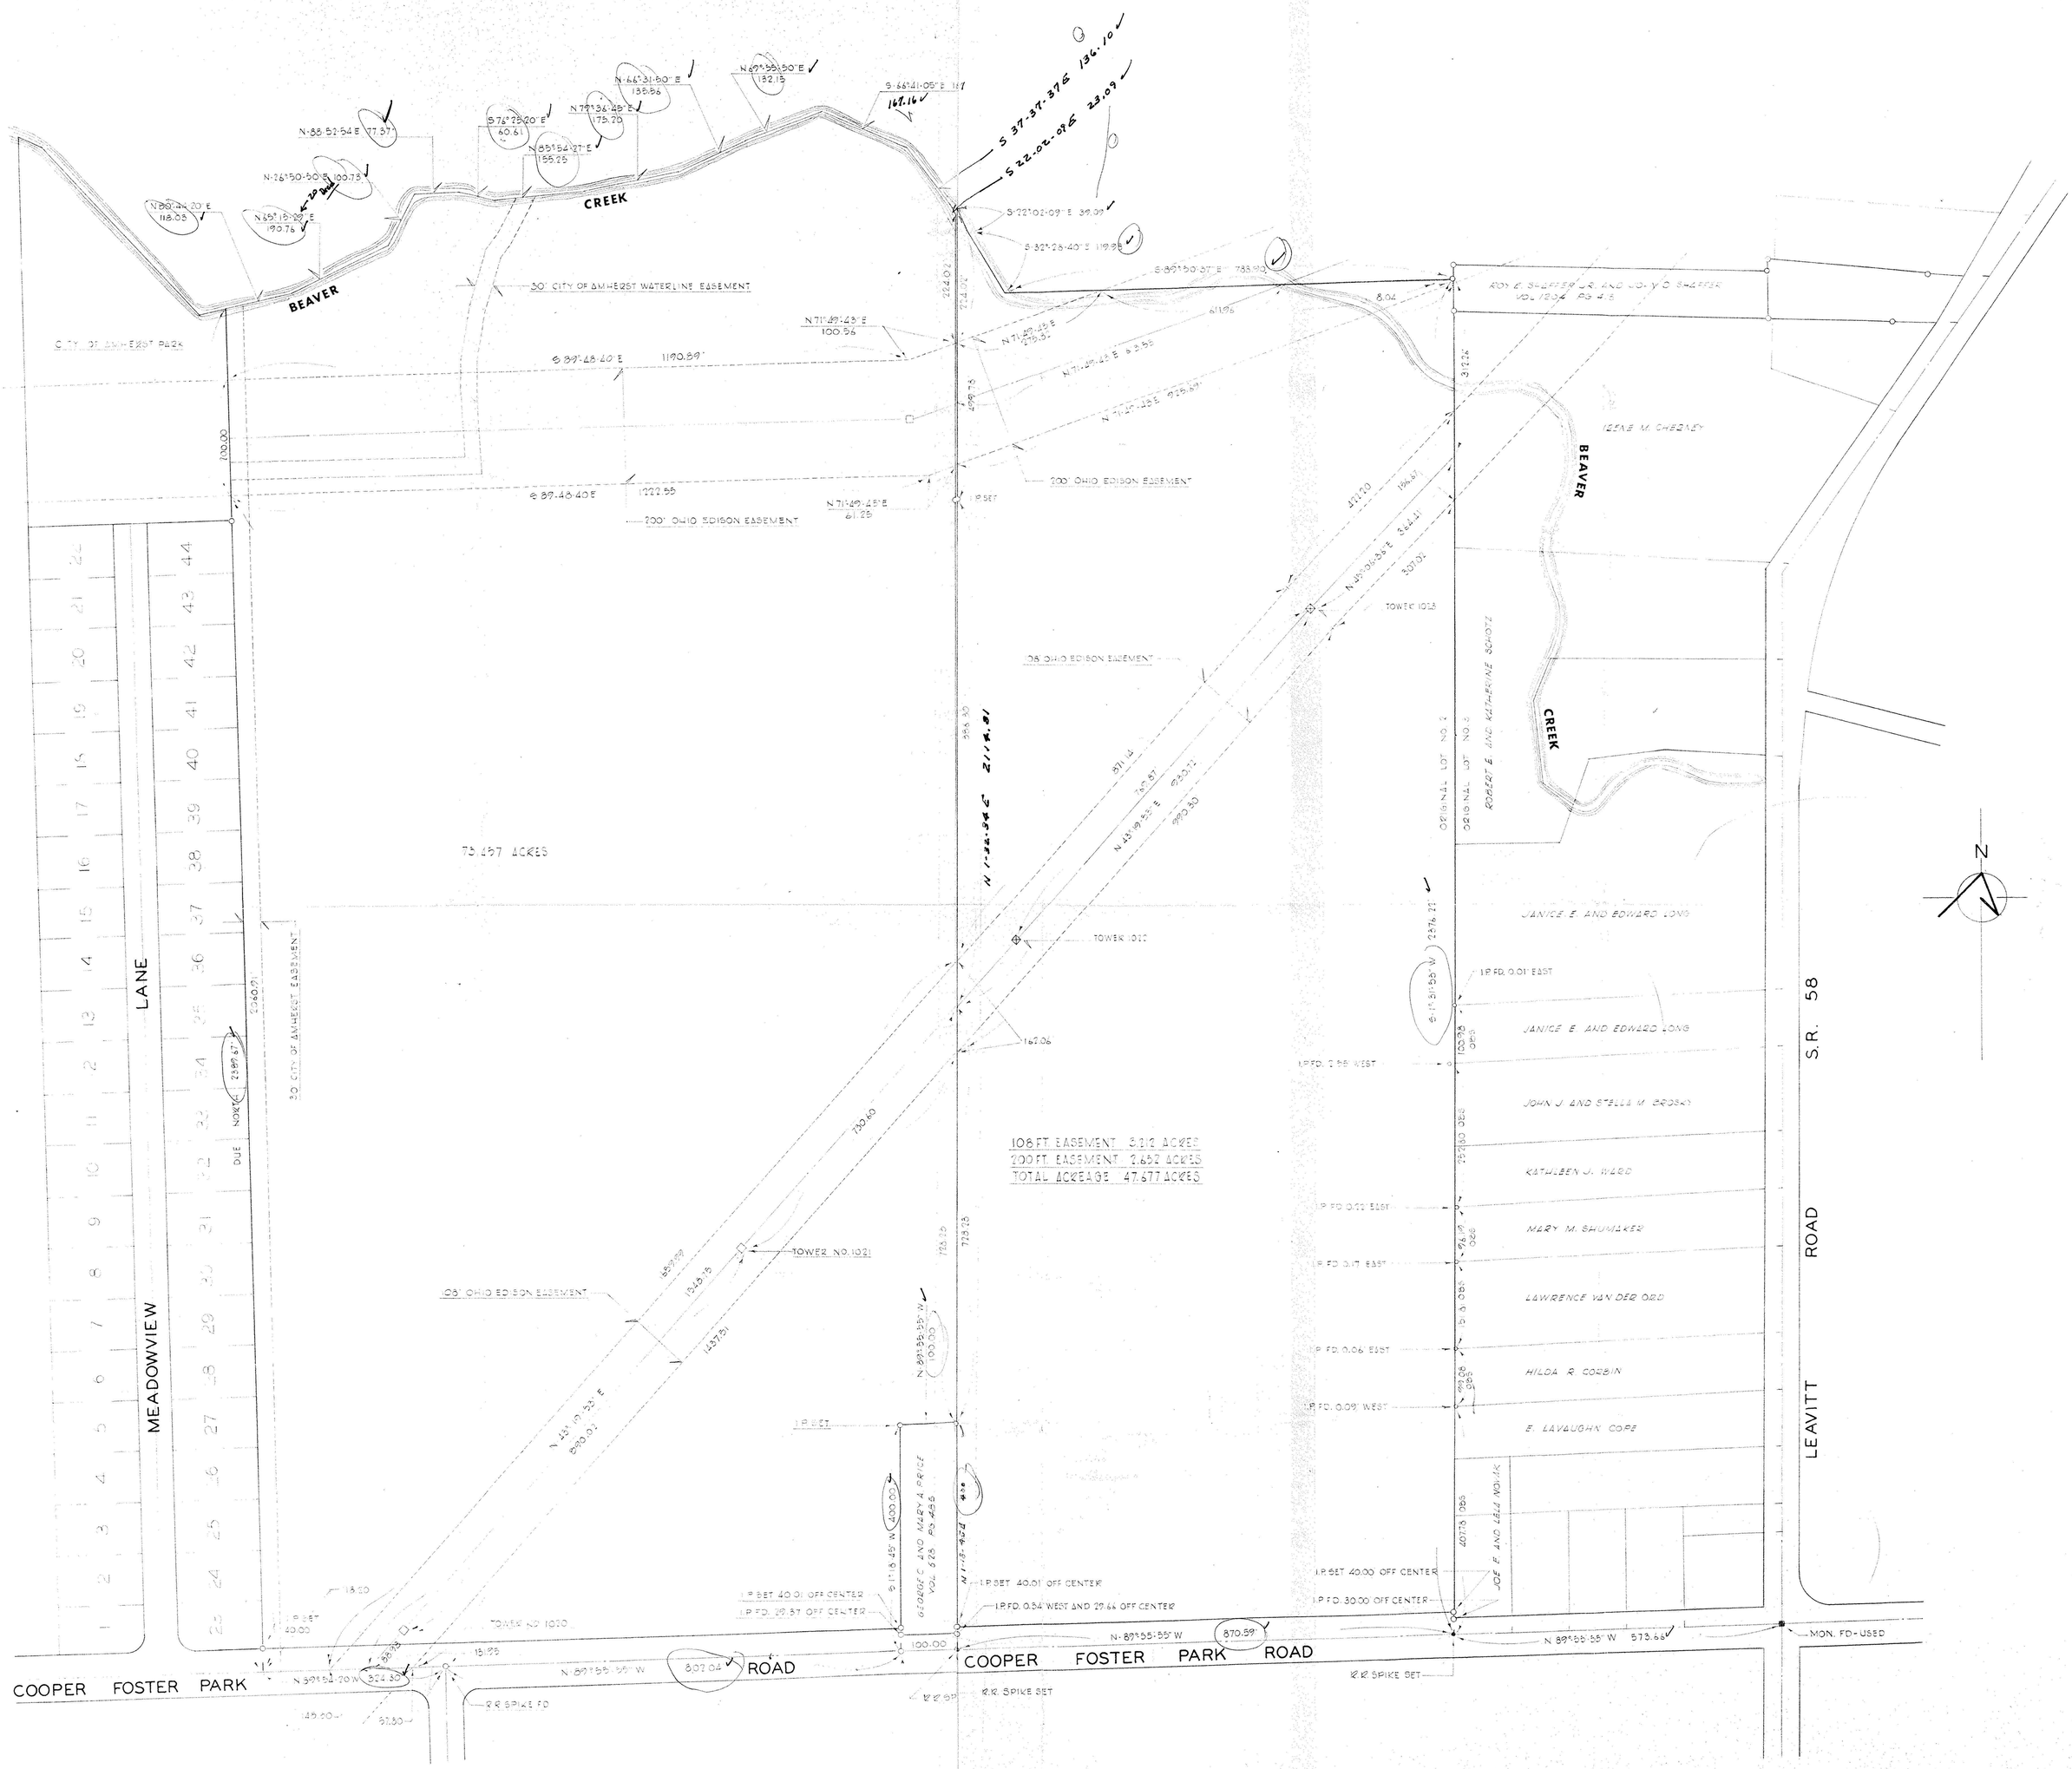

THE SHAFFER COMPANY COOPER FOSTER PARK ROAD LORAIN OHIO	LOT SPLIT OF PART OF ORIGINAL LOT NO. 2 TRACT NO. 2 OF BLACK RIVER TOWNSHIP	CITY OF LORAIN JANUARY 1981 SCALE 1"= 100'	'ER COMPANY 'STER PARK RD. OHIO	LOT SPLIT OF PART OF ORIGINAL LOT NO. 2 TRACT NO. 2 OF BLACK RIVER TOWNSHIP	CITY OF LORAIN JANUARY 1981 SCALE 1"= 100'	**norm hura and associates**