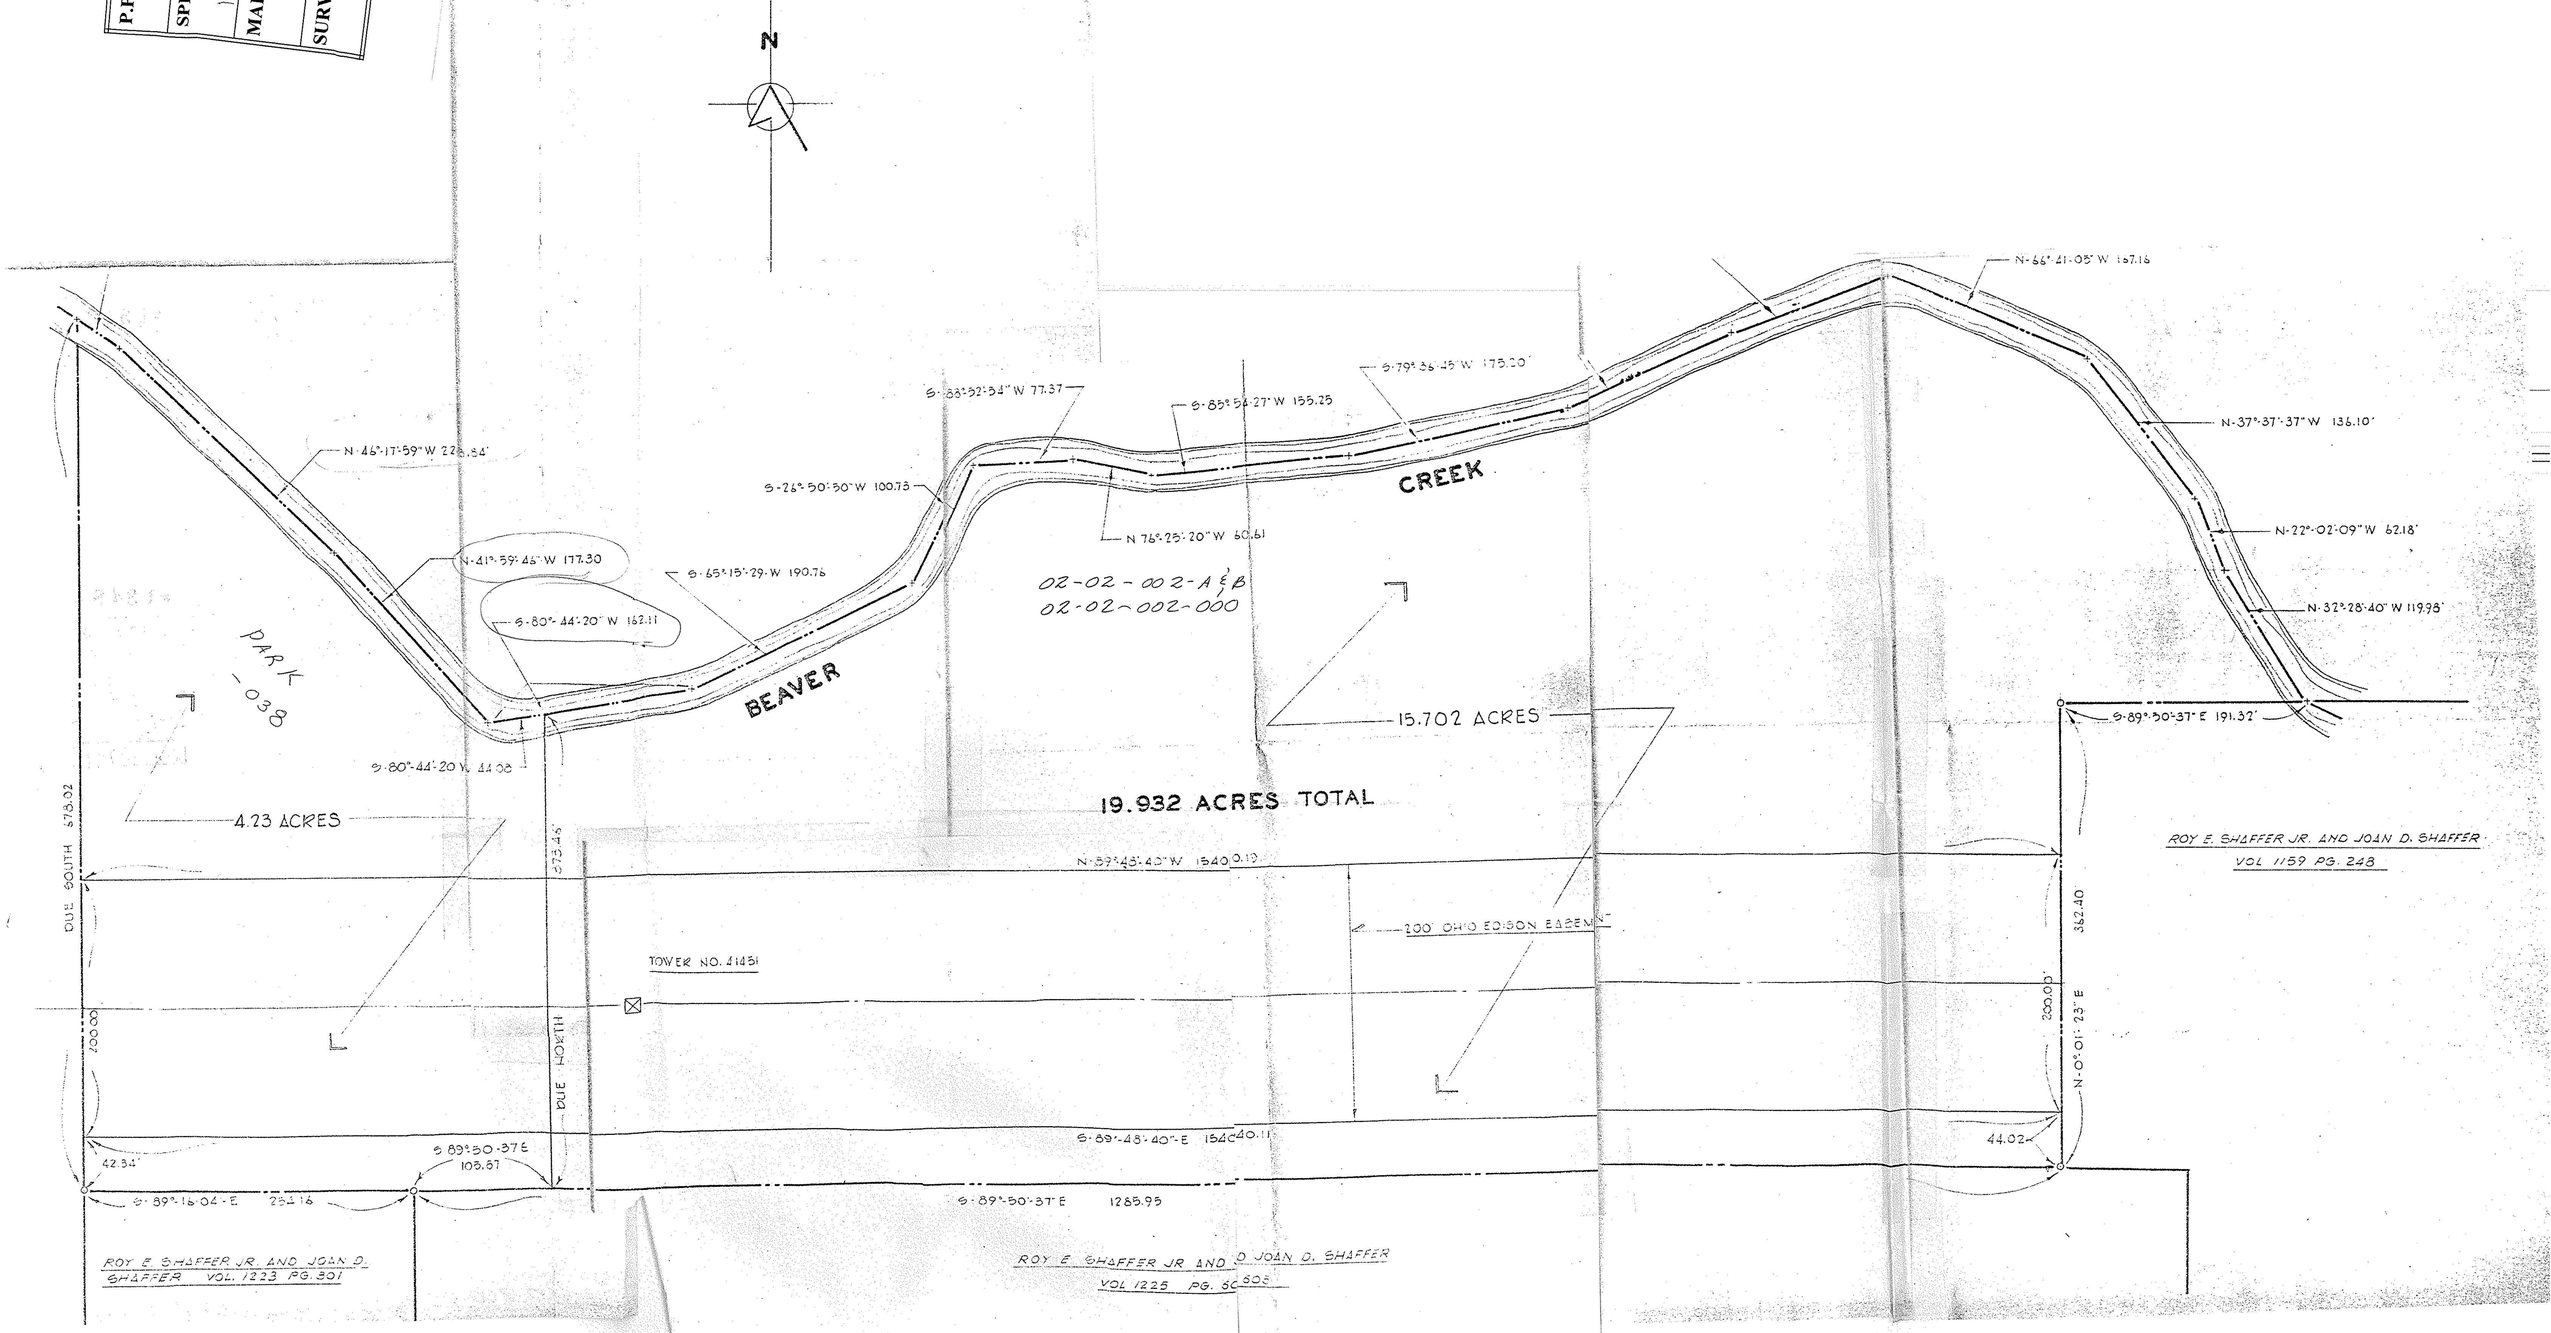
N
N-66°-41-05" W 157.16
S-79°-36-45" W 175.20'
S-88°-52-54" W 77.37
S-85°-54-27" W 155.25
N-37°-37'-37" W 136.10'
N-46°-17-59" W 228.54'
S-26°-50-50" W 100.73
CREEK
N-22°-02-09" W 62.18'
N 76°-23-20" W 60.61
N-41°-59-46" W 177.30
S-65°-15-29" W 190.76
02-02-002-A & B
02-02-002-000
N-32°-28-40" W 119.98'
S-80°-44-20" W 162.11
PARK
-038
BEAVER
15.702 ACRES
S-89°-50-37" E 191.32'
S-80°-44-20" W 44.08
19.932 ACRES TOTAL
4.23 ACRES
DUE SOUTH 573.32
573.45'
N-89°-48-40" W 1540.19
ROY E. SHAFFER JR. AND JOAN D. SHAFFER
VOL 1159 PG. 248
200' OHIO EDISON EASEMENT
TOWER NO. 41451
362.40
200.00
DUE NORTH
200.05'
N-0°-01-23" E
S-89°-48-40" E 1540.11
44.02
42.34'
S 89°-50-37 E
103.87
S-89°-16-04" E 284.16
S-89°-50-37" E 1285.95
ROY E SHAFFER JR. AND JOAN D. SHAFFER VOL. 1223 PG. 301
ROY E SHAFFER JR AND JOAN D. SHAFFER
VOL 1225 PG. 60 505