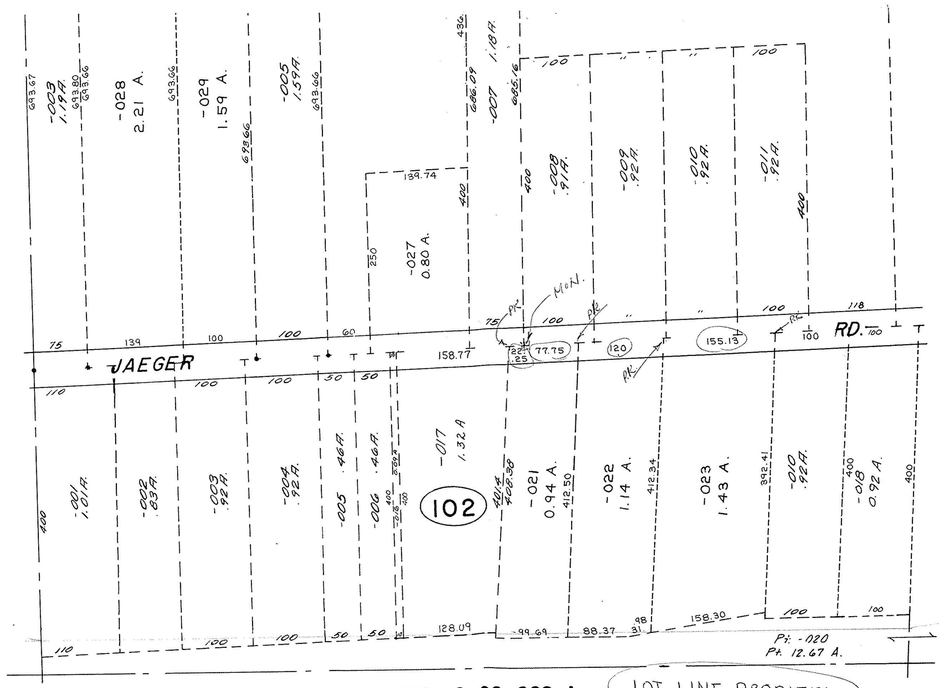

SEE 2-02-002-A

LOT LINE PROBLEM
NOT ABLE TO Complete
Do not have enough info
TAX MAP Pg. To corr.
2-02-009-A
Lot Line.

2-02-008-A

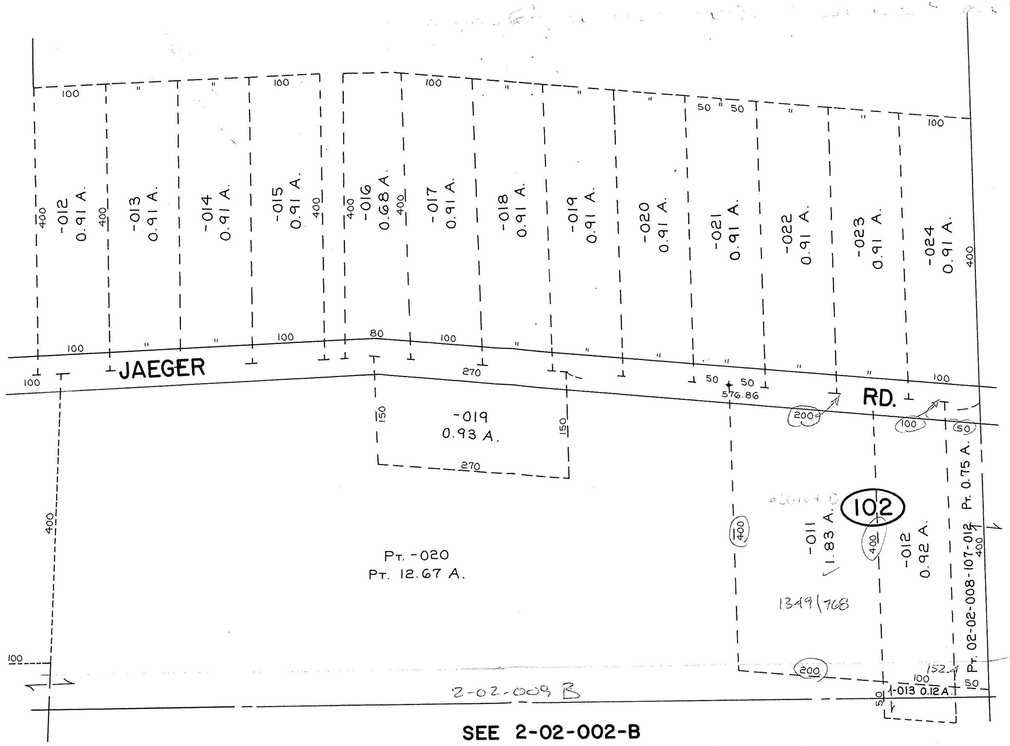

SEE 2-02-002-B

LOT LINE PROBLEM - NOT ABLE TO COMPLETE - DO NOT HAVE ENOUGH INFO TO CORR.

TAX MAP REF. 2-02-009-B