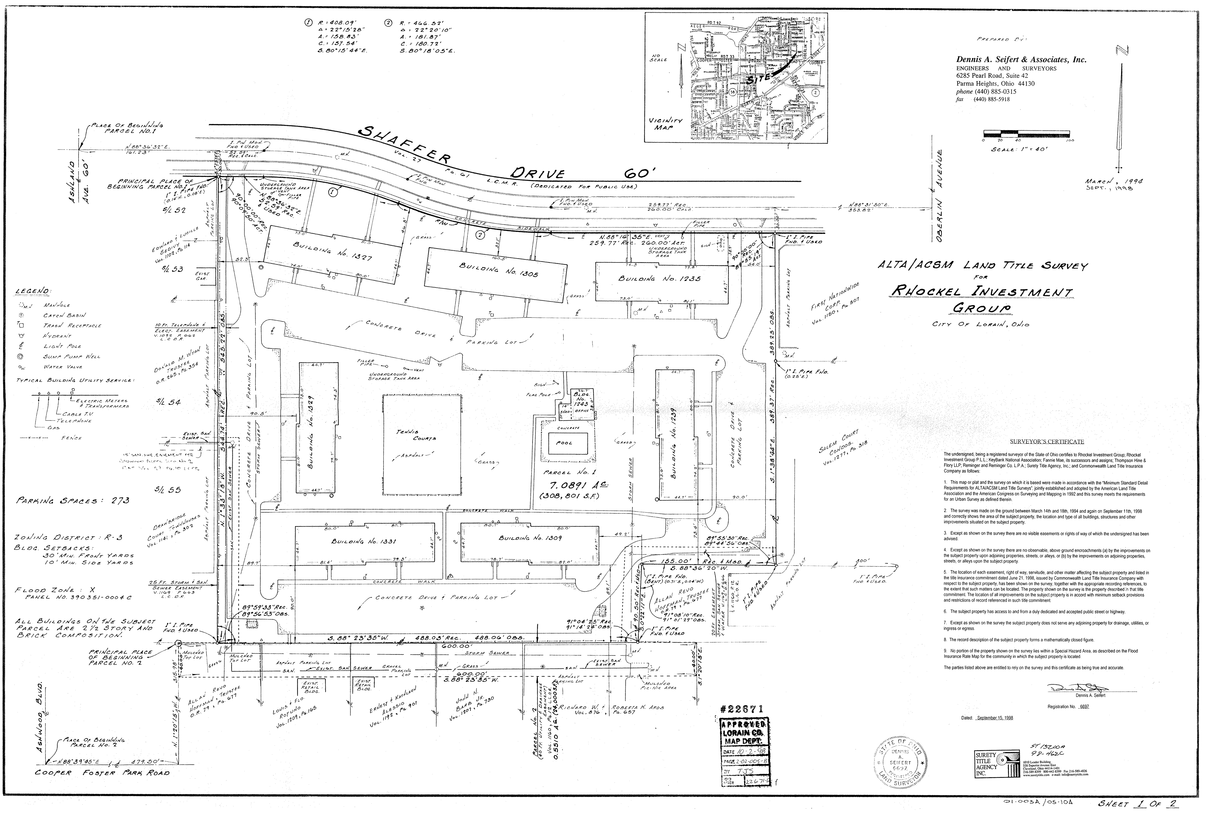

PREPARED BY:

Dennis A. Seifert & Associates, Inc.
ENGINEERS AND SURVEYORS
6285 Pearl Road, Suite 42
Parma Heights, Ohio 44130
phone (440) 885-0315
fax (440) 885-5918

SCALE: 1" = 40'

MARCH, 1998
SEPT., 1998

ALTA/ACSM LAND TITLE SURVEY FOR RHOCKEL INVESTMENT GROUP

CITY OF LORAIN, OHIO

SURVEYOR'S CERTIFICATE


1. This map or plat and the survey on which it is based were made in accordance with the "Minimum Standard Detail Requirements for ALTA/ACSM Land Title Surveys", jointly established and adopted by the American Land Title Association and the American Congress on Surveying and Mapping in 1992 and this survey meets the requirements for an Urban Survey as defined therein.

2. The survey was made on the ground between March 14th and 18th, 1994 and again on September 11th, 1998 and correctly shows the area of the subject property, the location and type of all buildings, structures and other improvements situated on the subject property.

3. Except as shown on the survey there are no visible easements or rights of way of which the undersigned has been advised.

4. Except as shown on the survey there are no observable, above ground encroachments (a) by the improvements on the subject property upon adjoining properties, streets, or alleys, or (b) by the improvements on adjoining properties, streets, or alleys upon the subject property.

5. The location of each easement, right of way, servitude, and other matter affecting the subject property and listed in the title insurance commitment dated June 21, 1998, issued by Commonwealth Land Title Insurance Company with respect to the subject property, has been shown on the survey, together with the appropriate recording references, to the extent that such matters can be located. The property shown on the survey is the property described in that title insurance commitment. The property described in that title insurance commitment property is in accord with minimum setback provisions and restrictions of record referenced in such title commitment.

6. The subject property has access to and from a duly dedicated and accepted public street or highway.

7. Except as shown on the survey the subject property does not serve any adjoining property for drainage, utilities, or ingress or egress.

8. The record description of the subject property forms a mathematically closed figure.

9. No portion of the property shown on the survey lies within a Special Hazard Area, as described on the Flood Insurance Rate Map for the community in which the subject property is located.

The parties listed above are entitled to rely on the survey and this certificate as being true and accurate.

Dennis A. Seifert

Registration No. 6697

Dated: September 15, 1998

STATE OF OHIO DENNIS A. SEIFERT 6697 REGISTERED LAND SURVEYOR

SURVEY TITLE AGENCY INC.
Order No. 97-32006A
Commitment No. 98-1637C
Surveyor: Seifert
Field Book: 1235
Page: 1-2
Drawn by: Seifert
Reinegar & Reinegar Co. L.P.A.
Commonwealth Land Title Ins. Co.
Fax 216-696-4009

97/32006
97-1637C

01-005A/05-104

SHEET 1 OF 2

QUIT CLAIM DEED

KNOW ALL MEN BY THESE PRESENTS, that **RHOCKEL INVESTMENT GROUP, an Ohio general partnership,** the Grantor, who claims title by and through instrument, recorded in Volume 88 , Page 1021, County Recorder's Office, Lorain County, Ohio, for value received, do hereby remise, release and forever quit-claim unto the said Grantee, **RHOCKEL INVESTMENT GROUP, P.L.L., an Ohio general partnership with limited liability,** the Grantee, whose mailing address will be: **13595 Cedar Road, Suite 100, University Heights, Ohio 44022,** hereinafter sometimes called, released and forever quit-claimed, and does by these presents absolutely give, grant, remise, release and forever quit-claim unto the said Grantee, **RHOCKEL INVESTMENT GROUP, P.L.L.,** it successors and assigns forever, all such right and title as it, the said Grantor, has or ought to have in and to the following described piece or parcel of land, situated in the City of Lorain, County of Lorain, and State of Ohio:

See Exhibit "A" attached.

TO HAVE AND TO HOLD, the premises aforesaid, with the appurtenances thereunto belonging, to the said Grantee, **RHOCKEL INVESTMENT GROUP, P.L.L.,** its successors and assigns, so that neither the said Grantor, nor its successors and assigns, nor any other persons claiming title through or under it, shall or will hereafter claim or demand any right or title to the premises, or any part thereof, but they and every one of them shall by these presents be excluded and forever barred.

IN WITNESS WHEREOF, I, **YOUNG S. LEE,** have hereunto set my hand, the ninety-eight (1998) day of October, in the year of our Lord one thousand nine hundred and

Signed in the Presence of

William V. Valle
Signature of Witness
Typed or Printed Name of Witness

Linda K. Wolf
Signature of Witness
Typed or Printed Name of Witness

RHOCKEL INVESTMENT GROUP,
An Ohio General Partnership,
BY: YOUNG S. LEE, **Managing Partner**

SURVEY TITLE AGENCY INC.
Order No. 97-32006A
Commitment No. 98-1637C
Surveyor: Seifert
Field Book: 1235
Page: 1-2
Drawn by: Seifert
Reinegar & Reinegar Co. L.P.A.
Commonwealth Land Title Ins. Co.
Fax 216-696-4009

THE STATE OF OHIO)
) SS.
COUNTY OF CUYAHOGA)

BEFORE ME, a notary public in and for said County and State, personally appeared the above named **RHOCKEL INVESTMENT GROUP,** an Ohio general partnership, by **YOUNG S. LEE, its Managing Partner,** who acknowledges that he did sign the foregoing instrument and the same is his free act and deed as its said Managing Partner.

IN TESTIMONY WHEREOF, I have hereunto set my hand and official seal, at Cleveland, Ohio, this 1st day of October, A.D. 1998.

Hilary Patrick
My Commission Expires:

WILLIAM V. VALLE, Attorney
NOTARY PUBLIC, STATE OF OHIO
My commission has no expiration date
Section 147.03 R.C.

This Instrument Prepared By: WVV
REININGER & REININGER CO., L.P.A.
Cleveland, Ohio 44114

2

EXHIBIT "A"

Parcel No.1
Situated in the City of Lorain, County of Lorain and State of Ohio, and known as part of Block C in Ashwood Acres Subdivision No.2 as recorded in Volume 29, Page 10 of Lorain County Plat Records, and being a part of Original Black River Township Lot No.5, Tract No.2 further described as follows:

Beginning at the intersection of the centerlines of Ashland Avenue and Shaffer Drive;

Thence North 88° 36' 32" East along the centerline of Shaffer Drive, 161.23 ft. to a point;

Thence South 1° 23' 28" East, 30.00 ft. to a point, said point being the northeast corner of Sublot 52 in the Ashwood Acres Subdivision No.2, and the Principal Place of Beginning for the parcel described herein;

Thence North 88° 36' 32" East along the south line of Shaffer Drive, 52.59 ft. to a point of curvature;

Thence continuing along the south line of Shaffer Drive, along the arc of a curve to the left, and having a radius of 468.09 ft. central angle of 22° 35' 26", chord of 157.54 ft. and a chord bearing of South 80° 15' 44" East, 158.83 ft. to a point of reverse curvature;

Thence following the south line of Shaffer Drive, along the arc of a curve to the left, and having a radius of 466.52 ft., central angle of 22° 20' 10", chord of 180.72 ft. and a chord bearing of South 80° 14' 05" East, 181.87 ft. to a point of tangency;

Thence continuing along the south line of Shaffer Drive, North 88° 16' 35" East, 260.00 ft. to an iron pipe found;

Thence South 1° 38' 44" East, 389.23 ft. to an iron pipe found;

Thence South 88° 36' 20" West, 155.00 ft. to a point;

Thence South 0° 22' 11" East, 90.50 ft. to an iron pin found;

Thence North 88° 23' 35" West, 488.06 ft. to an iron pipe found at the southeast corner of Sublot 55 in the aforementioned Ashwood Acres Subdivision No.2;

Thence North 1° 33' 18" West along the easterly line of Sublots 55, 54, 53 and 52, 545.22 ft. to the Principal Place of Beginning, and containing within said boundaries 7.0891 acres of land, subject to all legal highways as surveyed by Dennis A. Seifert and Associates, Inc., in March, 1994.

Permanent Parcel Numbers: 02-02-005-114-034, 02-02-005-114-035, 02-02-005-114-036, 02-02-005-114-037, 02-02-005-114-040, 035, 02-02-114-034, 02-02-005-114-037, 02-02-005-114-040, 02-02-005-114-054, 02-02-005-114-055, and 02-02-005-114-056

Parcel No.2
A Non-Exclusive Easement for the purpose of installation, maintenance and improvement of a drainage channel, appurtenant to Parcel No.1, as established by instrument recorded in Volume 1160, Page 12 of Lorain County Records over the following described property:

Being a strip of land 40 ft. wide between parallel lines situated in the City of Lorain, County of Lorain, and State of Ohio, and known as being a part of Block C in Ashwood Acres Subdivision No.2, as recorded in Volume 29, Page 10 of Lorain County Plat Records, and being a part of Original Black River Township Lot No.5, Tract No.2, Further described as follow:

Beginning at the intersection of the centerlines of Cooper Foster Park Road and Ashwood Boulevard;

Thence North 88° 39' 45" East along the centerline of Cooper Foster Park Road, 479.50 ft. to a point;

Thence North 1° 20' 15" West along the west line of Block C in said Ashwood Acres Subdivision No.2, 315.98 ft. to the south line of Sublot 55 in said Ashwood Acres Subdivision No.2, said point being the principal place of beginning for the parcel described herein;

Thence North 88° 23' 35" East, 600.00 ft. to a point in the east line of Block C;

Thence South 1° 20' 15" East along the east line of Block C, 40.00 ft. to a point;

Thence South 88° 23' 35" West, 600.00 ft. to a point in the west line of Block C;

Thence North 1° 20' 15" West along the west line of Block C, 40.00 ft. to the PRINCIPAL PLACE OF BEGINNING, and containing within said boundaries 0.5510 acres of land, subject to all legal highways as surveyed by Dennis A. Seifert and Associates, Inc., in March, 1994.

PARCEL NO.1

LEGAL DESCRIPTION

Situated in the City of Lorain, County of Lorain and State of Ohio, and known as being a part of Block C in Ashwood Acres Subdivision No.2, as recorded in Volume 29, Page 10, of Lorain County Plat Records, and being a part of Original Black River Township Lot No. 5, Tract No. 2, further described as follows:

Beginning at the intersection of the centerlines of Ashland Avenue and Shaffer Drive;

Thence North 88-36-32 East along the centerline of Shaffer Drive, 161.23 feet to a point;

Thence South 1-23-28 East, 30.00 feet to a point, said point being the northeast corner of sublot 52 in the Ashwood Acres Subdivision No. 2, and the PRINCIPAL PLACE OF BEGINNING for the parcel described herein;

Thence North 88-36-32 East along the south line of Shaffer Drive, 52.59 feet to a point of curvature;

Thence continuing along the south line of Shaffer Drive, along the arc of a curve to the right, and having a radius of 468.09 feet, central angle of 22-15-28, chord of 157.54 feet and a chord bearing of South 88-15-44 East, 158.83 feet to a point of reverse curvature;

Thence following the south line of Shaffer Drive, along the arc of a curve to the left, and having a radius of 466.52 feet, central angle of 22-20-10, chord of 180.72 feet and a chord bearing of South 80-14-05 East, 181.87 feet to a point of tangency;

Thence continuing along the south line of Shaffer Drive, North 88-16-35 East, 260.00 feet to an iron pipe found;

Thence South 1-38-44 East, 389.23 feet to an iron pipe found;

Thence South 88-36-20 West, 155.00 feet to a point;

Thence South 0-22-11 East, 90.50 feet to an iron pin found;

Thence South 88-23-35 West, 488.06 feet to an iron pipe found at the southeast corner of sublot 55 in the aforementioned Ashwood Acres Subdivision No. 2;

Thence North 1-33-18 West along the easterly line of sublots 55, 54, 53 and 52, 545.22 feet to the PRINCIPAL PLACE OF BEGINNING and containing within said boundaries 7.0891 acres of land, subject to all legal highways as surveyed by Dennis A. Seifert and Associates, Inc., in March, 1994.

PARCEL NO.2

LEGAL DESCRIPTION

A nonexclusive easement for the purpose of installation, maintenance and improvement of a drainage channel, appurtenant to Parcel No. 1 as established by instrument recorded in Volume 1160, Page 12, of Lorain County Records over the following described property:

Being a strip of land 40 feet wide between parallel lines situated in the City of Lorain, County of Lorain and State of Ohio, and known as being a part of Block C in Ashwood Acres Subdivision No. 2, as recorded in Volume29, Page 10, of Lorain County Plat Records, and being a part of Original Black River Township Lot No. 5, Tract No. 2, further described as follows:

Beginning at the intersection of the centerlines of Cooper Foster Park Road and Ashwood Boulevard;

Thence North 88-39-45 East along the centerline of Cooper Foster Park Road, 479.50 feet to a point;

Thence North 1-20-15 West along the west line of Block C in said Ashwood Acres Subdivision No. 2, 315.98 feet to the south line of sublot 55 in said Ashwood Acres Subdivision No. 2, said point being the PRINCIPAL PLACE OF BEGINNING for the parcel described herein;

Thence North 88-23-35 East, 600.00 feet to a point in the east line of Block C;

Thence South 1-20-15 East along the east line of Block C, 40.00 feet to a point;

Thence South 88-23-35 West, 600.00 feet to a point in the west line of Block C;

Thence North 1-20-15 West along the west line of Block C, 40.00 feet to the PRINCIPAL PLACE OF BEGINNING, and containing within said boundaries 0.5510 acres of land, subject to all legal highways as surveyed by Dennis A. Seifert and Associates, Inc., in March, 1994.

This is to certify that this map or plat and the survey on which it is based were made in accordance with "Minimum Standard Detail Requirements for ALTA/ACSM Land Title Surveys" jointly established and adopted by American Land Title Association and the American Congress on Surveying and Mapping in 1992, and includes items 1, 2, 3, 4, 7a, 8 and 10 of Table A thereof, and (ii) pursuant to the accuracy standards of an Urban Survey.

Dated: Sept. 15, 1998

Dennis A. Seifert
Dennis A. Seifert

6697
Reg. No.

STATE OF OHIO DENNIS A. SEIFERT 6697 REGISTERED LAND SURVEYOR

1. Easement to Ohio Fuel, Vol. 288, Pg. 296: Relates to the original 55 AC. parcel and cannot be located on this site.

2. Easement to Ohio Edison, Vol. 1161, Pg. 959: Is a blanket easement.

3. Easement to Lorain Telephone, Is a blanket easement.

4. Easement to the City of Lorain, Vol. Does not affect parcels 1 & 2.

Here is the survey. Please call me if you have any questions.

#22671-D
APPROVED
LORAIN CO.
MAP DEPT.
DATE 01-02-99
PAGE 01-01-005-B
BY T.T.S.
Job 22671-D

01-005A/05-104

SHEET 2 OF 2

Thence North 1° 20' 15" West along the west line of Block C, 40.00 ft. to the principal place of beginning, and containing within said boundaries 0.5510 acres of land, subject to all legal highways as surveyed by Dennis A. Seifert and Associates, Inc., in March, 1994.

Permanent Parcel Numbers: 02-02-005-114-053, 02-02-005-114-042, 02-02-005-114-046, 02-02-005-114-050, 02-02-005-114-048, and 02-02-005-13 4-052

P.P. NO. 02-02-005-114-034,035,036 -037,040,054 -037,036	
SPLIT # 22671-D	DATE OF SURVEY Sept. 15, 1998
MAP PAGE 02-02-005-B	
SURVEYOR Dennis A. Seifert	