A mortgage Location Survey shall be defined as an instrumentality, common to the mortgage lending industry, whereby, substantial proof is submitted to the mortgage lender and/or title insuror that the building (s) and/or other improvements are actually located on the land covered by the legal description in the mortgage and that said Mortgage Location Survey is a professional service, provided by Professional Surveyors, SOLELY FOR THE INTENT OF AND USE BY THE MORTGAGEE AND/OR TITLE INSURER. The Mortgage Location Survey does not constitute and improvement to the property, and is only a professional opinion which these parties may use as a guide to arrive at any decisions they may wish to make concerning said real property.

THIS MORTGAGE LOCATION SURVEY IS NOT A BOUNDARY SURVEY PURSUANT TO CHAPTER 4733-37, OHIO ADMINISTRATIVE CODE.

SUBLOT MEB IN VOL. - PAGE -

TOWNSHIP - LOT - TRACT -

TIMOTHY J. [illegible]ELLER - PROF. SUR. #7104

DATE 10-6-97

LINEAR ERROR OF SURVEY
± 2 FT.

STATE OF OHIO

02-01-003-141-001

SCALE 1" = 20'

0 5 10 20

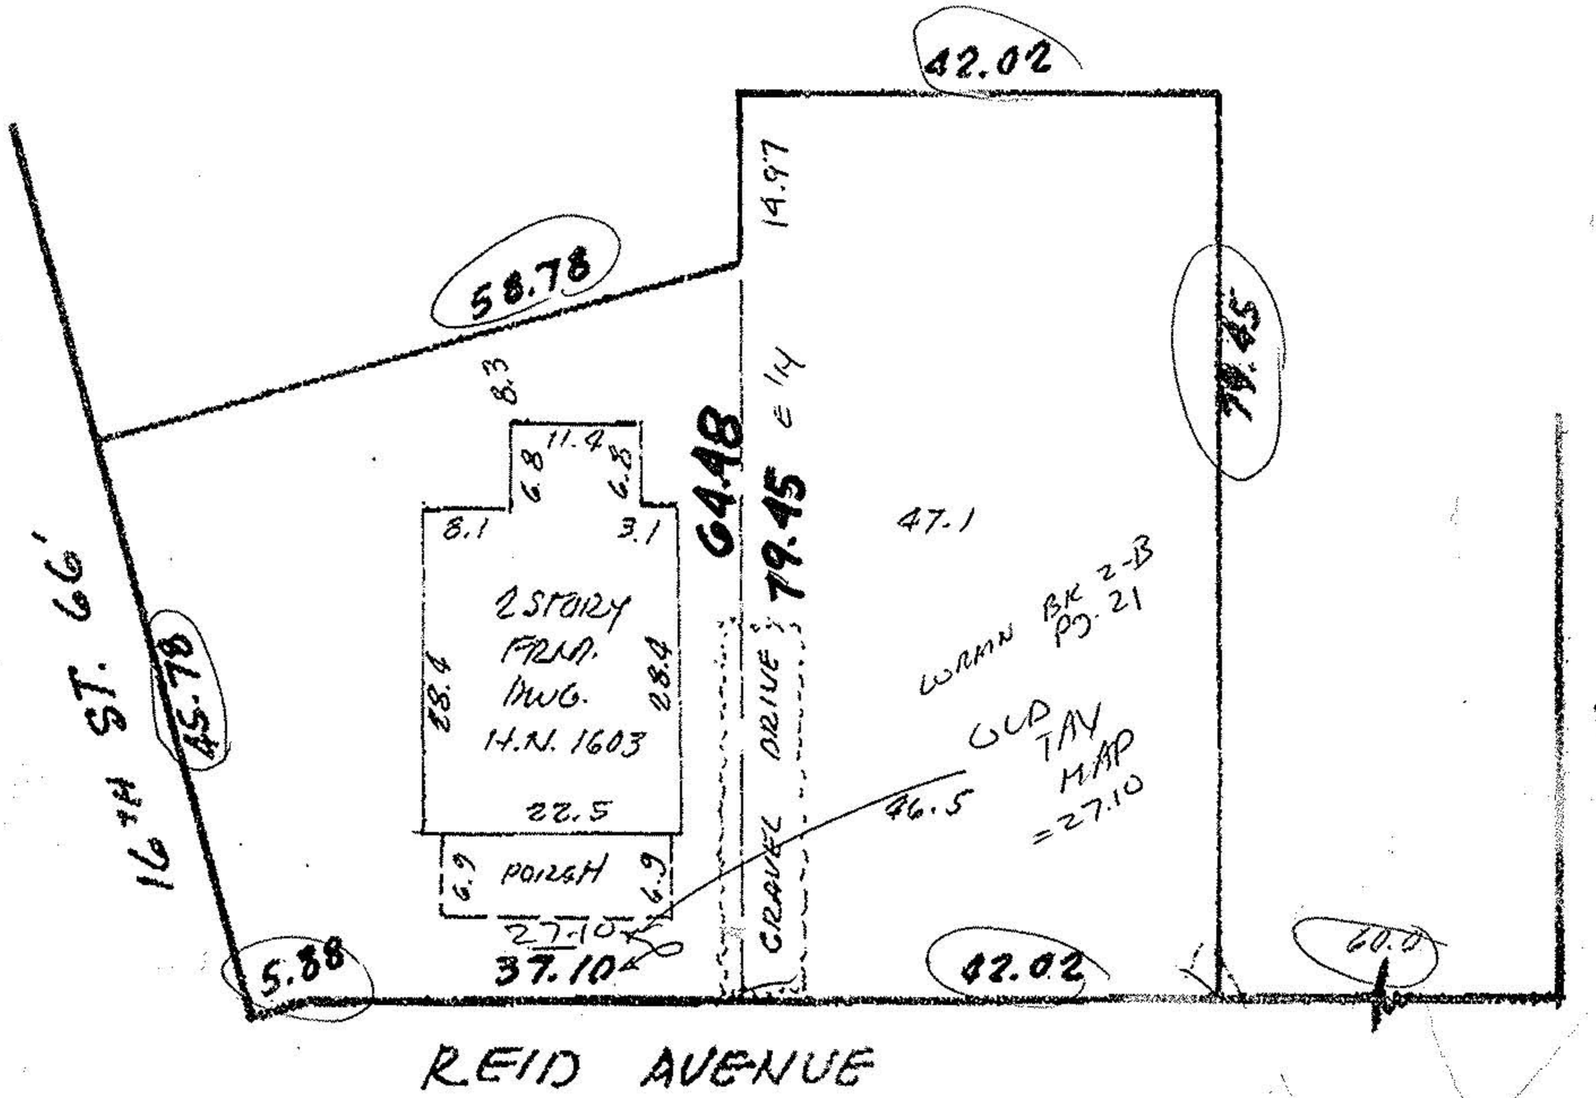

REID AVENUE

MORTGAGE LOAN IDENT. SURVEY

THIS DOES NOT COUNT AS A BOUNDARY SURVEY AS IT IS A (4)