


PLAT OF RESURVEY AND REVISED DESCRIPTION FOR VEARD-JENNA TERRACE LIMITED PARTNERSHIP 21506 CITY OF LORAIN LORAIN COUNTY, OHIO DESCRIPTION Situated in the City of Lorain, County of Lorain and State of Ohio, and being known as that part of Original Black River Township Lot No. 1, Tract 3, bounded Beginning at a 3/4 inch diameter iron pipe found at the intersection of the centerline of Meister Road 21506 with the centerline of Fulmer Road, said point also being a point of the east line of ACREAGE, CLOSURE, AND ERROR OF PLAT 1. Thence South 87d 26'-20" West a distance of 858.52 feet along the northerly line of lands now or formerly owned by Larry L. Liebert, Trustee, as recorded in Official Records Volume 331 Page 359, to a 3/4 inch diameter iron pipe found at the southeasterly corner Deed Volume 1270 Page 256; Line # 20" West 20" West 858.52 feet South 299.31 feet North (26' East 260.15 feet 2. Thence North 1d 46'-20" West a distance of 299.31 feet along the easterly line of East 62.65 feet South 51' said West Lake Gardens Association's lands to a 3/4 inch diameter iron pipe found at the southwesterly corner of lands now or formerly owned by Frank J. Lucas and George Mitoff as recorded in Official Records Volume 750 Page 522; 26′ 28" 387.95 feet East East 136.75 feet South 210.00 feet East 3. Thence North 87d 26'-28" East a distance of 260.15 feet along said Lucas' and Mitoff's 100.00 feet South East lands to a 3/4 inch diameter iron pipe found in the westerly line of lands now or formerly owned by B.T.W. Housing Association, Inc. as recorded in Official Records Volume 331 Page 914; -0.129 feet Easting Error: -0.006 feet Northing Error: 4. Thence South 1d 51'-02" East a distance of 62.65 feet along said B.T.W. Housing Association, Inc's. westerly line to a 3/4 inch diameter iron pipe found at the southwest corner of said lands; 0.129 feet Total Traverse: 2.315.3 feet Gap in Closure: Precision: 0.56 feet error per 10,000 feet traverse. 5. Thence North 87d 26'-28" East a distance of 387.95 feet along the southerly line of said B.T.W. Housing Association, Inc's. lands to a 3/4 inch diameter iron pipe found in the westerly line of lands now or formerly owned by William M. and Angela Neely as recorded in Deed Volume 606 Page 183; Area: 4.378 acres - - 190,687 square feet. 6. Thence South 1d 51'-02" East a distance of 136.75 feet along the westerly line of said Neely's lands to a 3/4 inch diameter iron pipe found at the southwest cornerly of RUN BY T. HOLLIS 7. Thence North 87d 26'-28" East a distance of 210.00 feet along the southerly line of said Neely's lands to a P.K. nail and shiner found in the centerline of Fulmer Road, and passing through a 3/4 inch diameter iron pipe found 30.00 feet west of the centerline of Fulmer Road; 9/13/95 @12120 Scale: 400 feet per inch. 8. Thence South 1d 51'-02" East a distance of 100.00 feet along the centerline of Fulmer Road to the place of beginning and containing 190,692 square feet or 4.3777 acres of land more or less but subject to all legal rights of way and easements of record. All bearings are to an assumed meridian and are for the purpose of describing angles only.
This description was prepared from a field survey by Earl H. Hunter, P.S. #7537 in September 1995. The premises described herein are the same as described as the conveyance to Jon R. Veard and Joy I. Veard by deed as recorded in Lorain County Official Records PRIOR DEED REFERENCE: O.R. 1036 PG. 142
PERMANENT PARCEL NUMBERS: 02-03-001-108-031

> EARL H. HUNTER S-7537

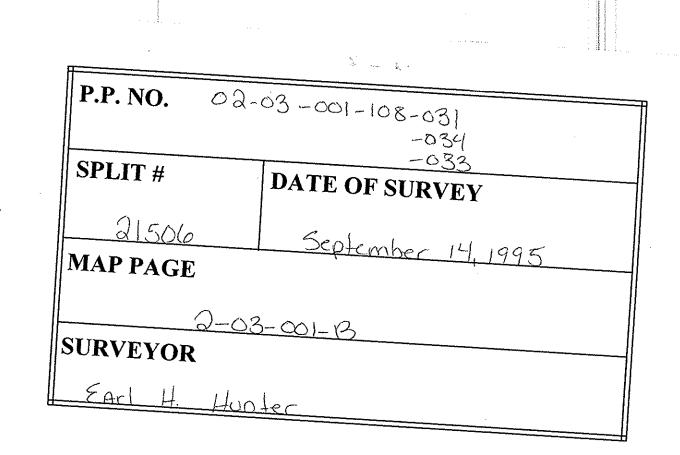

## DESCRIPTION

Situated in the City of Lorain, County of Lorain and State of Ohio, and being known as that part of Original Black River Township Lot No. 1, Tract 3, bounded and described as follows:

Beginning at a 3/4 inch diameter iron pipe found at the intersection of the centerline of Meister Road with the centerline of Fulmer Road, said point also being a point of the east line of Original Lot 1:

1. Thence South 87d 26'-20" West a distance of 858.52 feet along the northerly line of lands now or formerly owned by Larry L. Liebert, Trustee, as recorded in Official Records Volume 331 Page 359, to a 3/4 inch diameter iron pipe found at the southeasterly corner of lands now or formerly owned by West Lake Gardens Association as recorded in Deed Volume 1270 Page 256;

2. Thence North 1d 46'-20" West a distance of 299.31 feet along the easterly line of

4. Thence South 1d 51'-02" East a distance of 62.65 feet along said B.T.W. Housing Association, Inc's. westerly line to a 3/4 inch diameter iron pipe found at the southwest corner of said lands;

5. Thence North 87d 26'-28" East a distance of 387.95 feet along the southerly line of said B.T.W. Housing Association, Inc's. lands to a 3/4 inch diameter iron pipe found in the westerly line of lands now or formerly owned by William M. and Angela Neely as recorded in Deed Volume 606 Page 183;

6. Thence South 1d 51'-02" East a distance of 136.75 feet along the westerly line of said Neely's lands to a 3/4 inch diameter iron pipe found at the southwest cornerly of said lands;

7. Thence North 87d 26'-28" East a distance of 210.00 feet along the southerly line of said Neely's lands to a P.K. nail and shiner found in the centerline of Fulmer Road, and passing through a 3/4 inch diameter iron pipe found 30.00 feet west of the centerline of Fulmer Road;

8. Thence South 1d 51'-02" East a distance of 100.00 feet along the centerline of Fulmer Road to the place of beginning and containing 190,692 square feet or 4.3777 acres of land more or less but subject to all legal rights of way and easements of record. All bearings are to an assumed meridian and are for the purpose of describing angles only. This description was prepared from a field survey by Earl H. Hunter, P.S. #7537 in September 1995. The premises described herein are the same as described in the conveyance to Jon R. Veard and Joy I. Veard by deed as recorded in Lorain County Official Records Volume1036 Page 142.

PRIOR DEED REFERENCE: O.R. 1036 PG. 142 PERMANENT PARCEL NUMBERS: 02-03-001-108-031



THIS IS REVISION AS OF 9/13/95