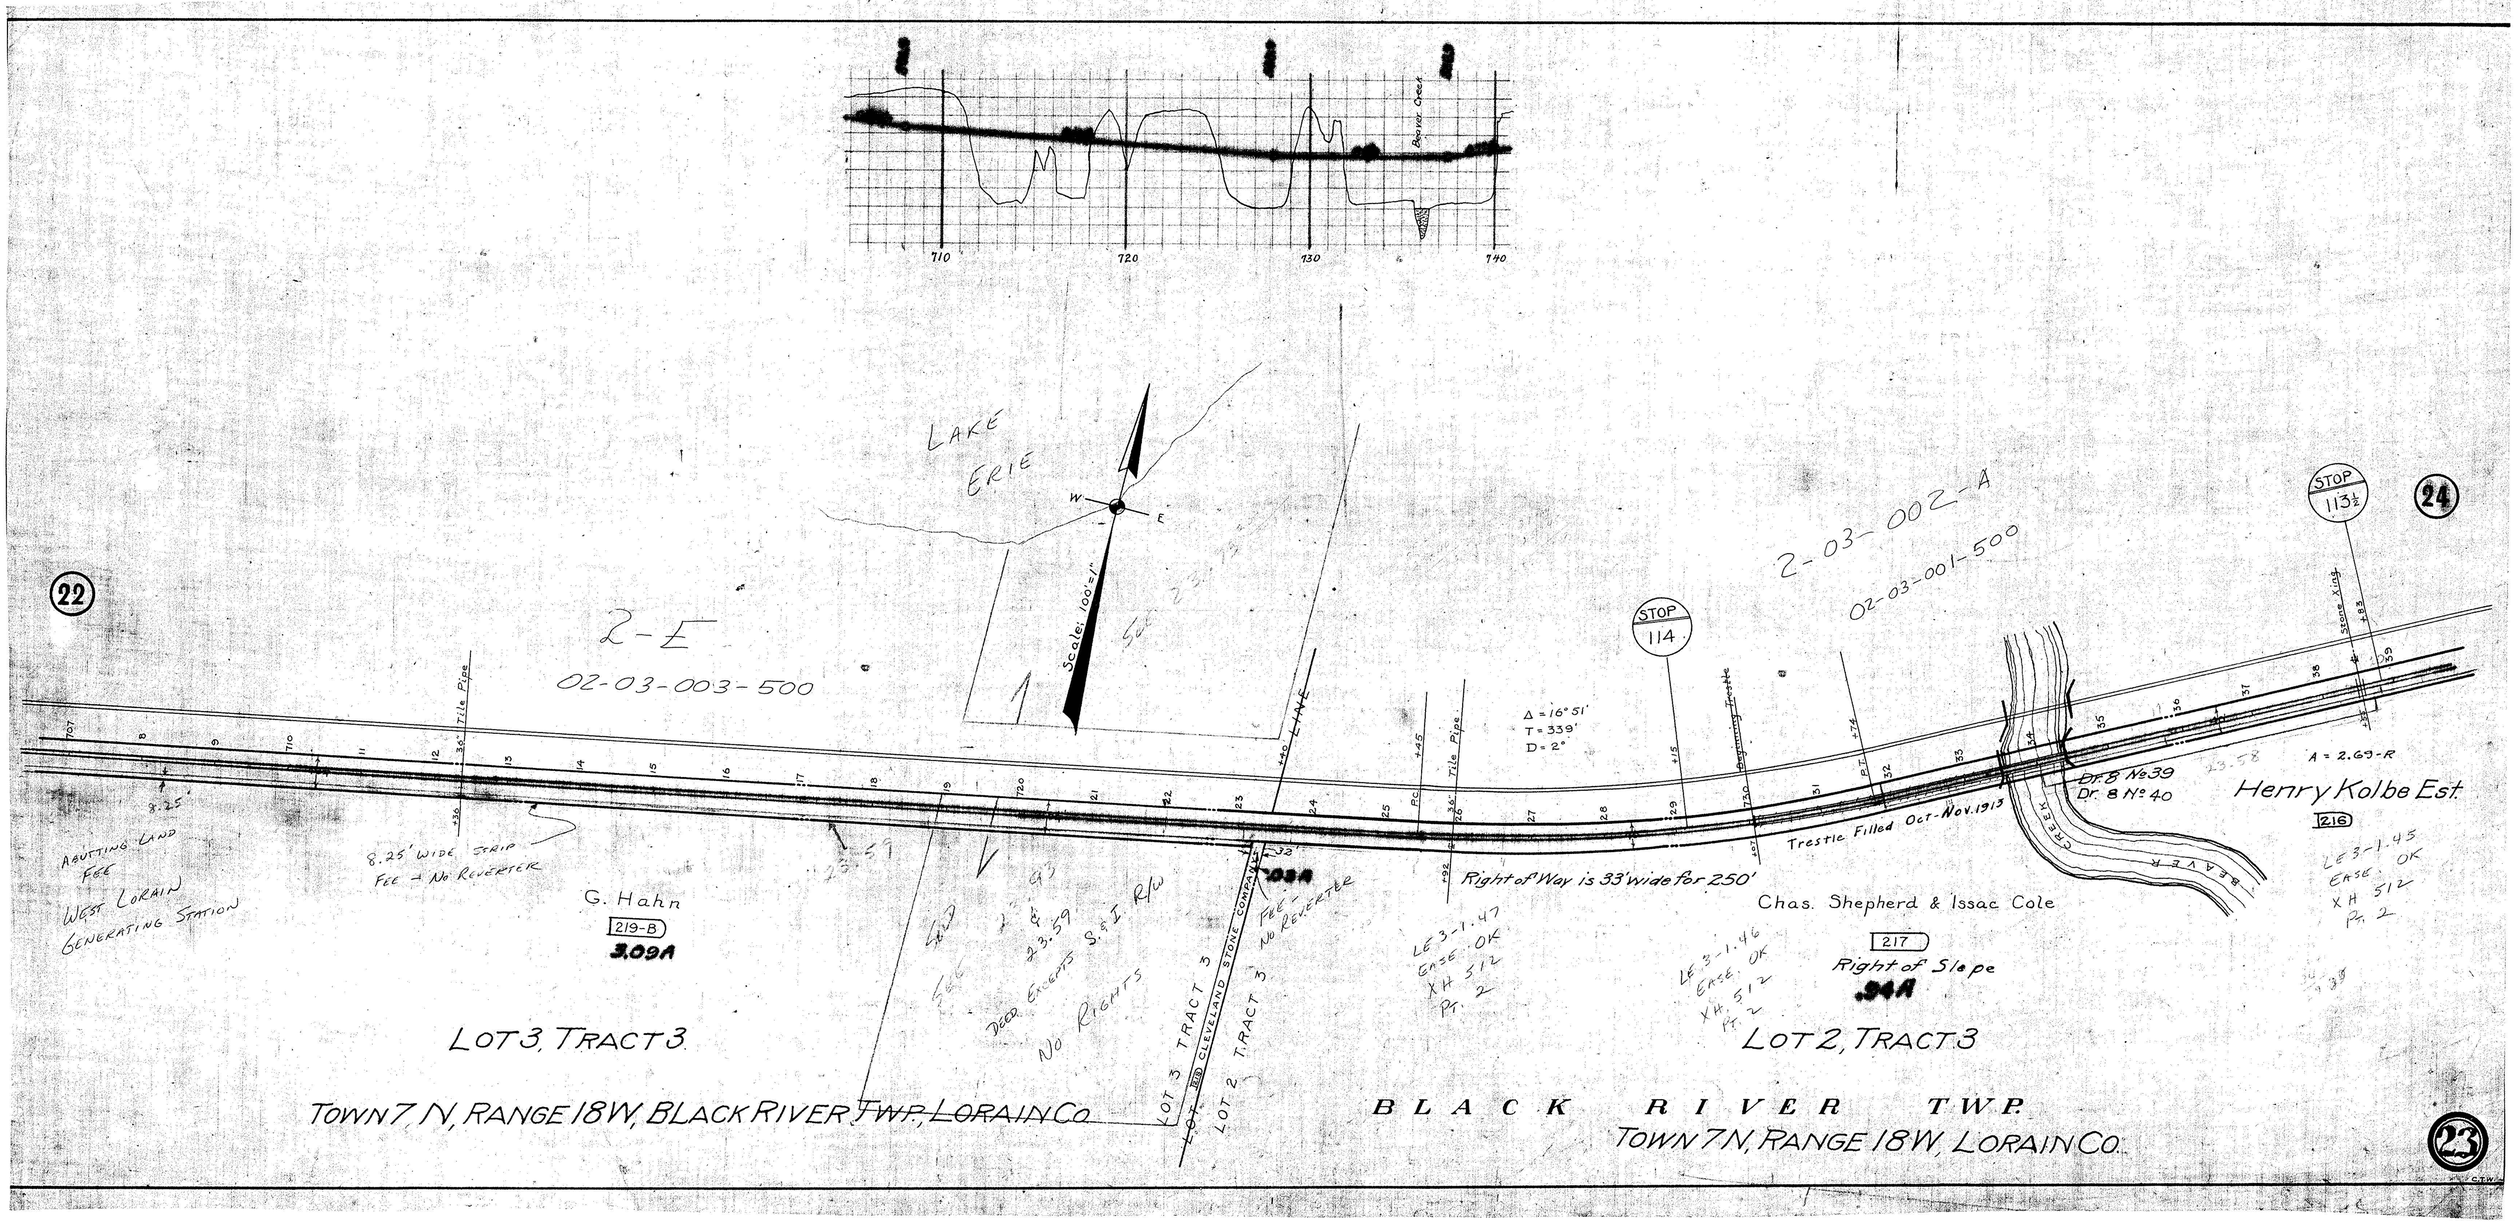
710
720
730
740
Approx. Grade
LAKE ERIE
W
E
Scale: 100'=1"
22
24
23
2-E
02-03-003-500
2-03-002-A
02-03-001-500
STOP 114
STOP 113½
Tile Pipe
Scaffolding Trestle
Stone King
Δ = 16° 51'
T = 339'
D = 2°
A = 2.69-R
Dr. 8 No. 39
Dr. 8 No. 40
Henry Kolbe Est.
216
LE 3-1.45
EASE. OK
XH 512
Pt. 2
Trestle Filled Oct-Nov. 1913
BEAVER CREEK
Right of Way is 33' wide for 250'
ABUTTING LAND FEE
WEST LORAIN GENERATING STATION
8.25' WIDE STRIP FEE - No REVERTER
G. Hahn
219-B
3.09A
DEED EXCEPTS S.&I R/W
NO RIGHTS
LOT 3 TRACT 3
LOT 2 TRACT 3
THE CLEVELAND STONE COMPANY
FEE - No REVERTER
LE 3-1.47
EASE. OK
XH 512
Pt. 2
LE 3-1.46
EASE. OK
XH 512
Pt. 2
Chas. Shepherd & Issac Cole
217
Right of Slope
.94A
LOT 3, TRACT 3
LOT 2, TRACT 3
TOWN 7 N, RANGE 18 W, BLACK RIVER ~~TWP, LORAIN CO~~
BLACK RIVER TWP.
TOWN 7 N, RANGE 18 W, LORAIN CO.