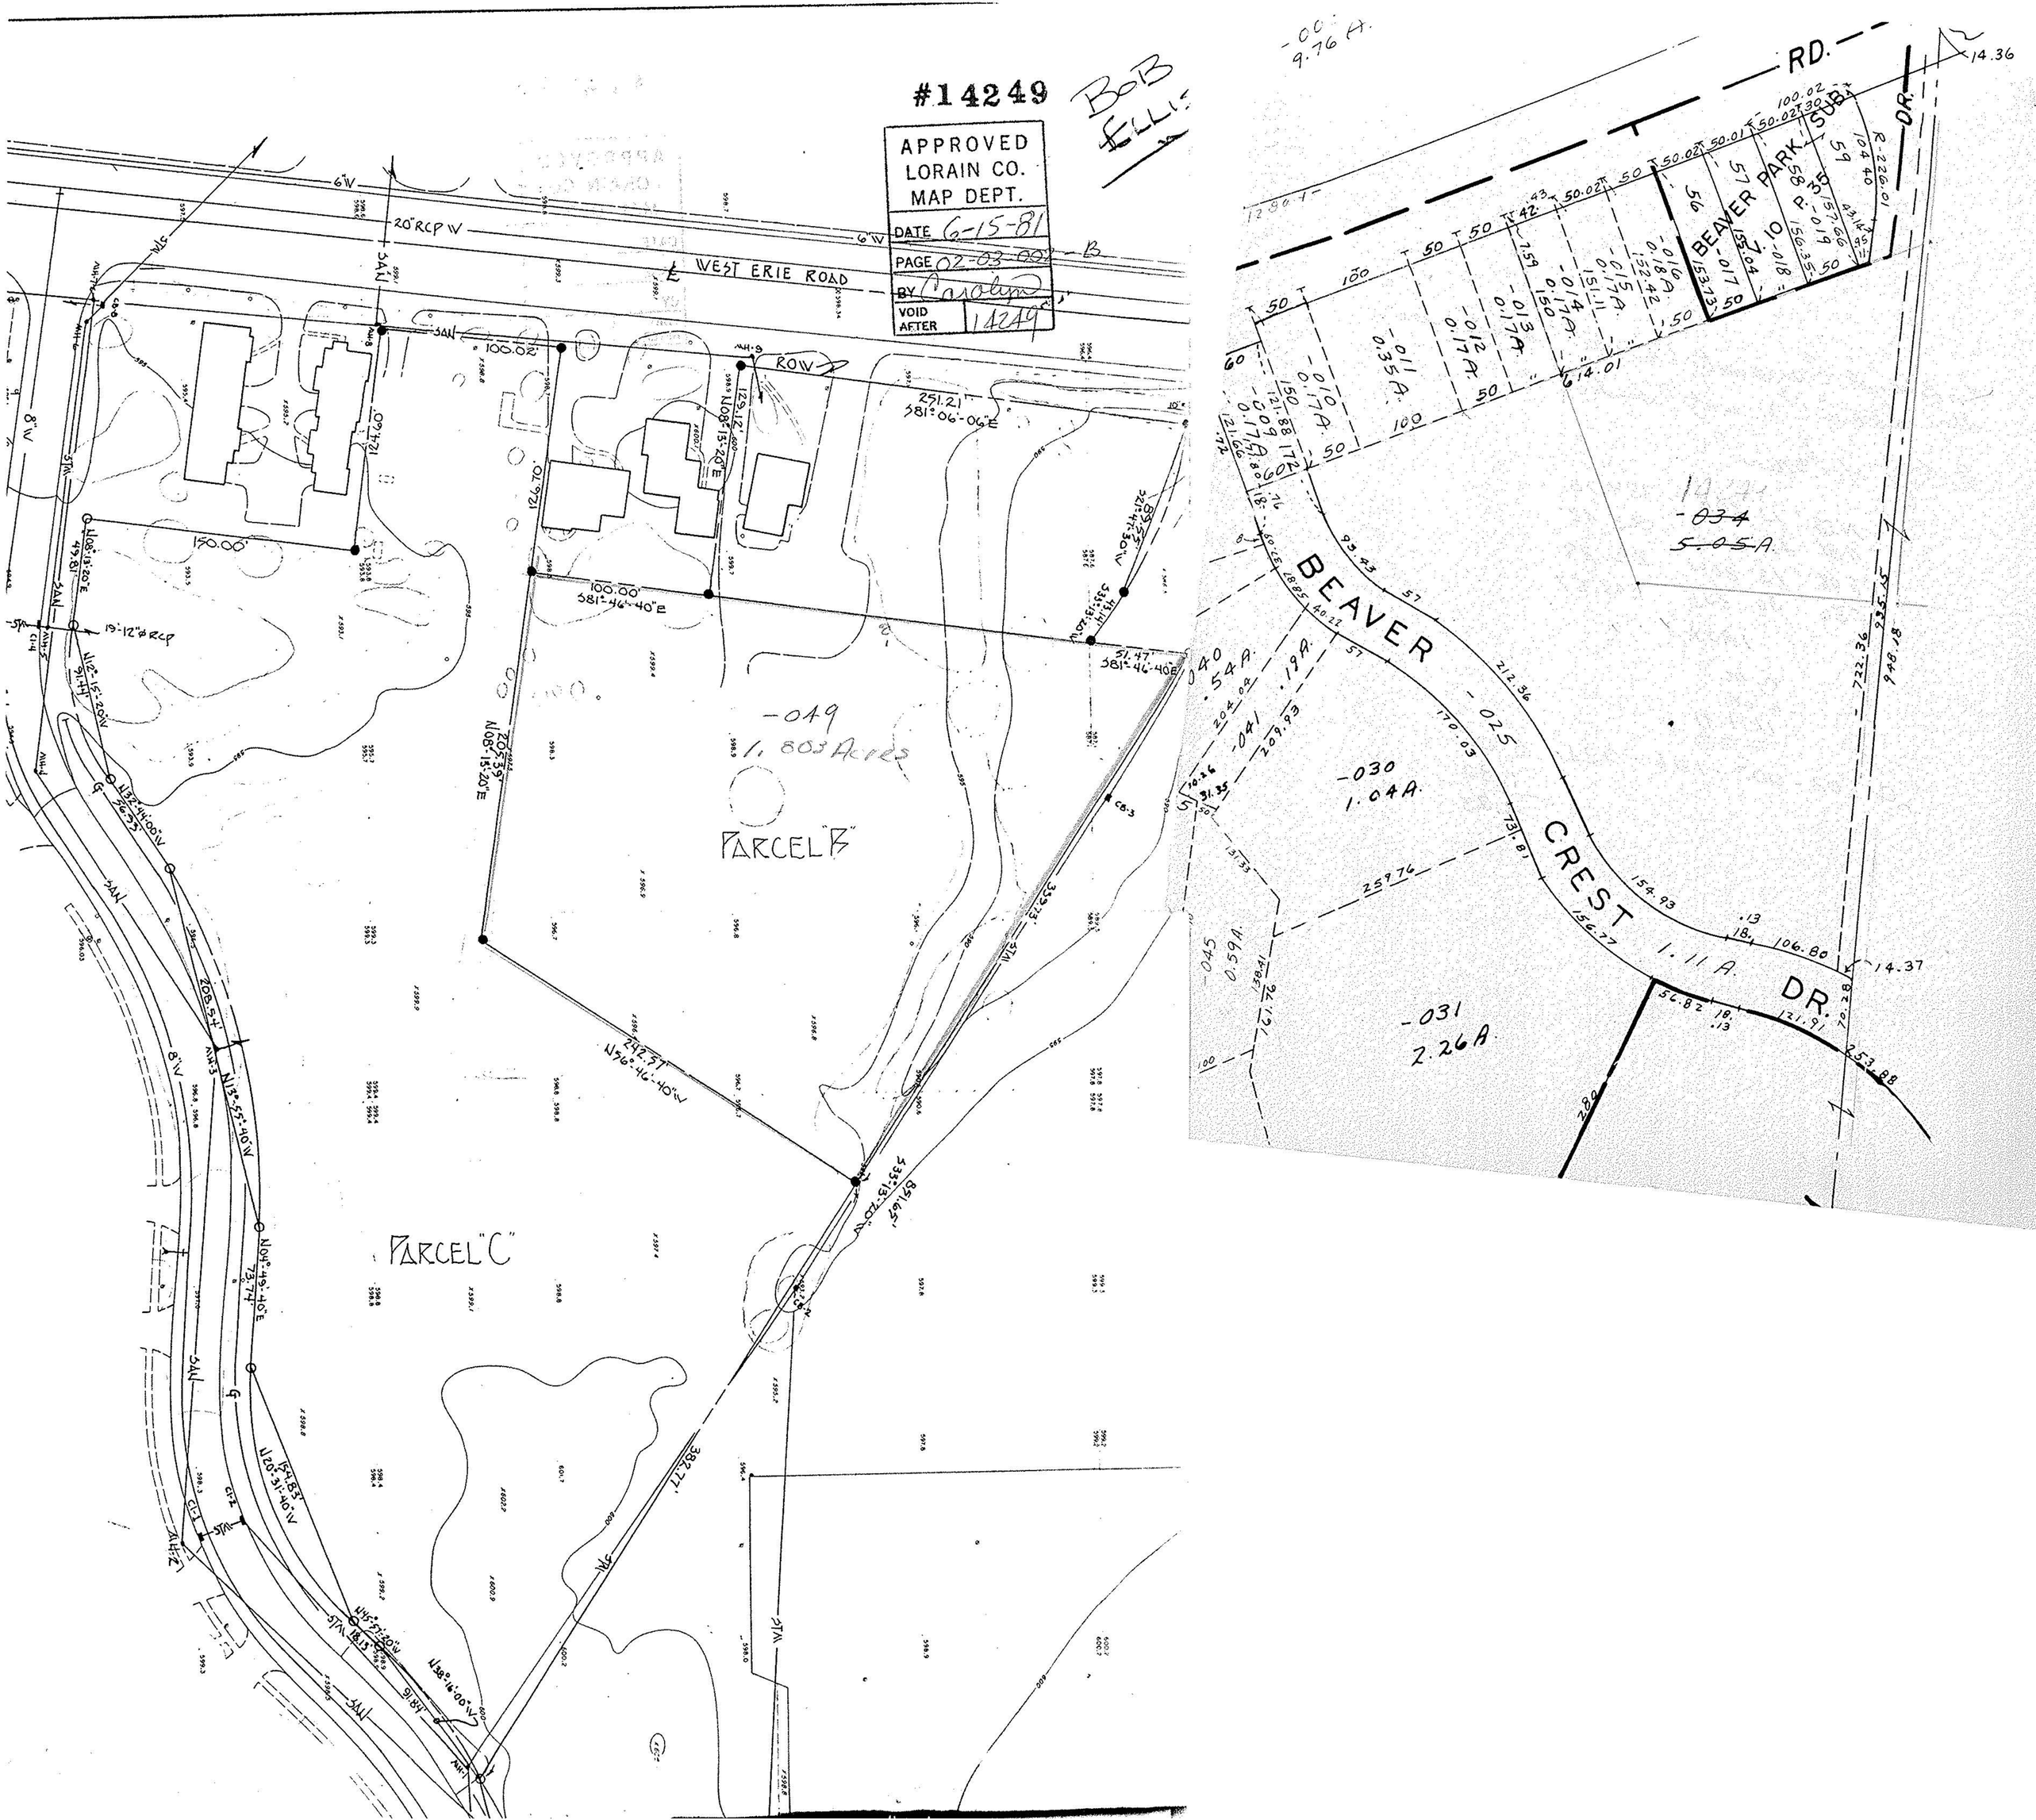
#14249
APPROVED
LORAIN CO.
MAP DEPT.
DATE 6-15-81
PAGE 02-03-002-B
BY Carolyn
VOID AFTER 14249
BOB ELLIS
WEST ERIE ROAD
20" RCP W
ROW
PARCEL "B"
PARCEL "C"
-049
1.803 Acres
BEAVER PARK SUB.
V. 10 P. 35
BEAVER CREST DR.
-030
1.04A.
-031
2.26A.
-034
5.05A.
-045
0.59A.
-025
1.11 A.
RD.
DR.