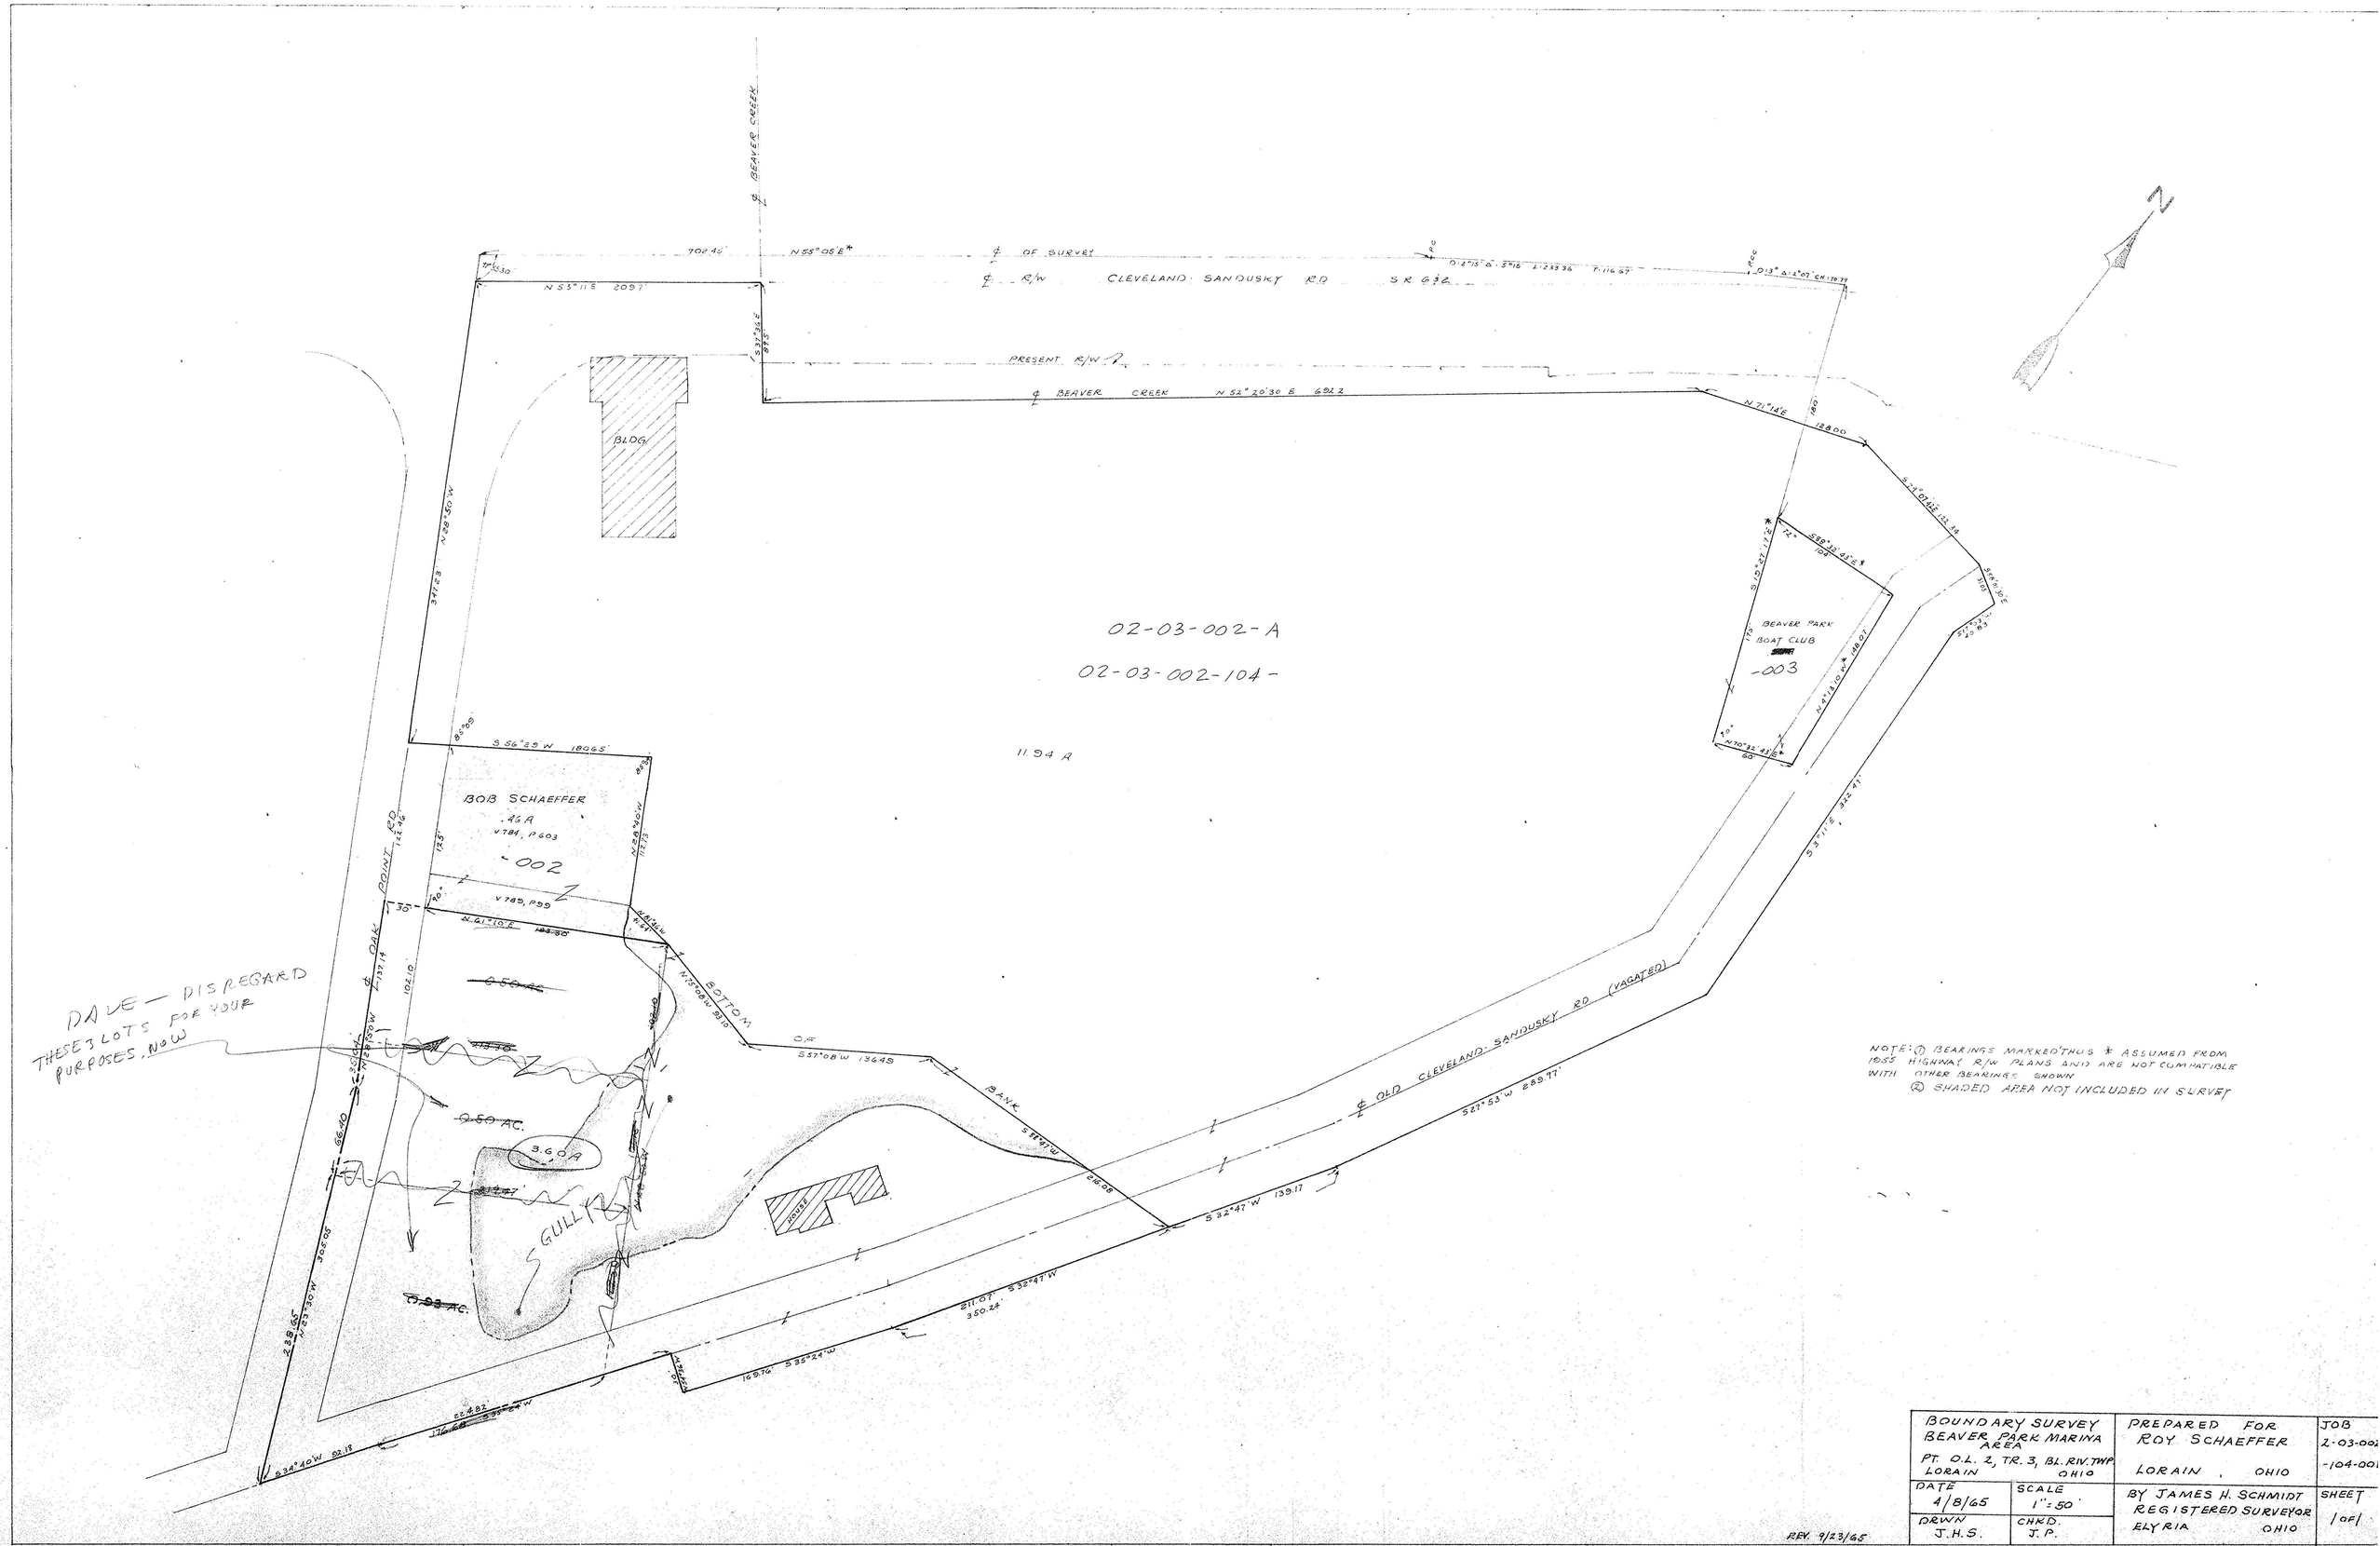

NOTE: ① BEARINGS MARKED THUS * ASSUMED FROM 1955 HIGHWAY R/W PLANS AND ARE NOT COMPATIBLE WITH OTHER BEARINGS SHOWN
② SHADED AREA NOT INCLUDED IN SURVEY

BOUNDARY SURVEY BEAVER PARK MARINA AREA PT. O.L. 2, T.R. 3, BL. RIV. TWP LORAIN OHIO		PREPARED FOR ROY SCHAEFFER LORAIN, OHIO	JOB 2-03-002 -104-001
DATE 4/8/65	SCALE 1" = 50'	BY JAMES H. SCHMIDT REGISTERED SURVEYOR ELYRIA OHIO	SHEET 1 of 1
DRWN J.H.S.	CHKD. J.P.		

REV. 9/23/65