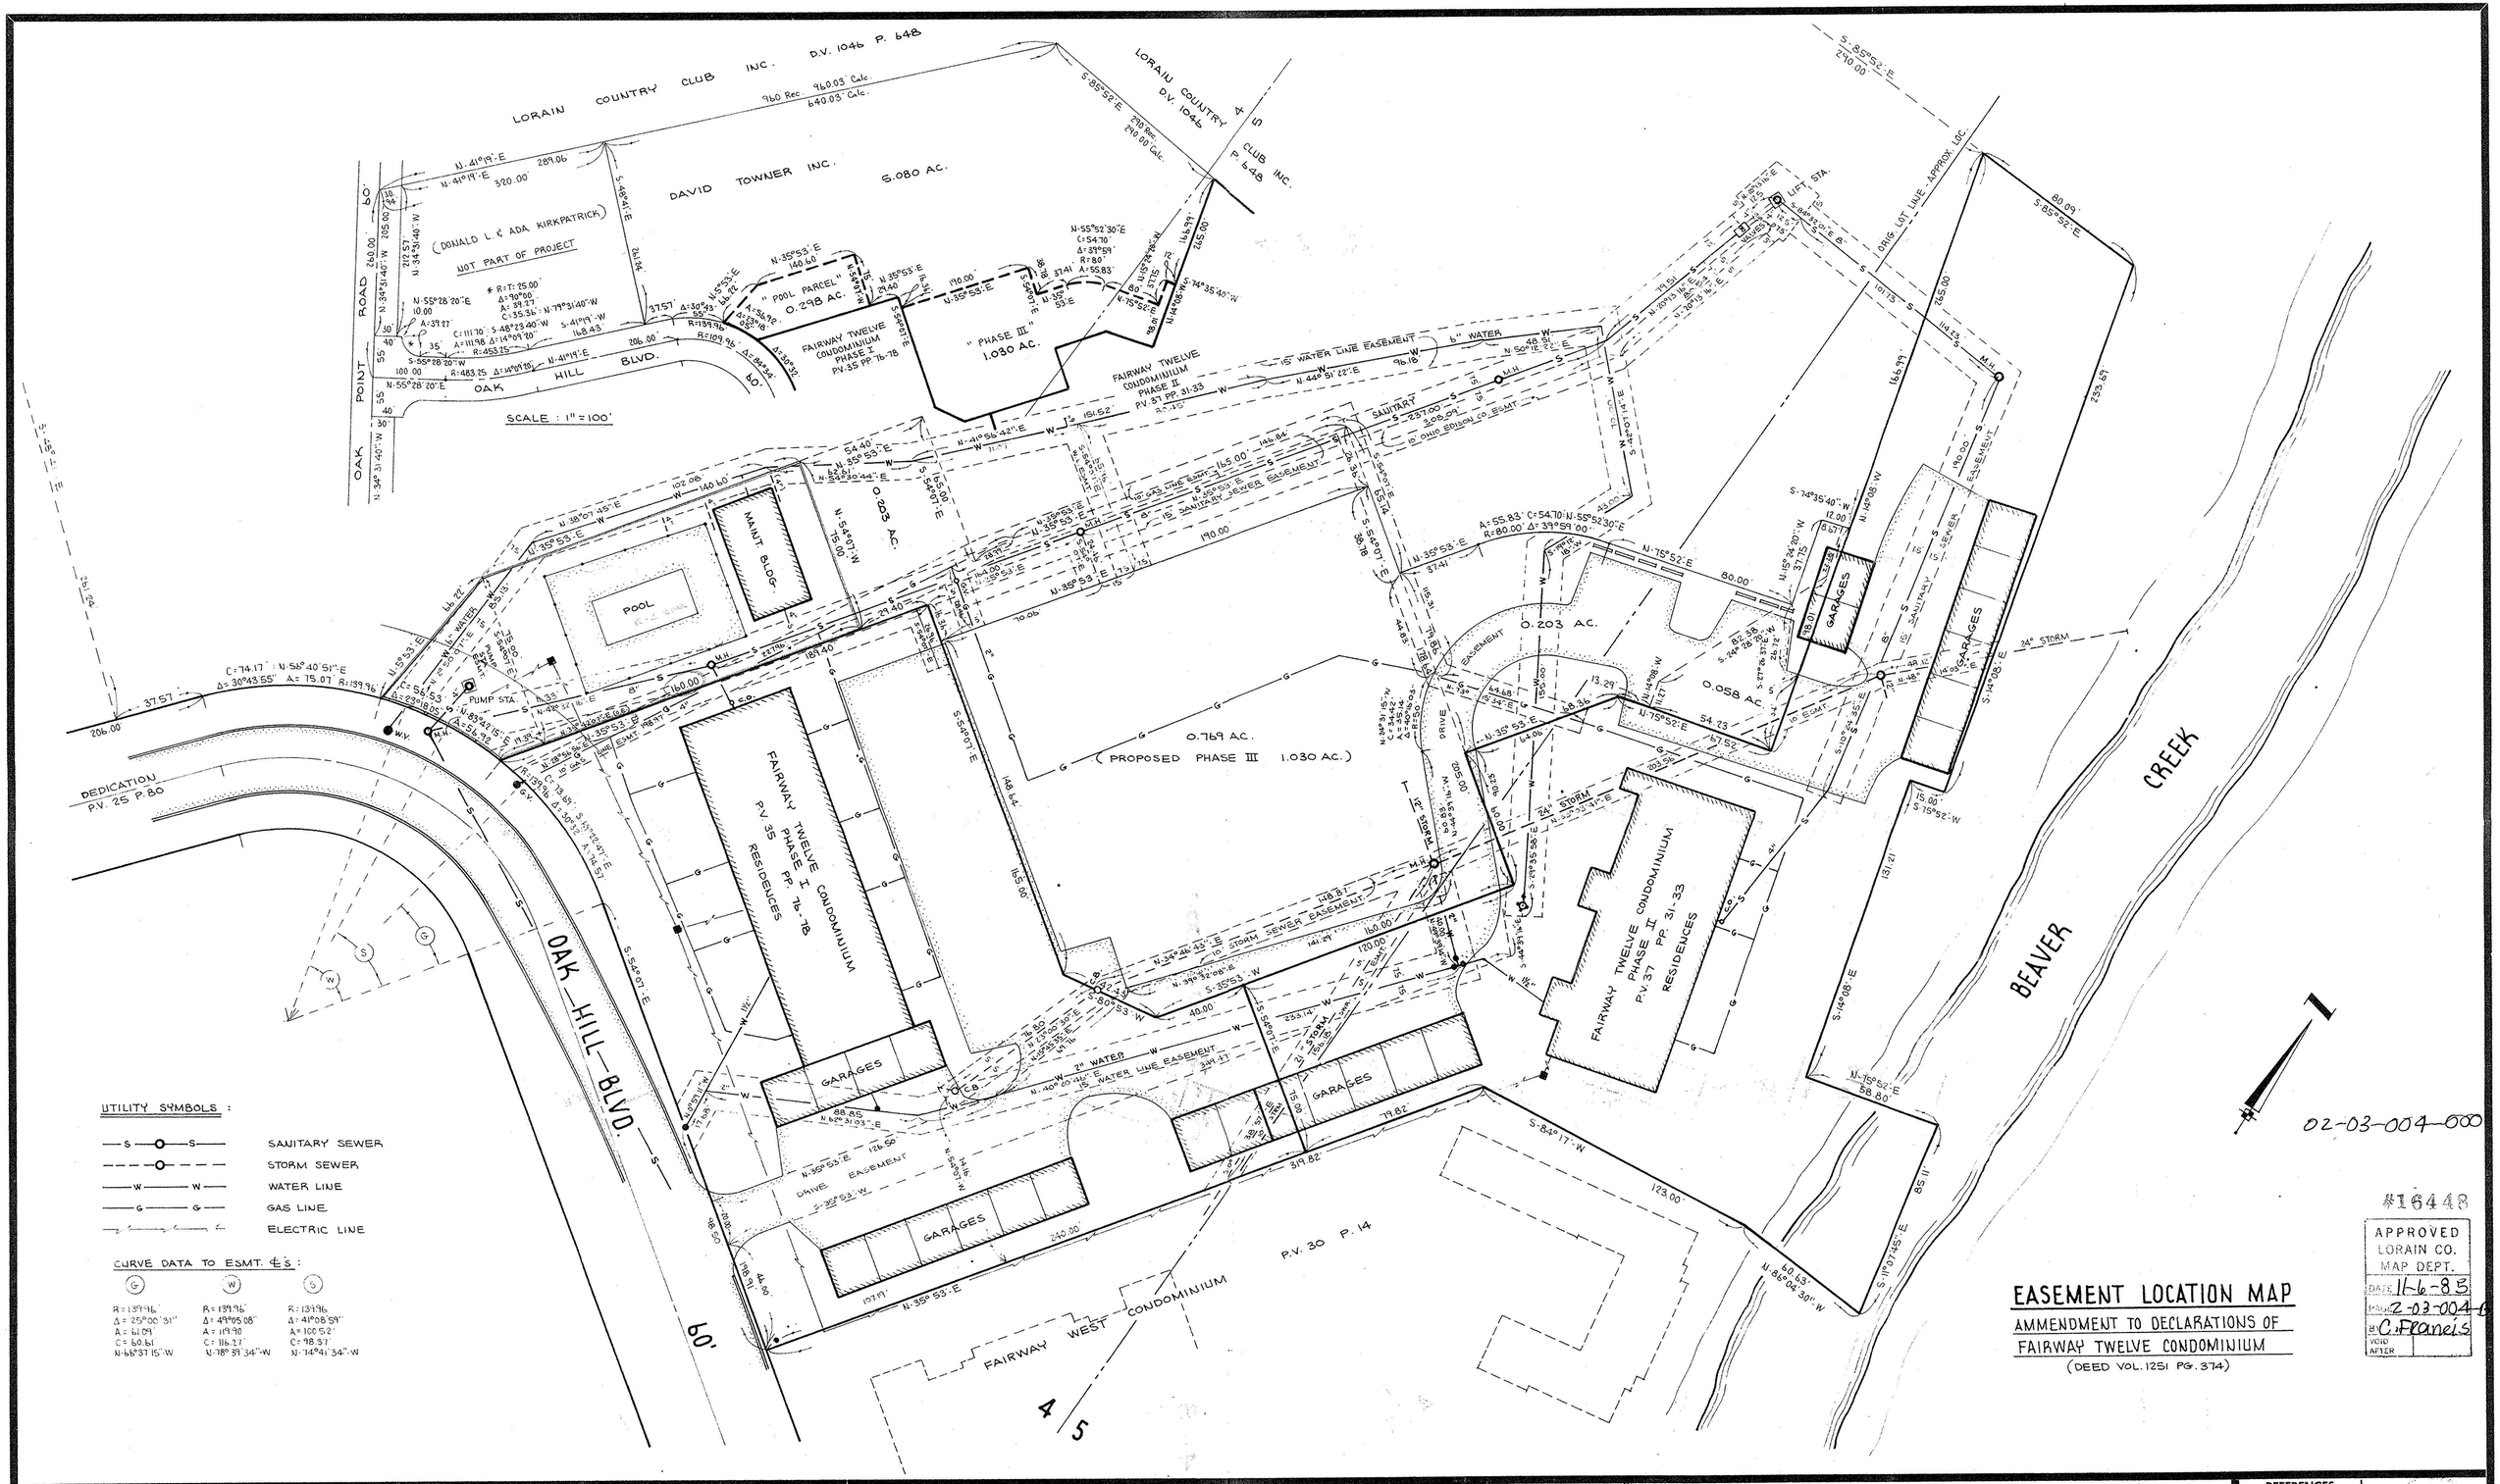

EASEMENT LOCATION MAP

AMMENDMENT TO DECLARATIONS OF FAIRWAY TWELVE CONDOMINIUM

(DEED VOL. 1251 PG. 374)

No.	Date	Description	By

REVISIONS

PROJECT

BOUNDARY & LOCATION SURVEY OF

PART OF BLACK RIVER TOWNSHIP ORIG. LOTS 4 & 5 - TR. 3

CITY OF LORAIN — COUNTY OF LORAIN — STATE OF OHIO

PREPARED FOR:

BROADVIEW SAVINGS & LOAN

6000 ROCKSIDE WOODS BLVD.

CLEVELAND, OHIO 44131

Drawn by: DE

Checked by:

App. by:

Scale: 1" = 30'

Date: SEPT. 25, 1985

KLEINOEDER · SCHMIDT and ASSOCIATES

ENGINEERS — SURVEYORS — CONSULTANTS in LAND PLANNING

ELYRIA - NORWALK - MEDINA — OHIO

REFERENCES

SHEET NO. of

JOB NO. 85-144