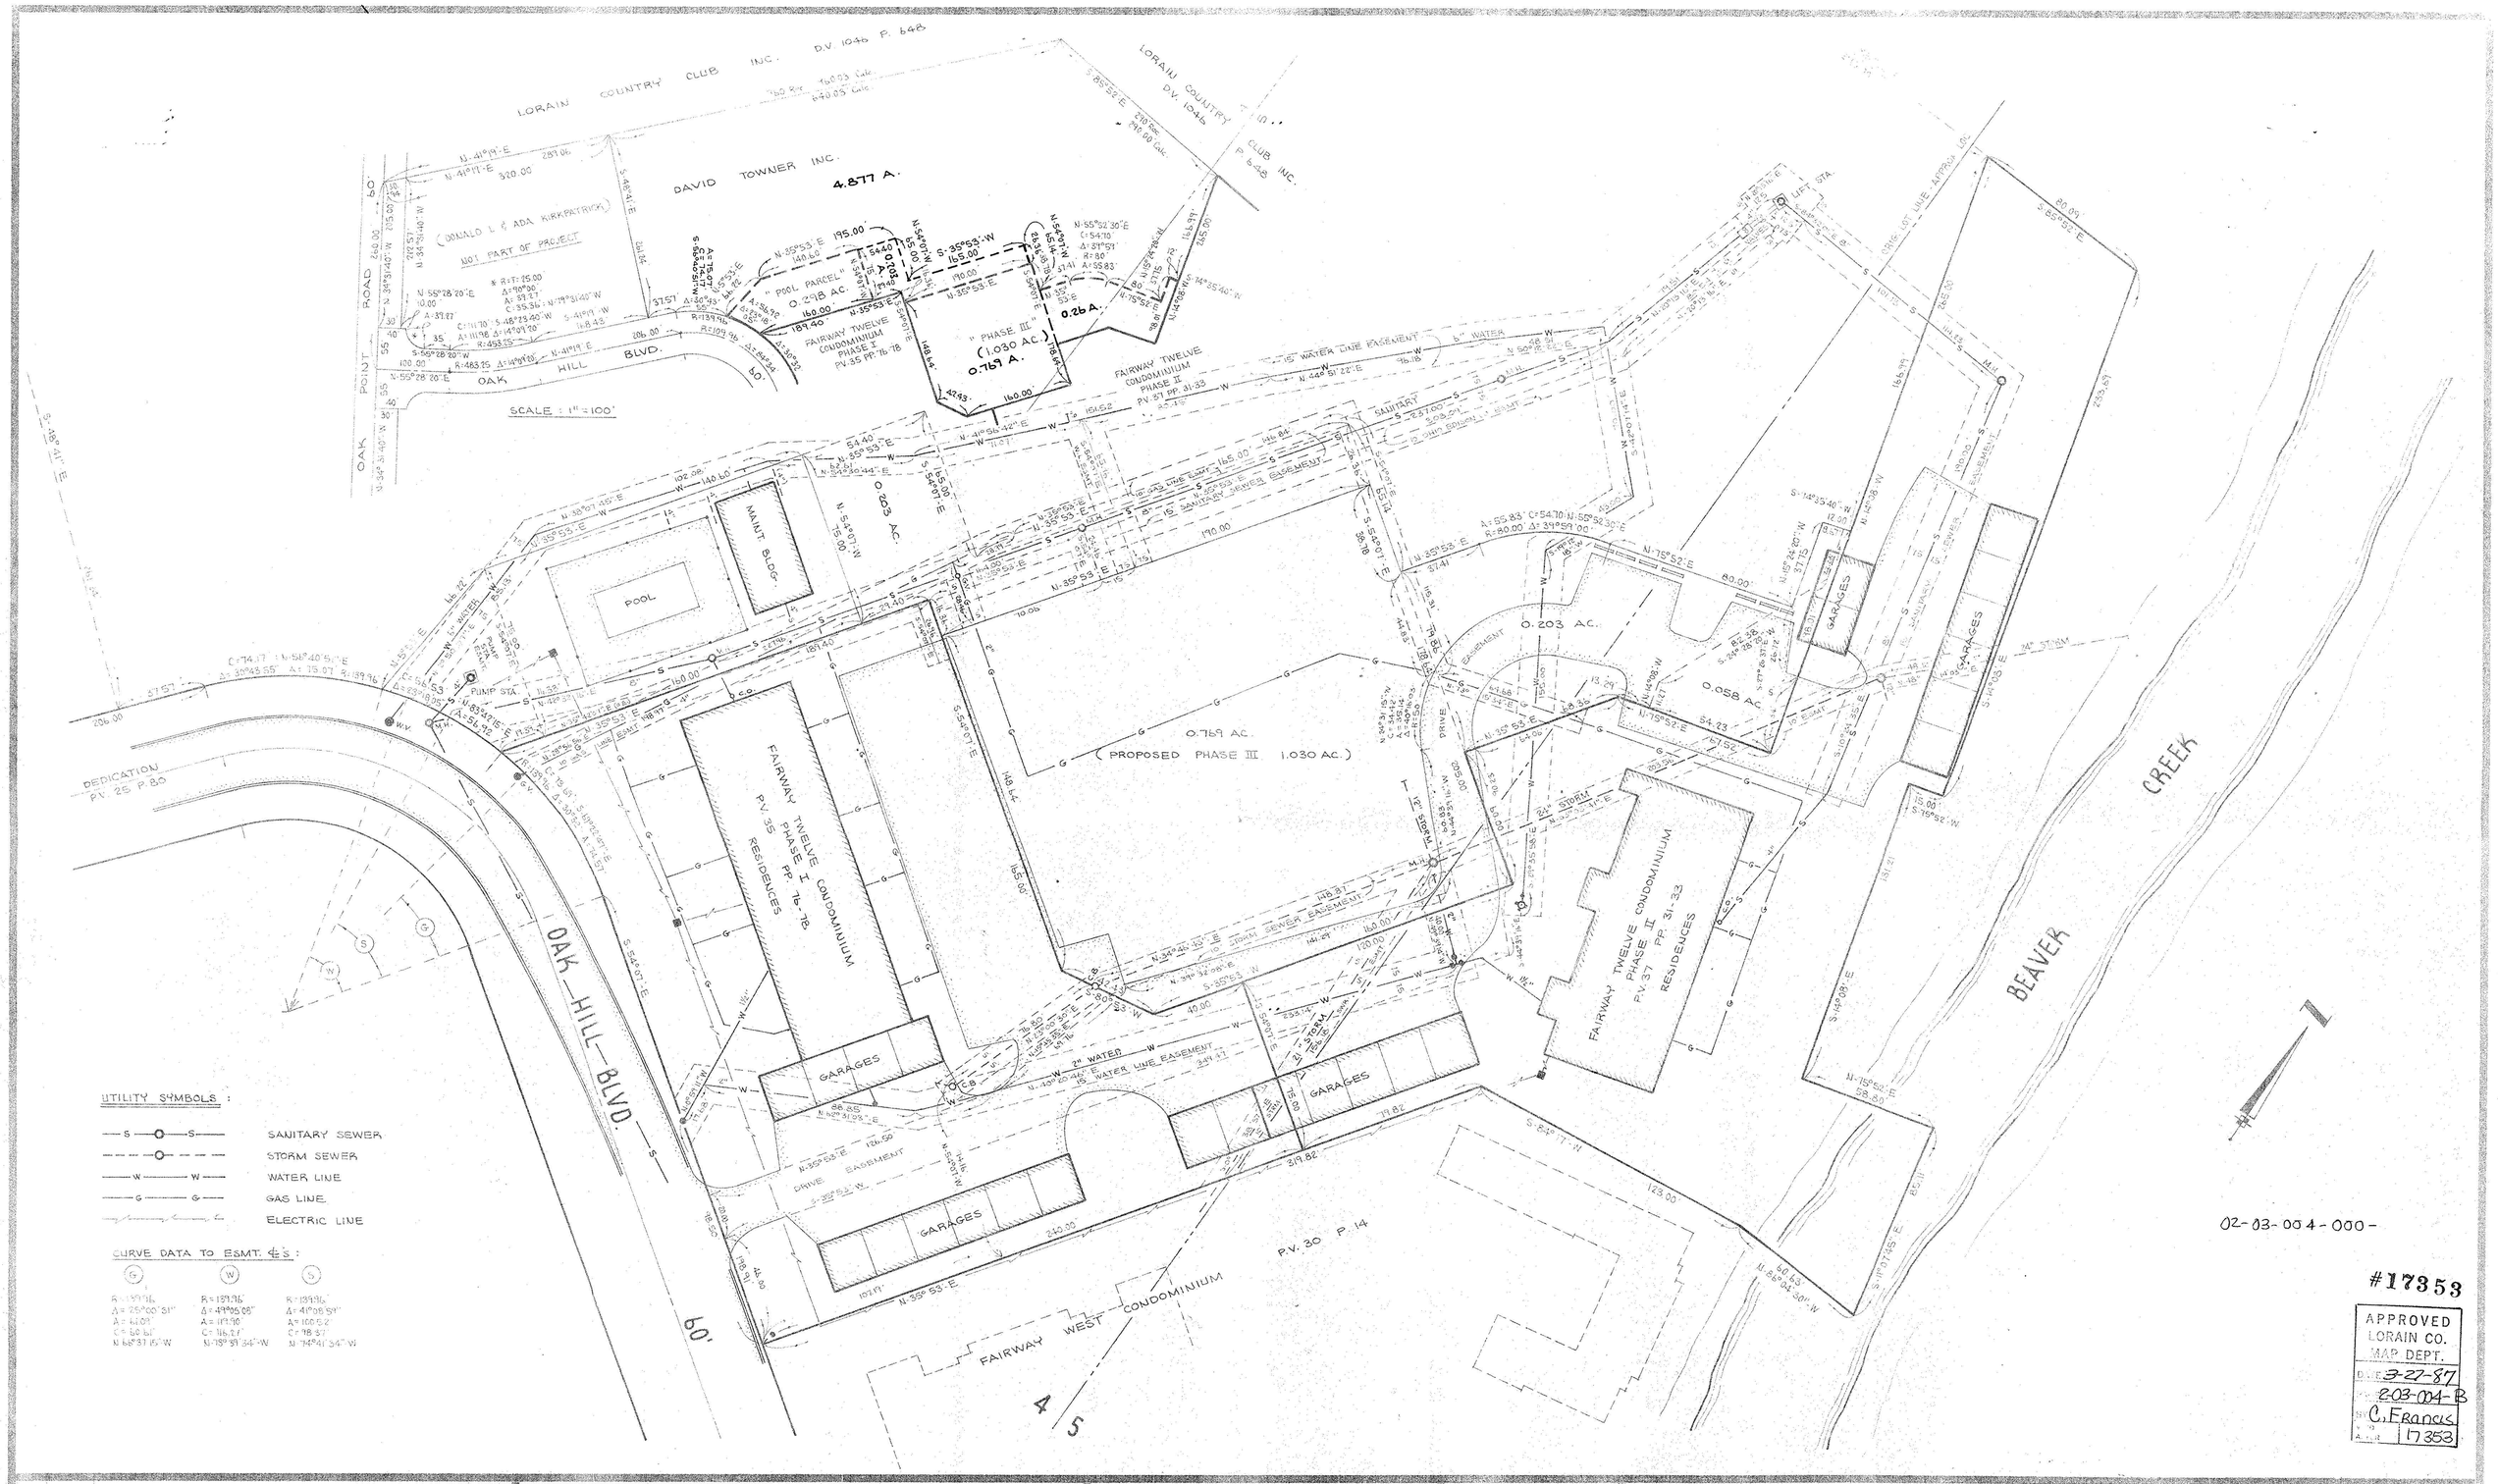

#17353

APPROVED LORAIN CO. MAP DEPT.
DATE 3-27-87
203-004-B
C. Francis
17353

No.	Date	Description	By
	3-19-87	ADD REMAINDER DATA	D.E.

REVISIONS

PROJECT

BOUNDARY & LOCATION SURVEY OF

PART OF BLACK RIVER TOWNSHIP ORIG. LOTS 4 & 5 - TR. 3

CITY OF LORAIN — COUNTY OF LORAIN — STATE OF OHIO

PREPARED FOR:

BROADVIEW SAVINGS & LOAN
6000 ROCKSIDE WOODS BLVD.
CLEVELAND, OHIO 44131

Drawn by: DE
Checked by:
App. by:
Scale: 1" = 30'
Date: SEPT. 25, 1985

KLEINOEDER · SCHMIDT and ASSOCIATES

ENGINEERS — SURVEYORS — CONSULTANTS in LAND PLANNING

ELYRIA - NORWALK - MEDINA — OHIO

REFERENCES

SHEET NO. of

JOB NO. 85-144