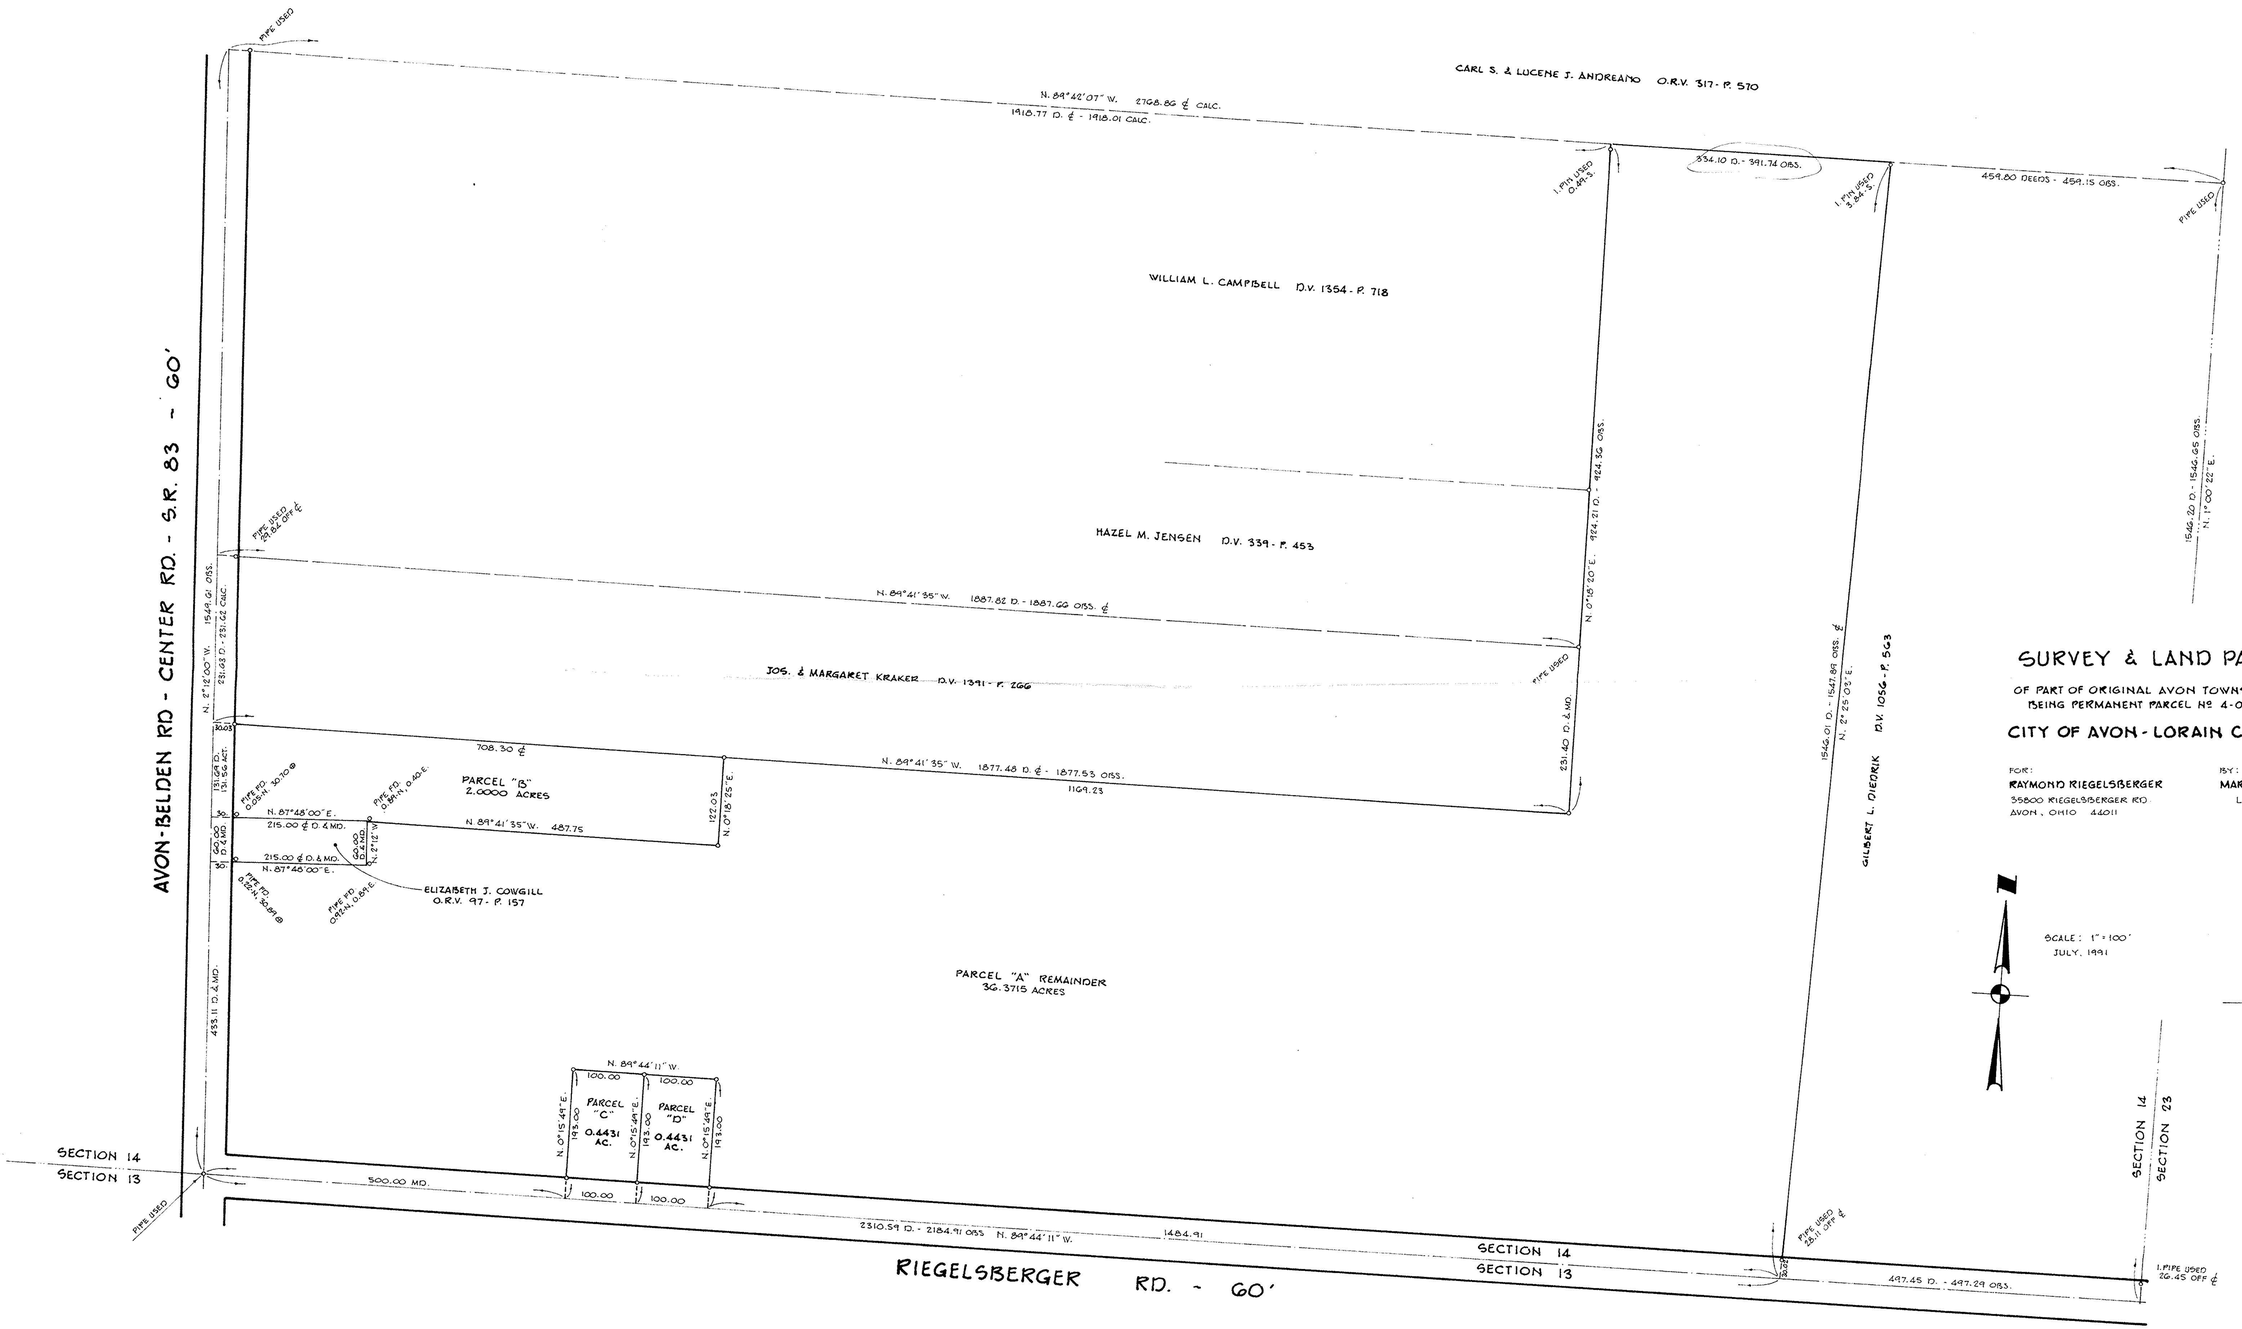

SURVEY & LAND PARTITION

OF PART OF ORIGINAL AVON TOWNSHIP SECTION 14
BEING PERMANENT PARCEL Nº 4-00-014-107-025

CITY OF AVON - LORAIN COUNTY - OHIO

FOR:
RAYMOND RIEGELSBERGER
35800 RIEGELSBERGER RD
AVON, OHIO 44011

BY:
MARTINI & ASSOCIATES
LAND SURVEYORS
AVON, OHIO

STATE OF OHIO
ROBERT D. MARTINI
5139
REGISTERED SURVEYOR

RECEIVED
SEP 9 1991
Avon Planning Commission

#19688

APPROVED
LORAIN CO.
MAP DEPT.
DATE 12-4-91
PAGE 4-00-014-G
BY T. McMan
VOID AFTER 1996

⊗ INDICATES IRON PIN SET UNLESS NOTED OTHERWISE.