

871.20' DUE NORTH O.L. 9
O.L. 16

JIM D. + KATHLEEN A. HASTINGS
2.00 ACRES DEED V. 1143 P. 873

THURMAN E. + LINDA L. KNIGHT
2.00 ACRES DEED V. 1164 P. 608



MALVIN D. + JEANNE S. BISHOP
2.00 ACRES DEED V. 1132 P. 358

PARCEL #1 0.759 AC.
PARCEL #2 0.935 ACRES

HARRY E. BARELKA
DEED VOL. 794 P. 44

#16262
APPROVED
LORAIN CO.
MAP DEPT.

DATE 7.9.85
PAGE 4.00.016. A + E
BY T. McMain
VOID

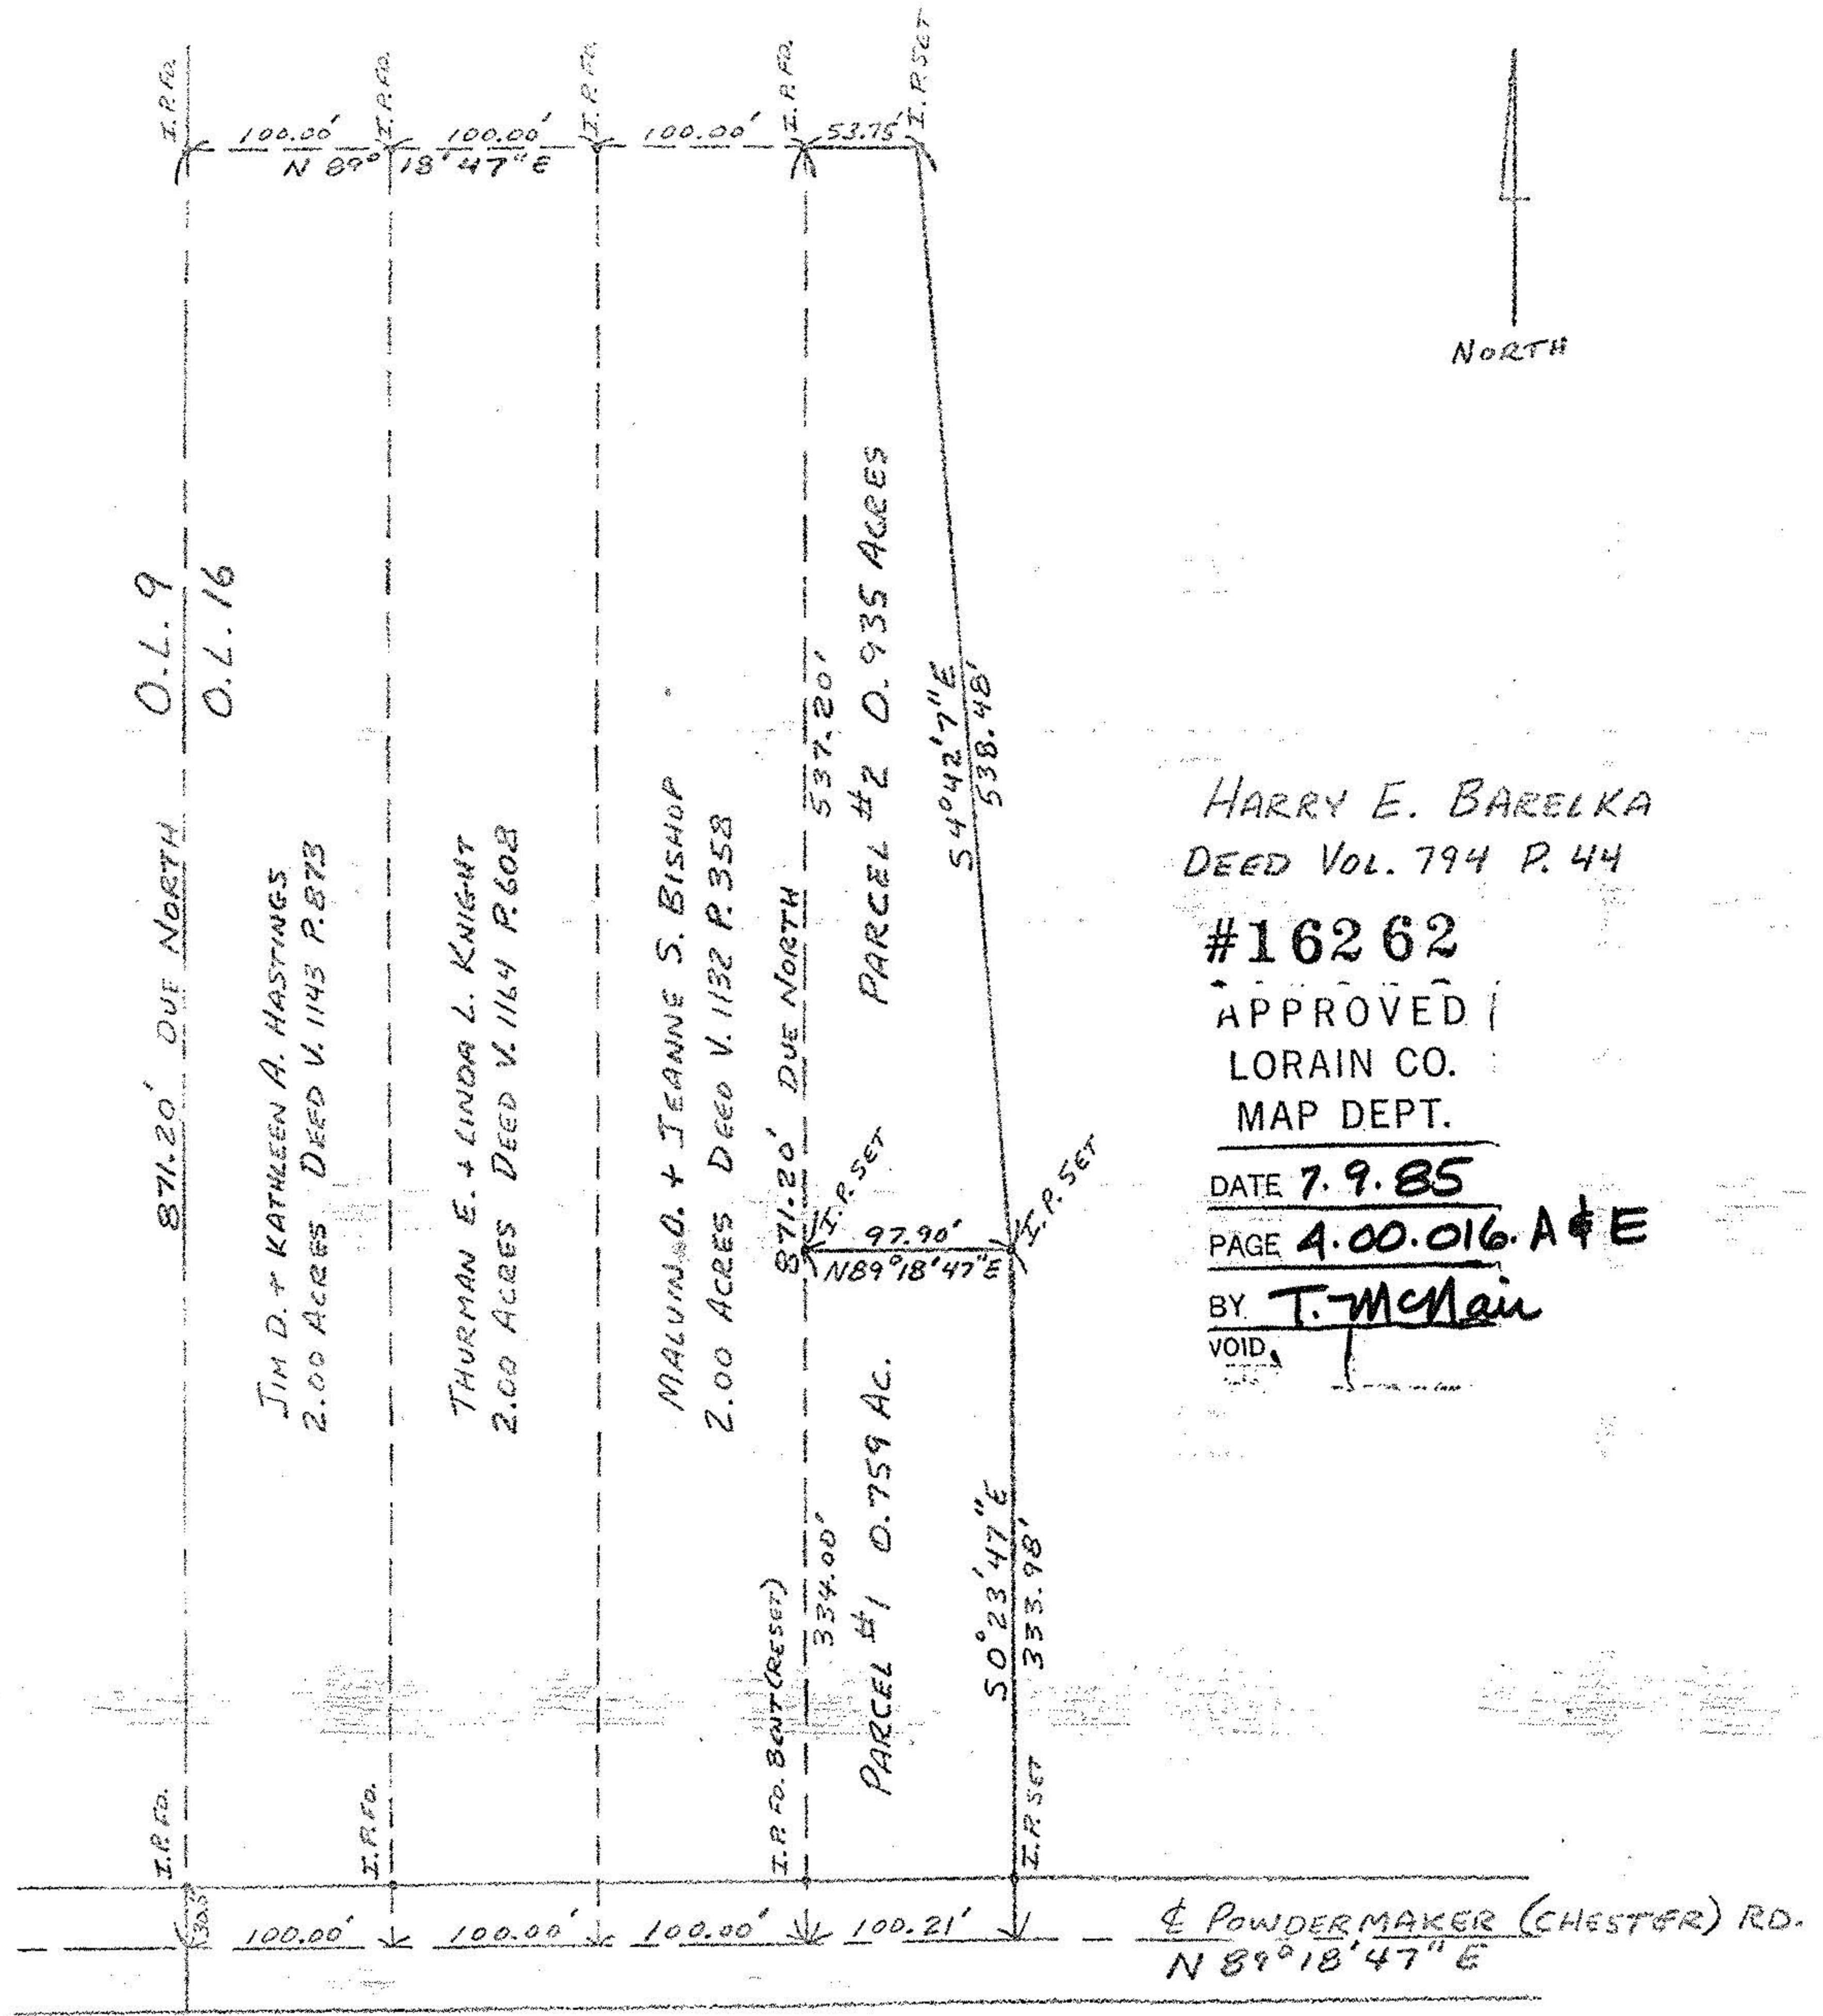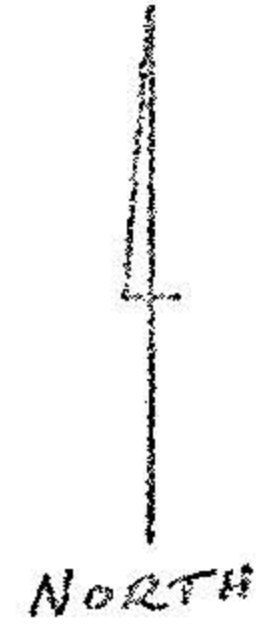

MAP OF SURVEY OF SPLIT FOR HARRY BARELKA AVON TWP. - O.L. 16		
SCALE: 1"=100'	APPROVED BY:	DRAWN BY JRM
DATE: 3/30/85		REVISED
JOHN R. HAMILTON REG. SURV. #6861		
		DRAWING NUMBER