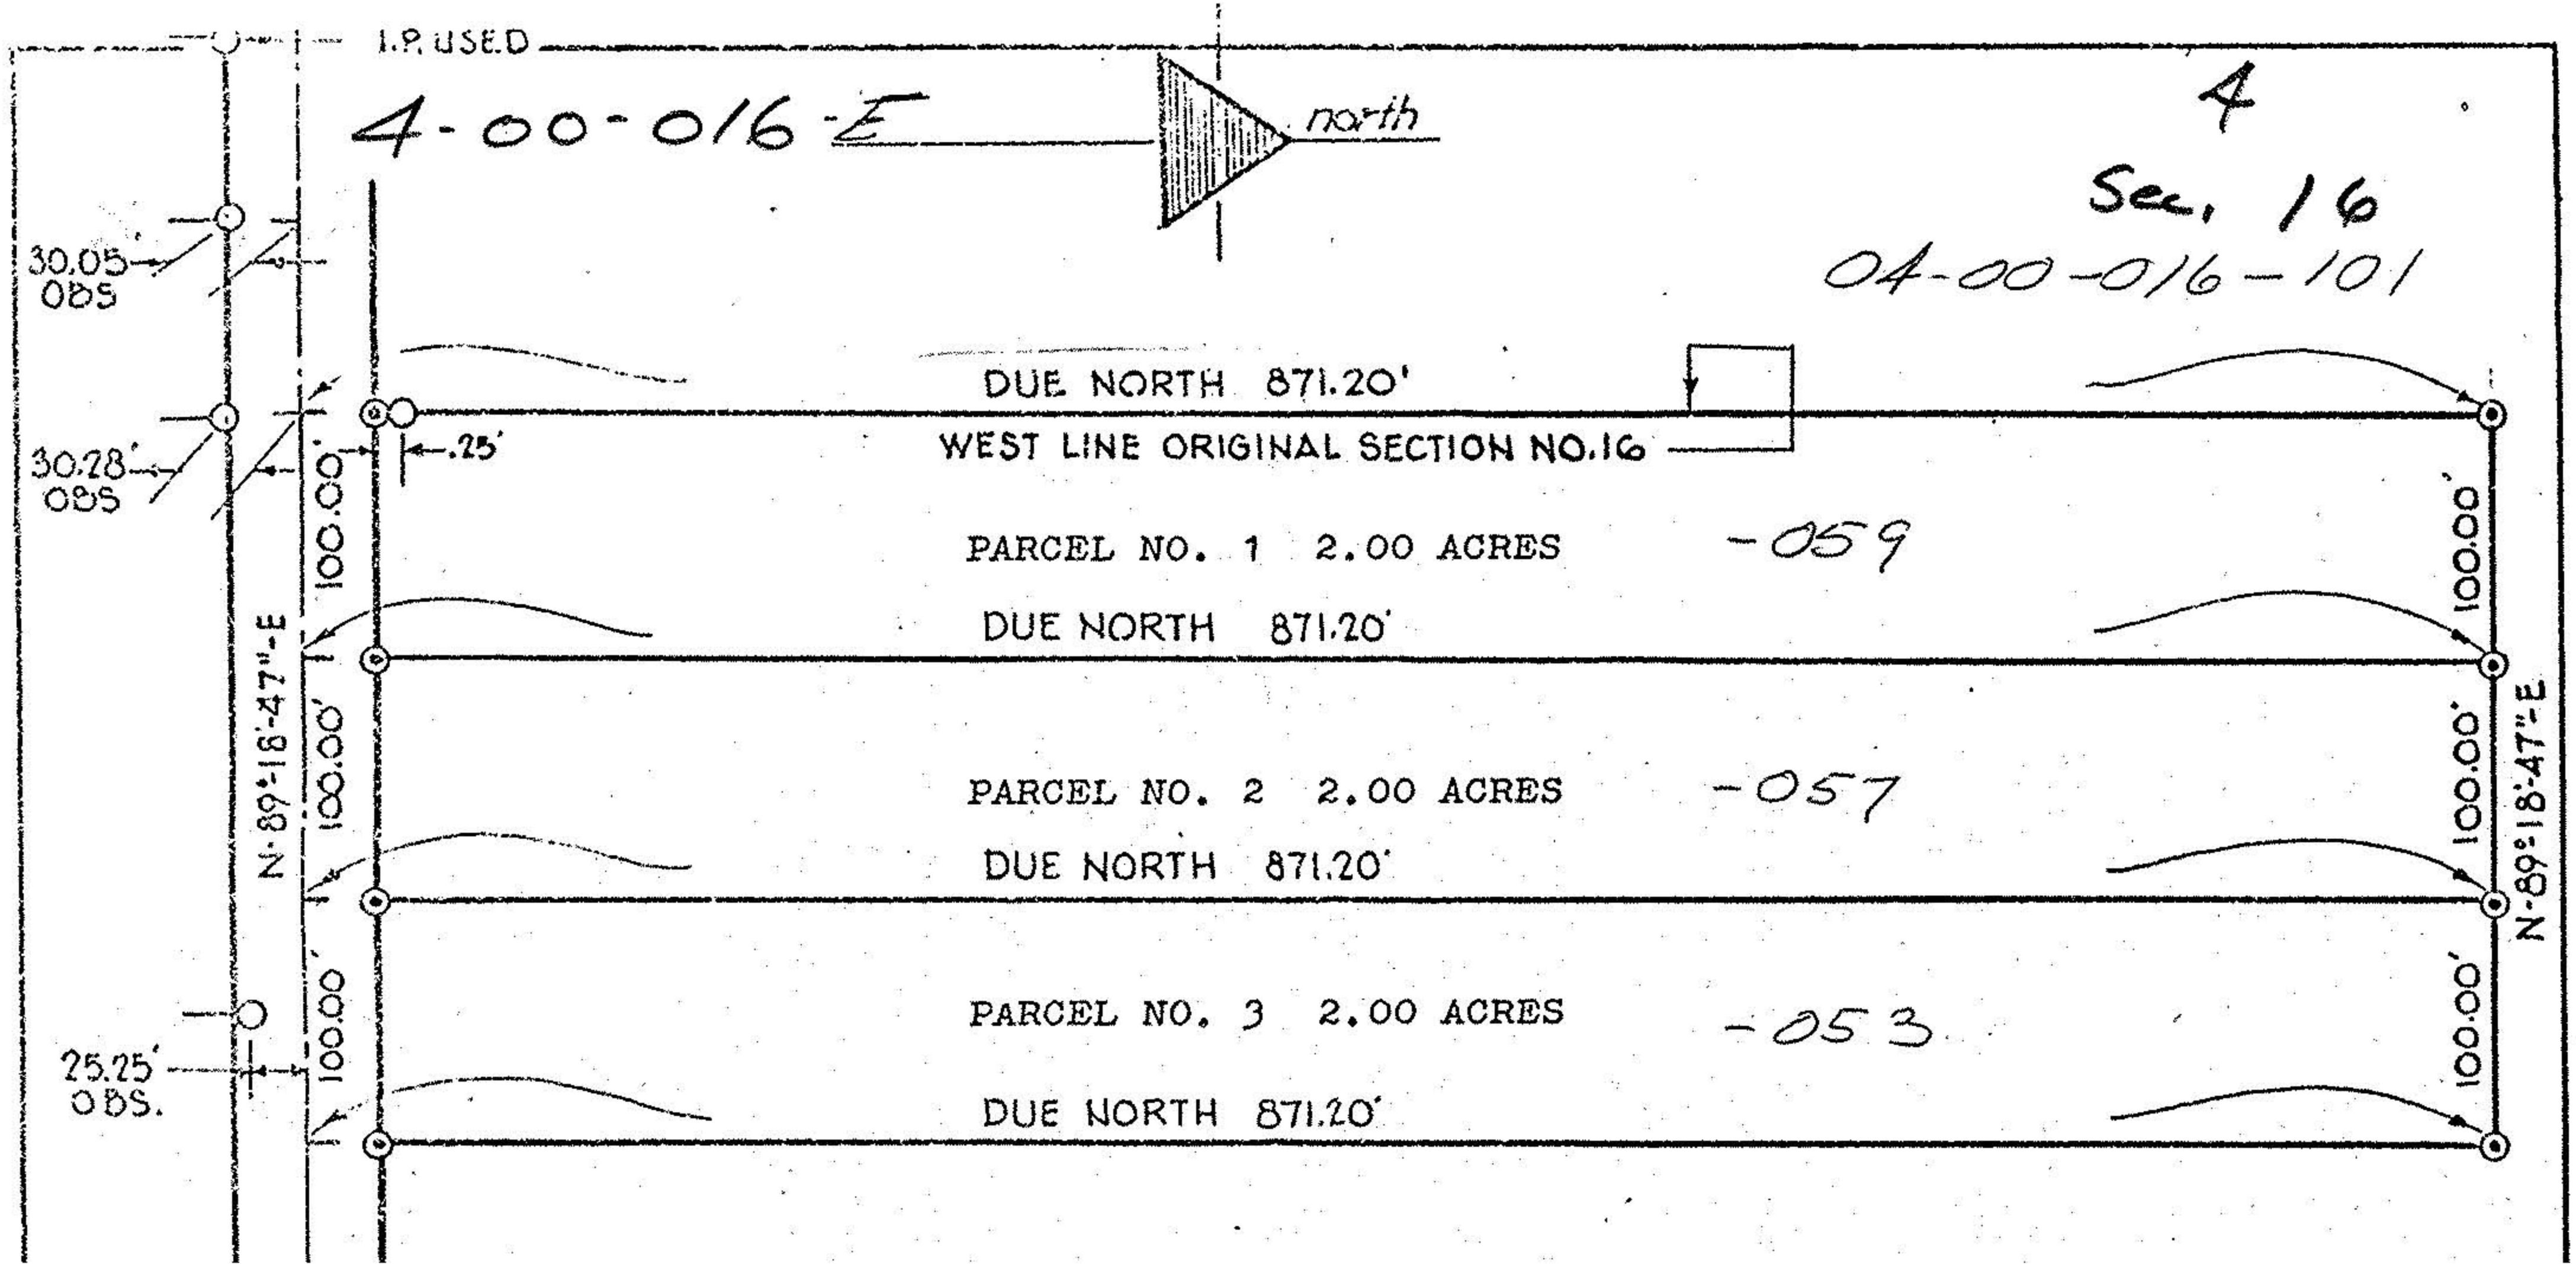
I.P. USED
4-00-016-E
north
4
Sec. 16
04-00-016-101
30.05' OBS
30.28' OBS
25.25' OBS.
DUE NORTH 871.20'
WEST LINE ORIGINAL SECTION NO.16
.25'
100.00'
N-89°-18'-47"-E
PARCEL NO. 1 2.00 ACRES
-059
DUE NORTH 871.20'
PARCEL NO. 2 2.00 ACRES
-057
DUE NORTH 871.20'
PARCEL NO. 3 2.00 ACRES
-053
DUE NORTH 871.20'