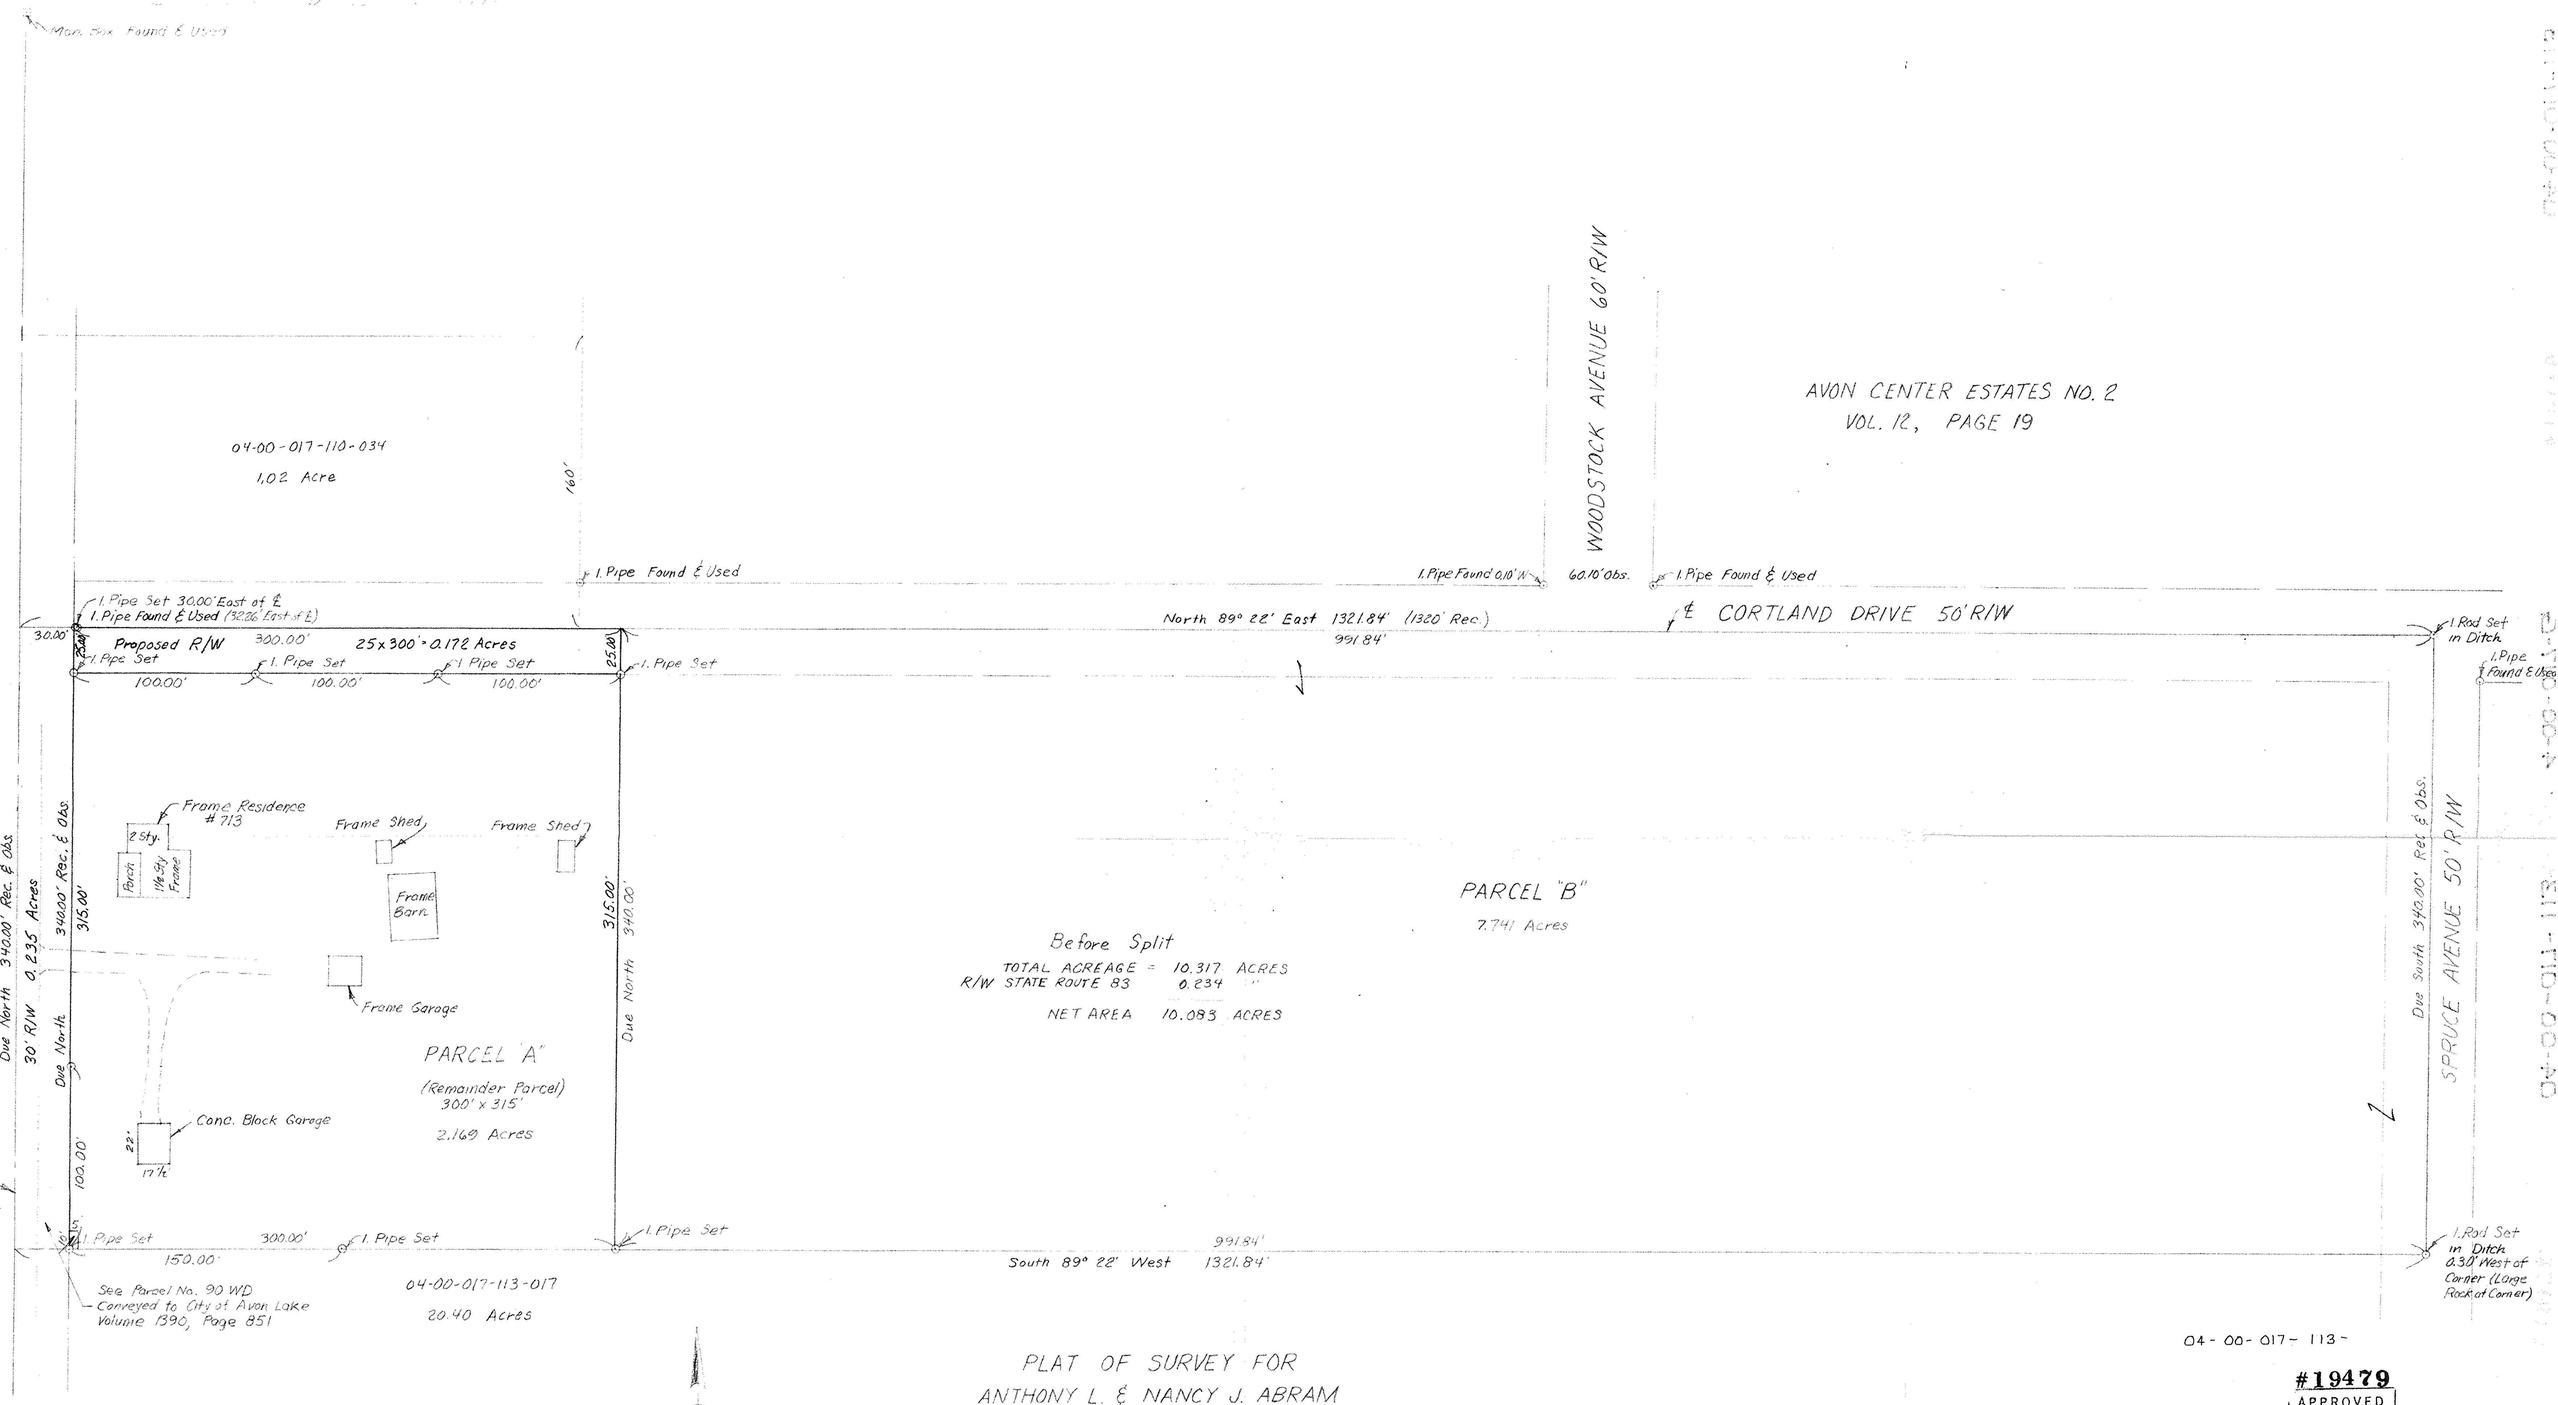

NOTE: All Structures are to scale

PLAT OF SURVEY FOR
ANTHONY L. & NANCY J. ABRAM

ORIGINAL AVON TOWNSHIP SECTION NO. 17
NOW CITY OF AVON LAKE, LORAIN COUNTY OHIO

PERMANENT PARCEL NO. 04-00-017-113-019

#19479

APPROVED
LORAIN CO.
MAP DEPT.
DATE 7-22-91
PAGE 4-00-017G
BY CAROLYN FRANCIS
VOID AFTER # 19479

STATE OF OHIO
LAWRENCE V. McGLINCHY
4970
REGISTERED SURVEYOR

McGLINCHY AND ASSOCIATES
PROFESSIONAL ENGINEERS AND SURVEYORS
625 North Woodhill Drive Amherst, Ohio

SCALE: 1"=40' DRAWN BY: L.V. McGLINCHY
DATE: NOV. 10, 1990 JOB NO: 902302
Rev. 5/7/91, 5/11/91