WILLIAM B. BARTON
Reg. Land Surveyor No. 4438
188 PARKWOOD AVENUE
AVON LAKE, OHIO 44012
TELEPHONE (216) 933-6662

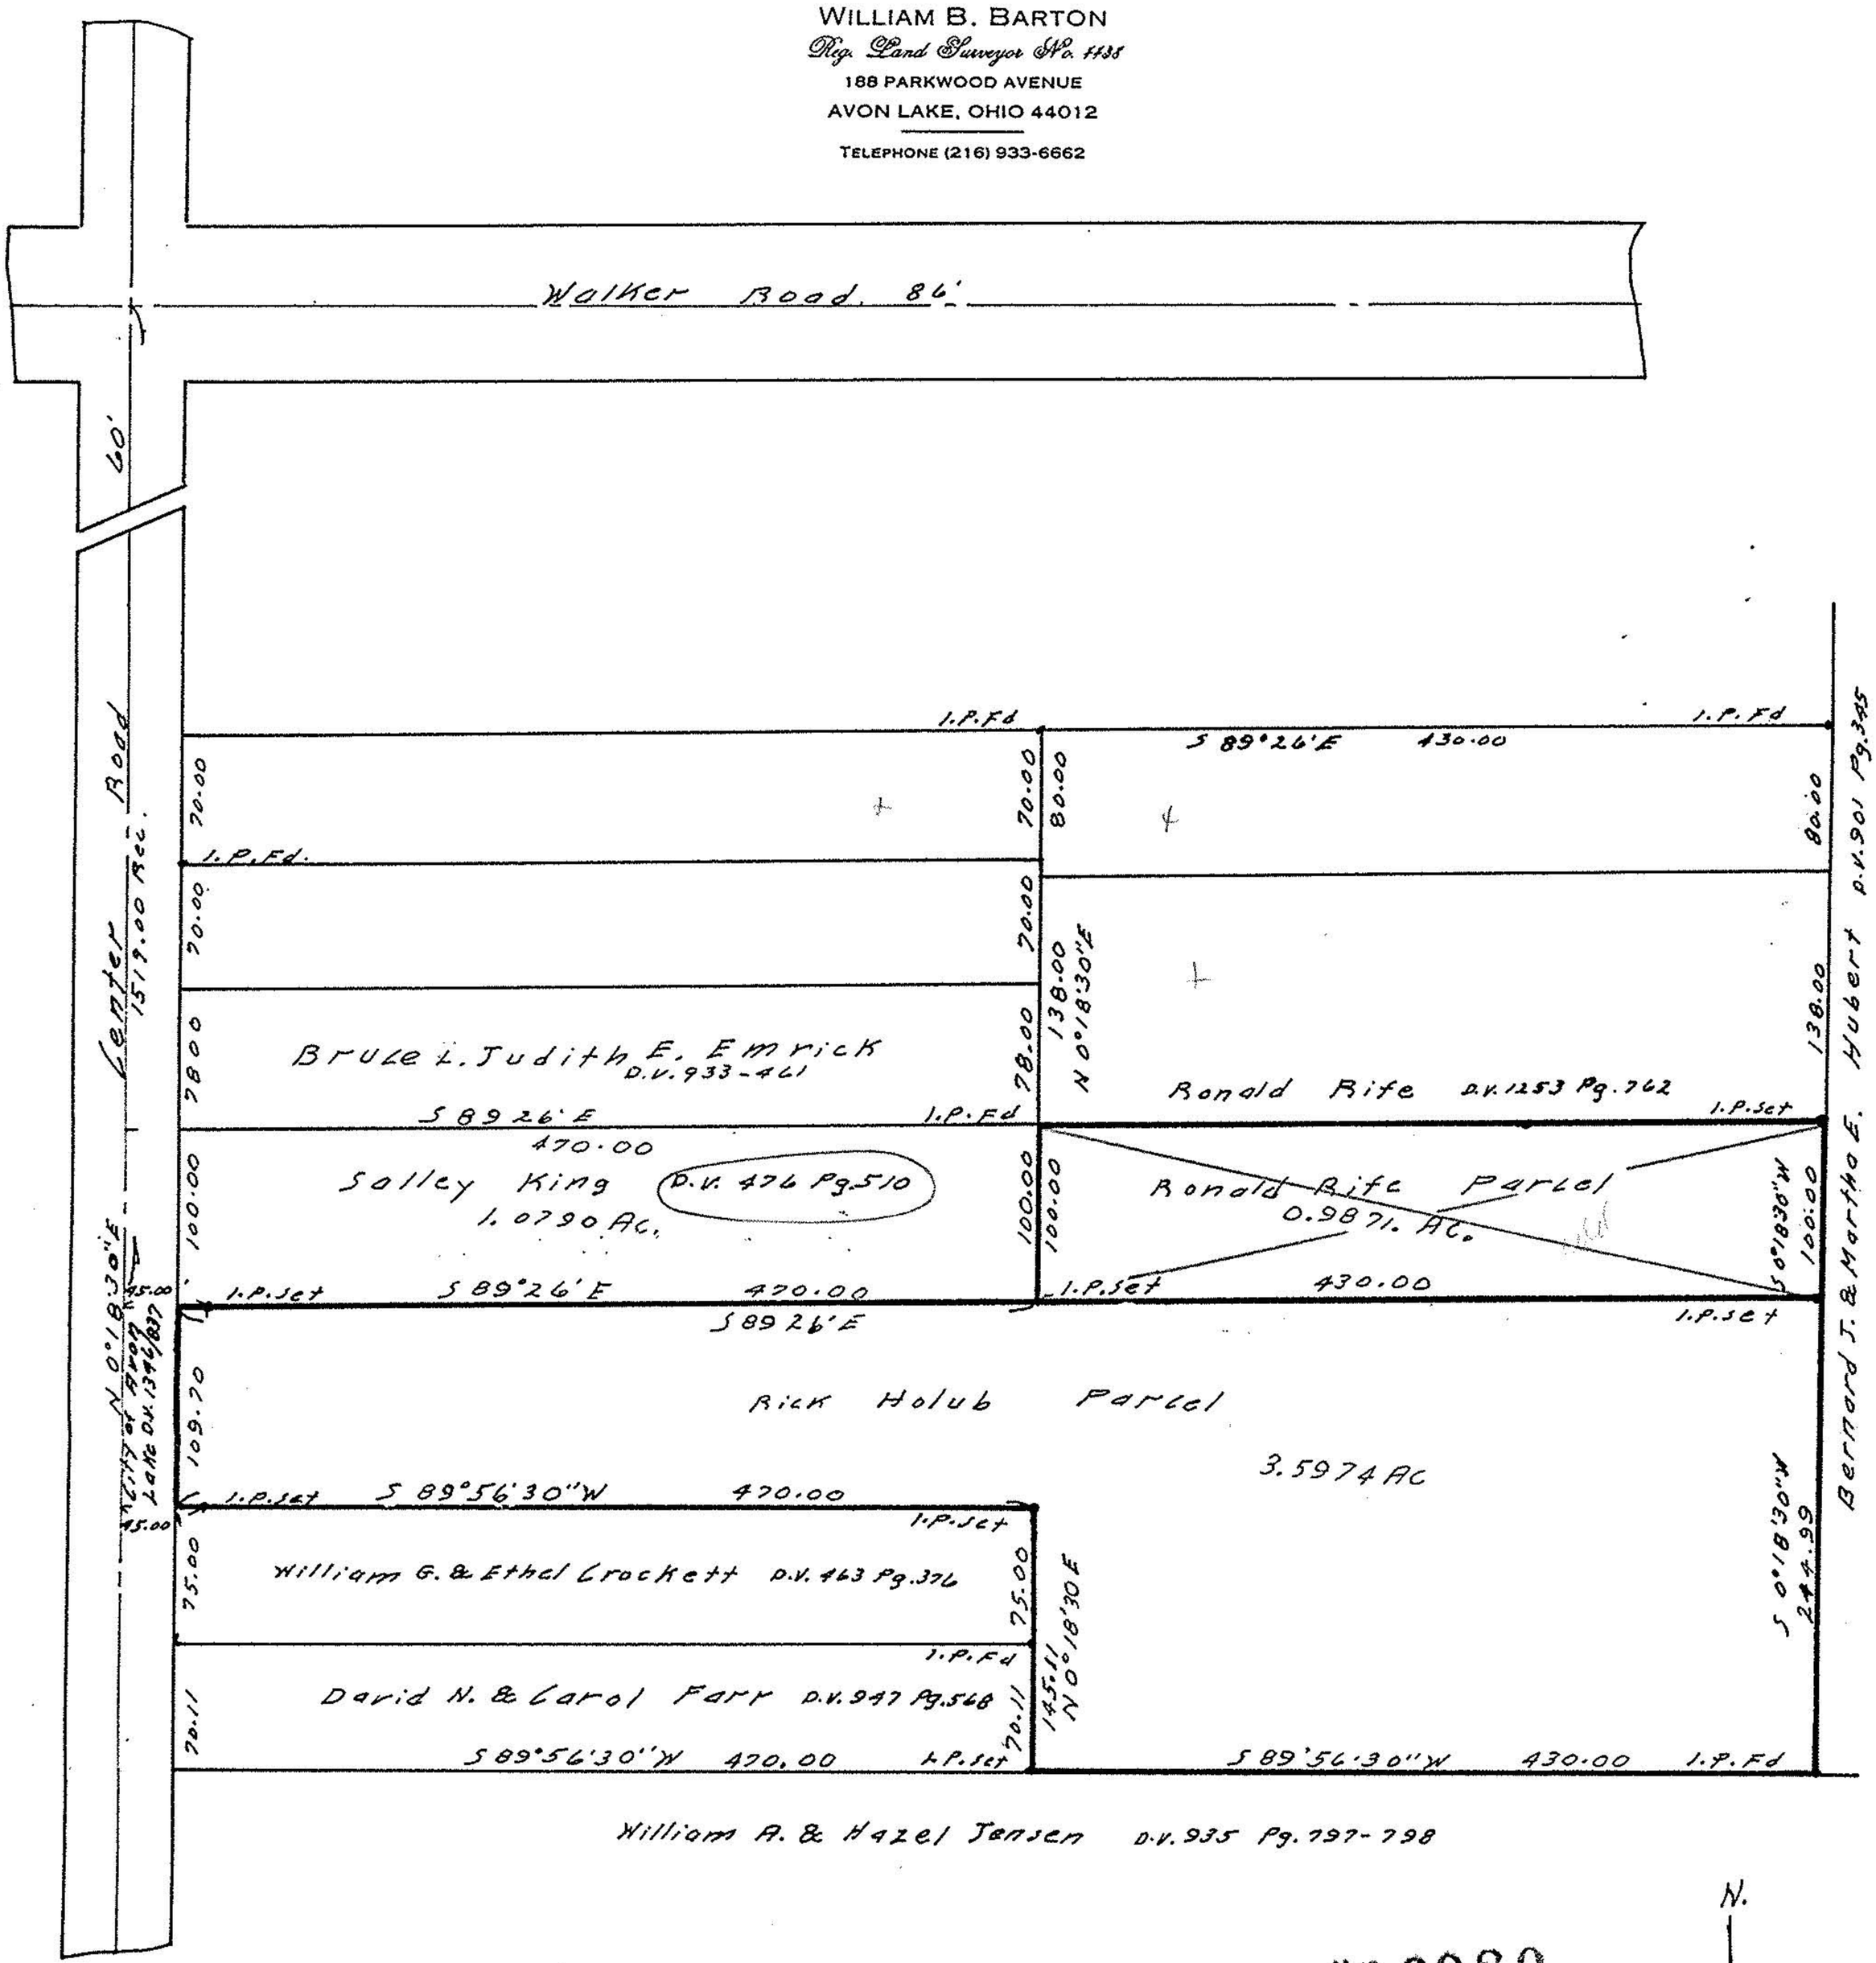

SURVEY
of

Sally King Property of part of
Section N0.17 Avon Townsip now the
City of Avon Lake,County of Lorain
State of Ohio. Scale 1"=100.00 Feet
July 7,1986.
Rev. July 10,1986.

#16980

#16977

APPROVED
LORAIN CO.
MAP DEPT.
DATE 9.4.86
PAGE 4.00.017.C
BY T. McMain
VOID AFTER

STATE OF OHIO
WILLIAM B. BARTON
4438
REGISTERED SURVEYOR