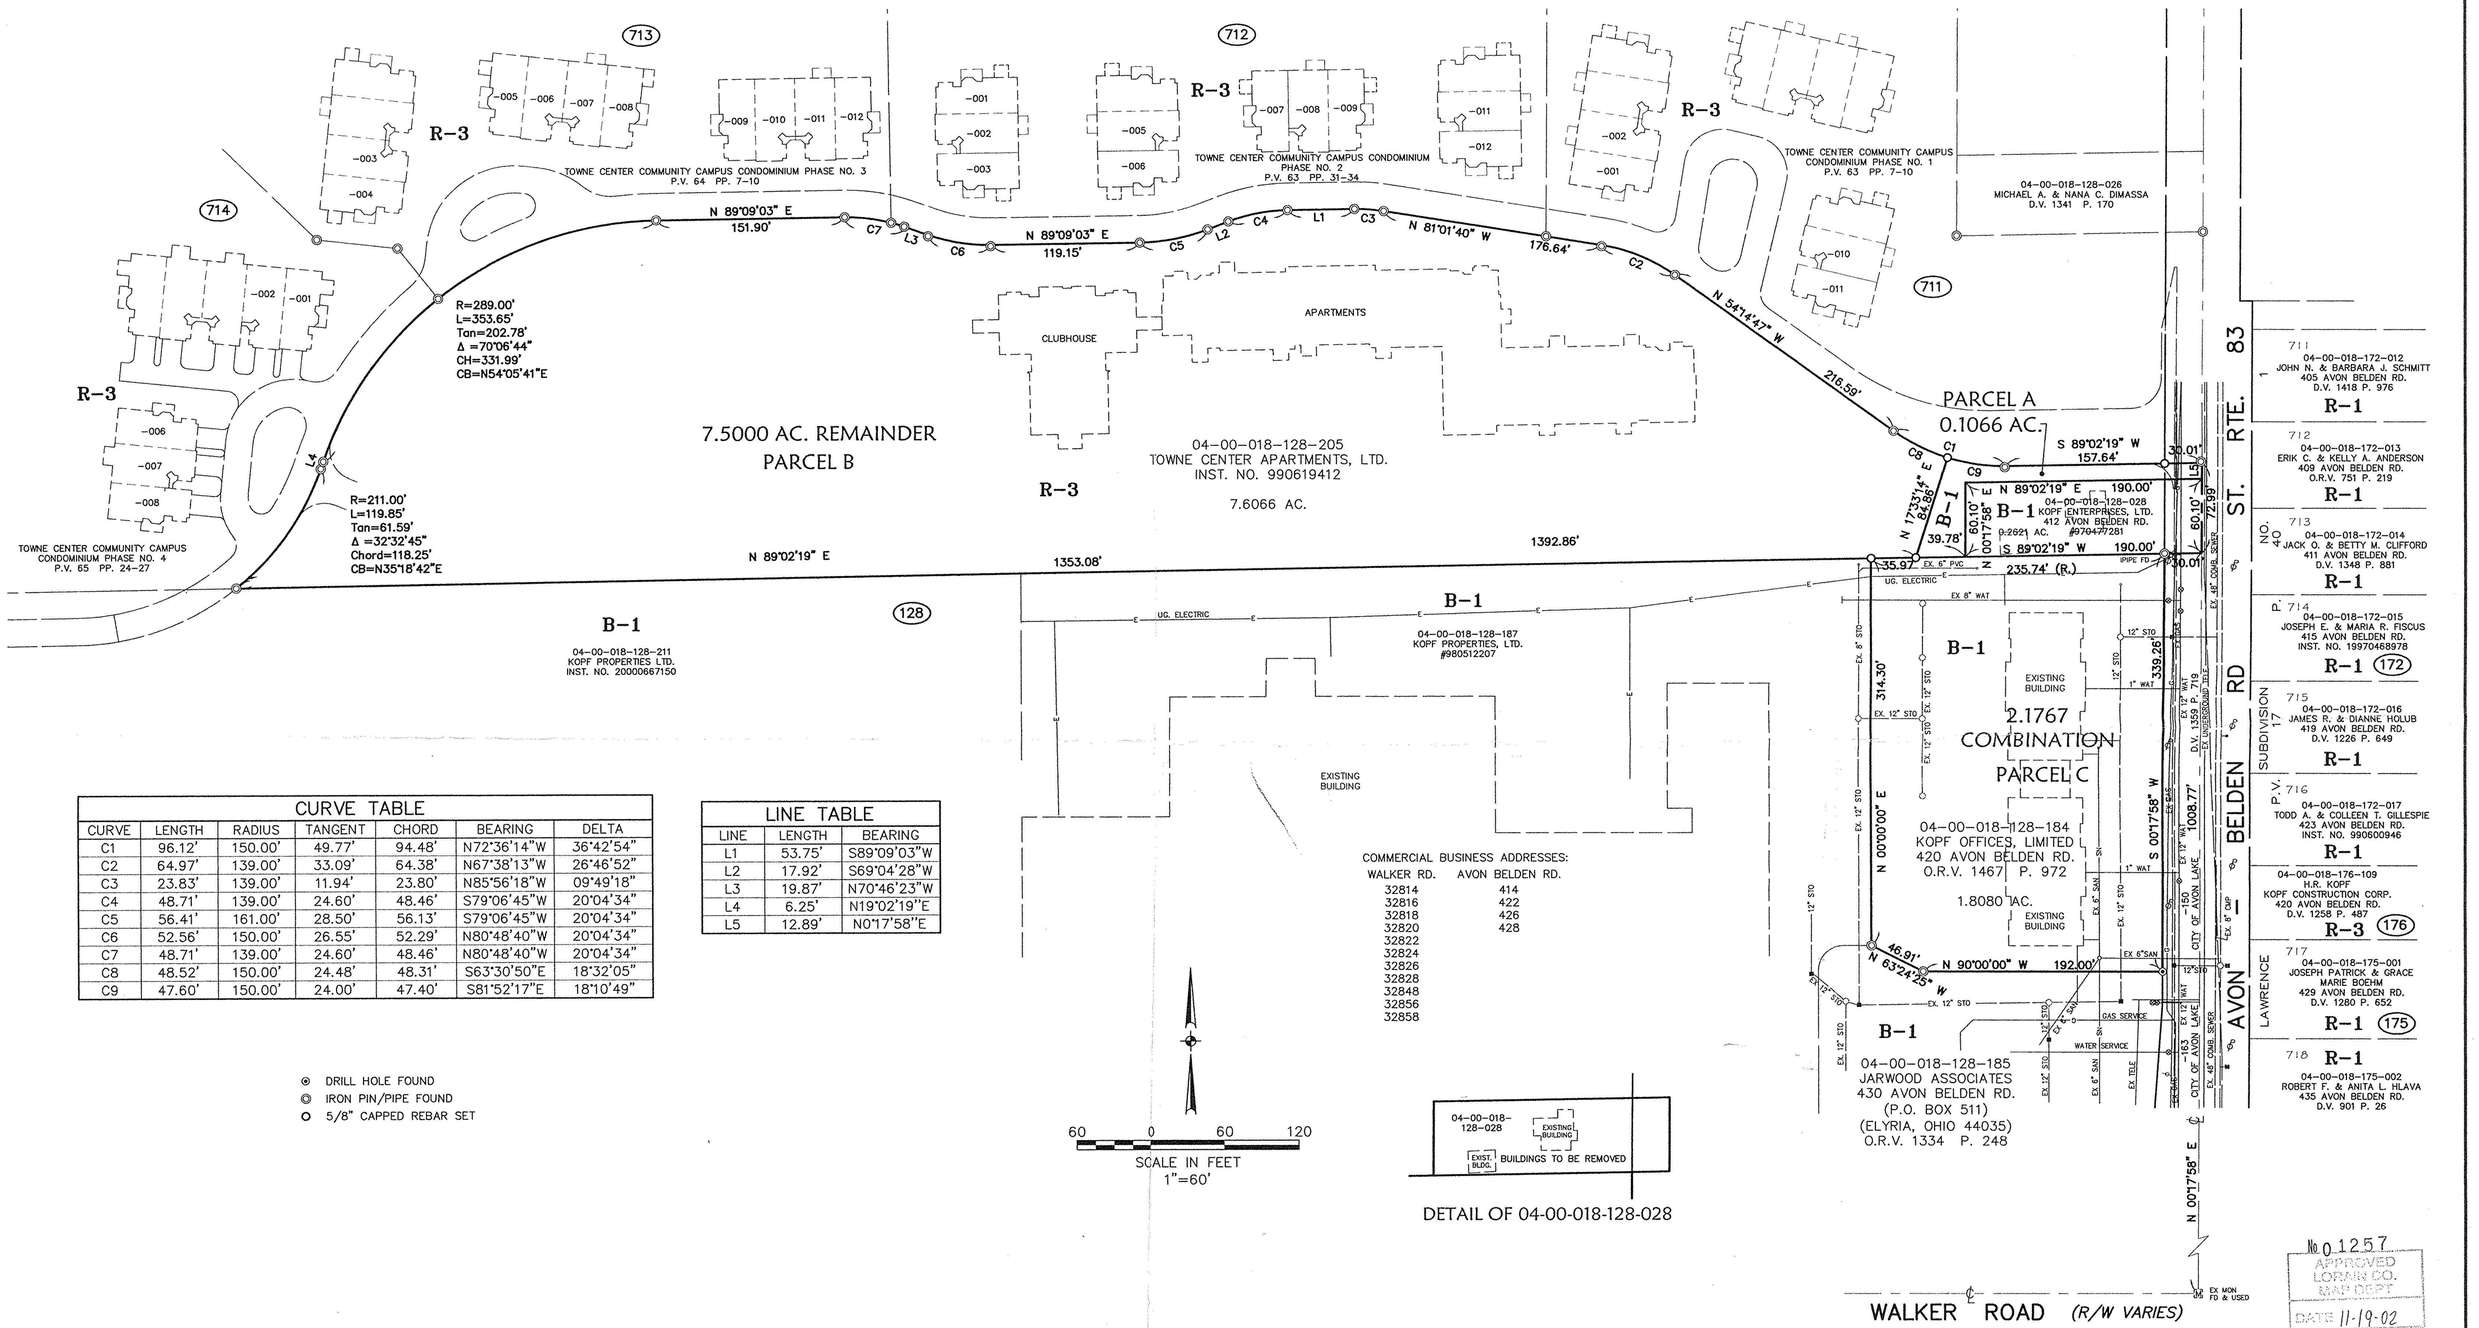

CURVE TABLE						
CURVE	LENGTH	RADIUS	TANGENT	CHORD	BEARING	DELTA
C1	96.12'	150.00'	49.77'	94.48'	N72°36'14"W	36°42'54"
C2	64.97'	139.00'	33.09'	64.38'	N67°38'13"W	26°46'52"
C3	23.83'	139.00'	11.94'	23.80'	N85°56'18"W	09°49'18"
C4	48.71'	139.00'	24.60'	48.46'	S79°06'45"W	20°04'34"
C5	56.41'	161.00'	28.50'	56.13'	S79°06'45"W	20°04'34"
C6	52.56'	150.00'	26.55'	52.29'	N80°48'40"W	20°04'34"
C7	48.71'	139.00'	24.60'	48.46'	N80°48'40"W	20°04'34"
C8	48.52'	150.00'	24.48'	48.31'	S63°30'50"E	18°32'05"
C9	47.60'	150.00'	24.00'	47.40'	S81°52'17"E	18°10'49"

LINE TABLE		
LINE	LENGTH	BEARING
L1	53.75'	S89°09'03"W
L2	17.92'	S69°04'28"W
L3	19.87'	N70°46'23"W
L4	6.25'	N19°02'19"E
L5	12.89'	N0°17'58"E

COMMERCIAL BUSINESS ADDRESSES:

WALKER RD.	AVON BELDEN RD.
32814	414
32816	422
32818	426
32820	428
32822	
32824	
32826	
32828	
32848	
32856	
32858	

- ⊙ DRILL HOLE FOUND
- ◎ IRON PIN/PIPE FOUND
- O 5/8" CAPPED REBAR SET

No 01257
APPROVED
LORAIN CO.
MAP DEPT
DATE 11-19-02
PAGE 4-00-018-1
BY J Hatfield
#02-01257

David L. Elwell
DAVID L. ELWELL
REGISTERED SURVEYOR NO. 6333

STATE OF OHIO
DAVID L. ELWELL
6333
REGISTERED SURVEYOR

DATE:	10-04-02
DRAWN BY:	ABR
CH'D BY:	
DWG. NAME:	0-SPLIT01
PATH:	97228-R
F.B.	

REVISIONS

DATE	DESCRIPTION	BY
10-25-02	PIN NOTE ADDED	ABR
10-04-02	ORIGINAL ISSUE	ABR

KS ASSOCIATES
KS ASSOCIATES, INC.
260 Burns Road, Suite 100
P.O. Box 569
Elyria, Ohio 44036
Phone (440) 365-4730
Fax (440) 365-4790
mailroom@ksassoc.com
www.ksassoc.com

SURVEY MAP
PARCEL NOS. 40-00-018-128-028, -184 & -205

OF PART OF
ORIGINAL AVON TOWNSHIP SECTION NO. 18
CITY OF AVON LAKE COUNTY OF LORAIN STATE OF OHIO

SHEET 1 OF 1

JOB NO. 97228-R