


# SURVEY MAP

SUBLOTS 96, 97, & 98
AVON LAKE SUBDIVISION P.V. 13 PP. 24 & 25
CITY OF AVON LAKE, COUNTY OF LORAIN
STATE OF OHIO

PREPARED BY

KS ASSOCIATES, INC.
424 MIDDLE AVE.
P.O. BOX 89
ELYRIA, OHIO 44036
PH. 322-6317

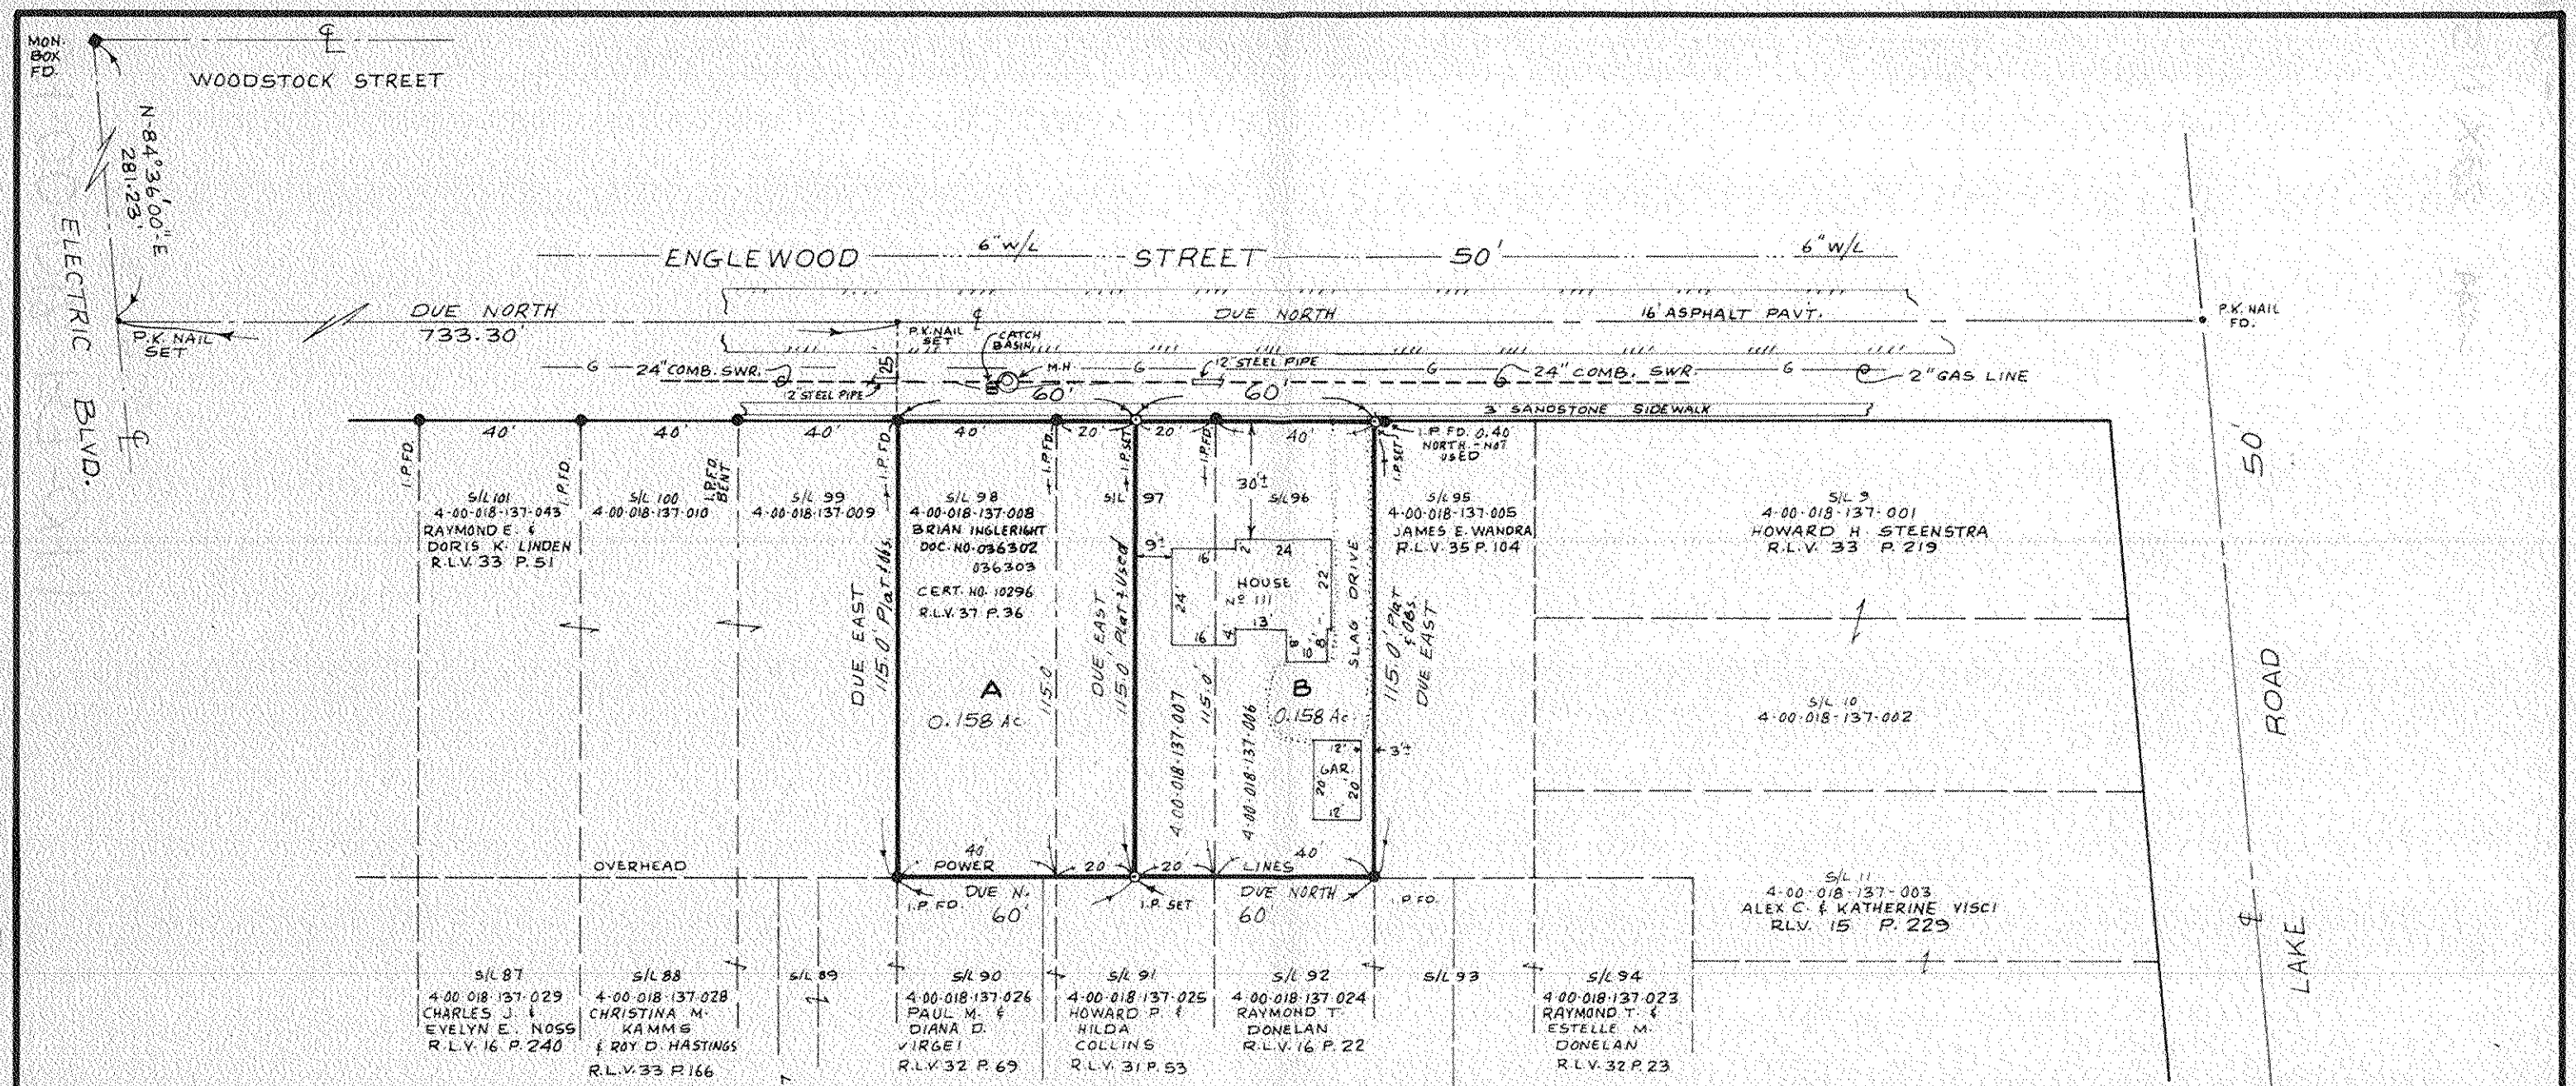


SCALE: 1"=40'
GRAPHIC SCALE
40 30 20 10 0 40 80

David L. Elwell
DAVID L. ELWELL - REG. SURV. NO. 6333

REV. 3-10-92
REV. 3-6-92

92-029

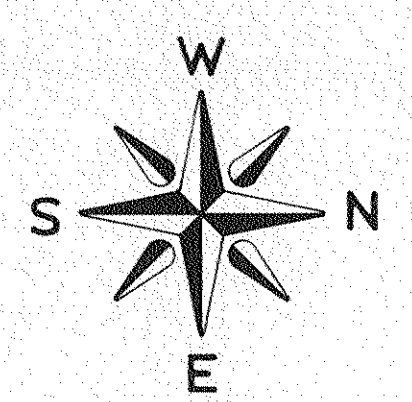Plat # 2-810-00-04 Scan