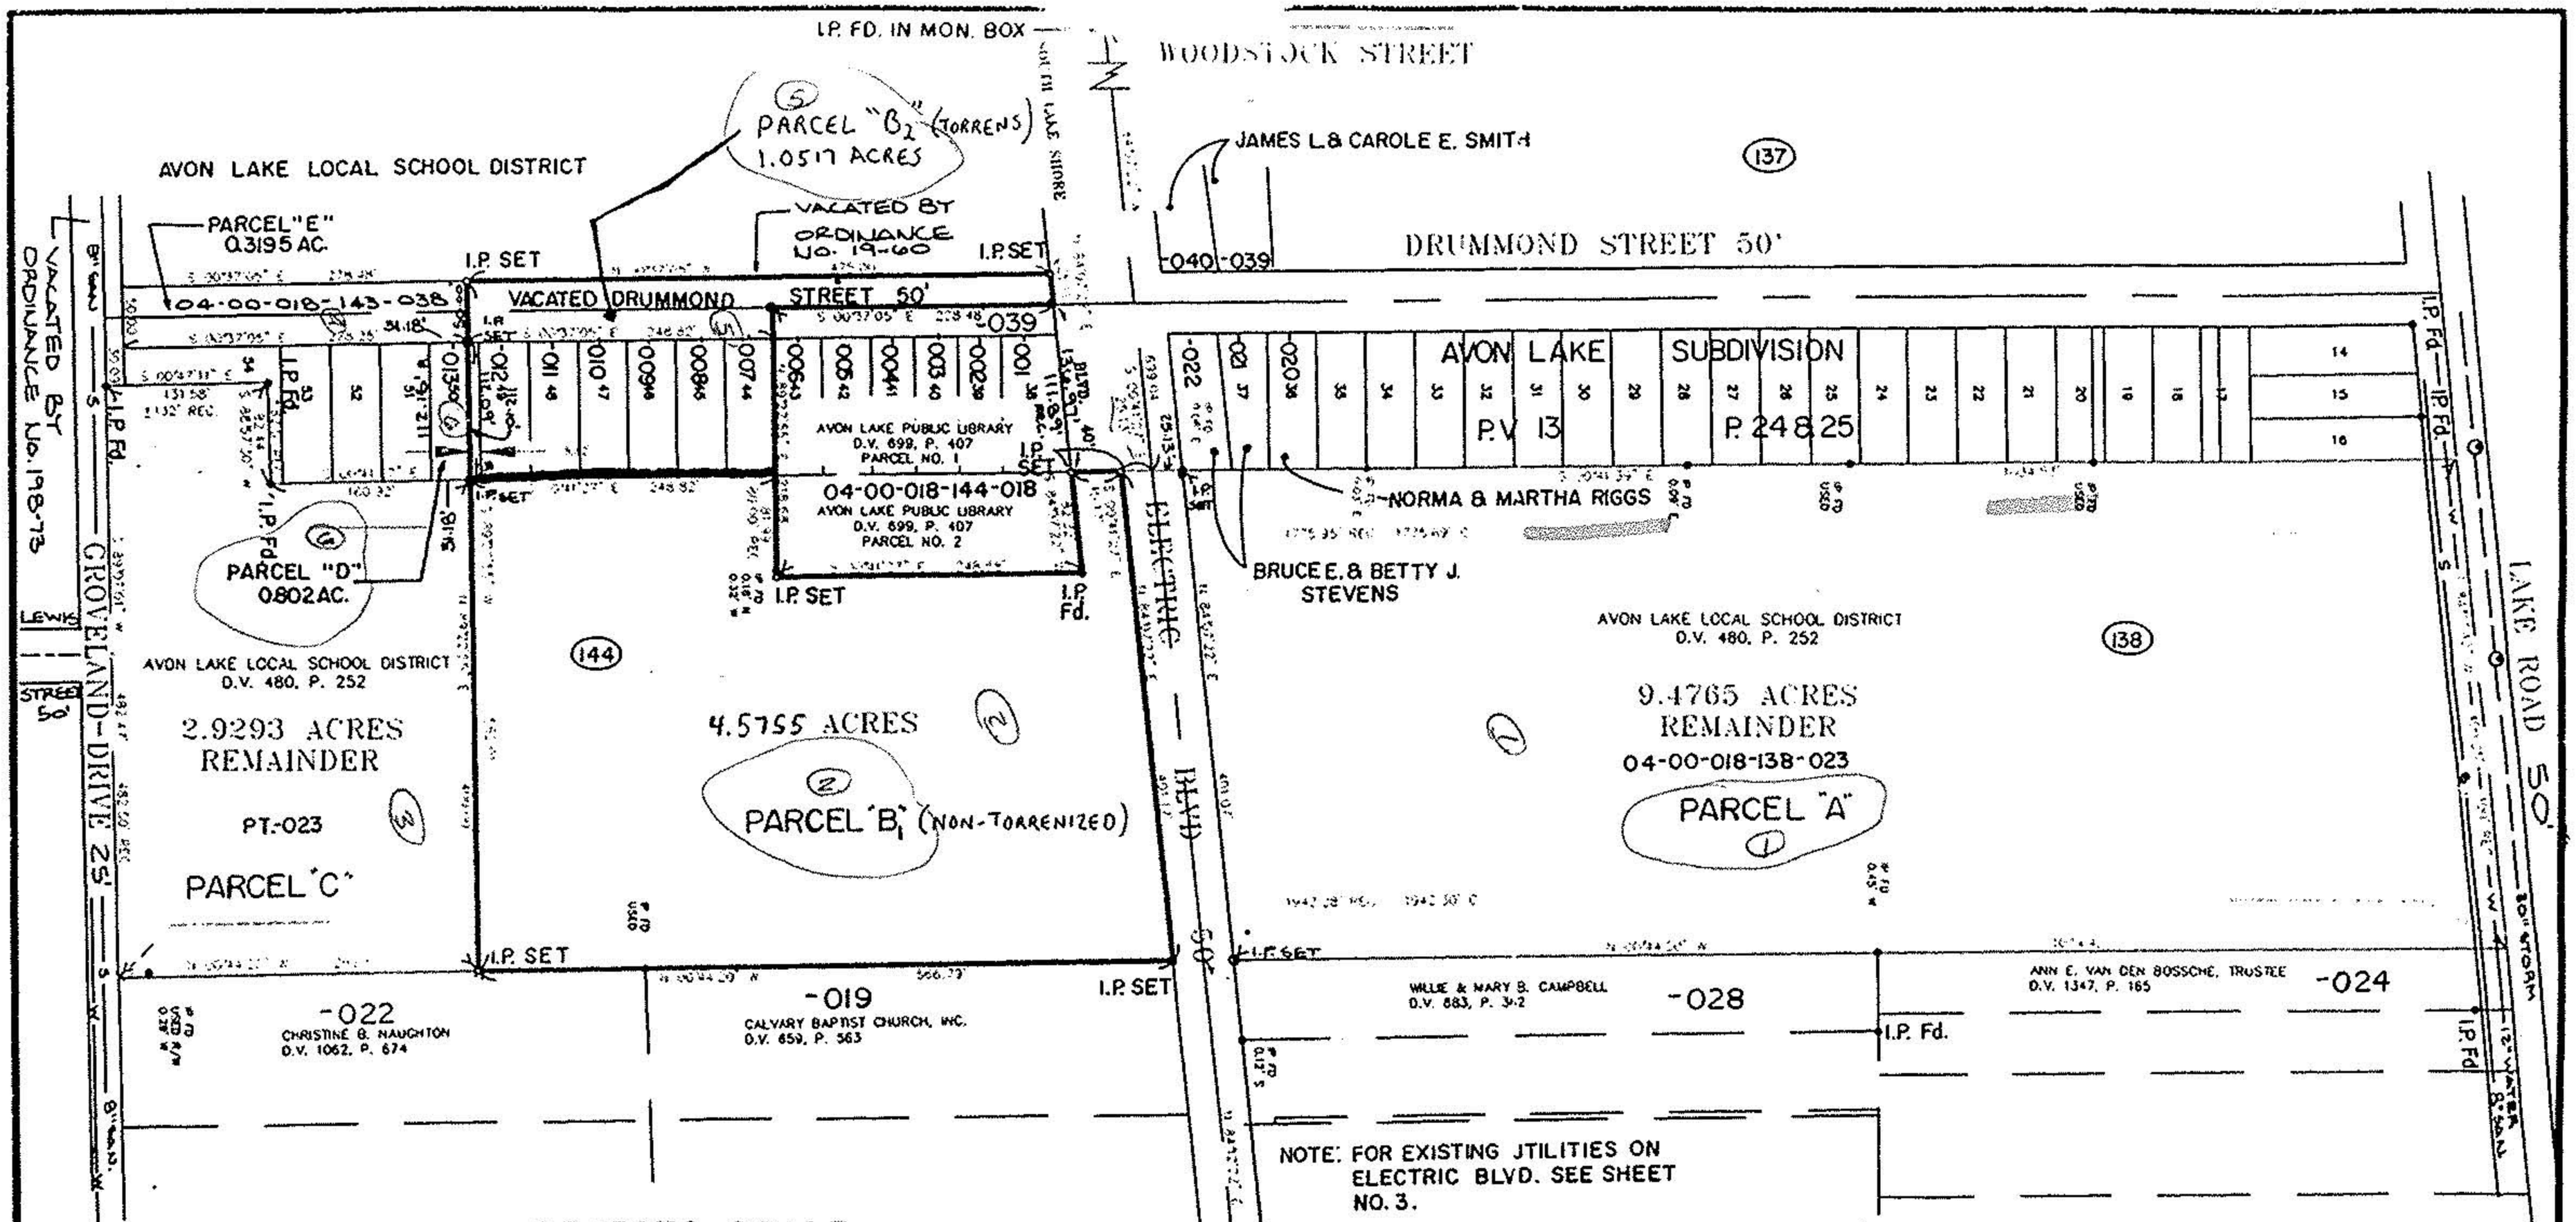

ACREAGE BREAKDOWN

PARCEL B_1: ORIG. LOT 4.5755 AC.

PARCEL B_2: SUBLOTS 0.6356 AC.
ERIMBOND 0.4161 AC.
1.0517 AC.

REVISIONS	
6-9-93	REVISIONS PER CITY OF AVON LAKE

SURVEY MAP
AVON LAKE PUBLIC LIBRARY
PART OF ORIGINAL AVON TOWNSHIP SECTION NO. 18
CITY OF AVON, COUNTY OF LORAIN, STATE OF OHIO

KS ASSOCIATES, INC.
ENGINEERS SURVEYORS
ELYRIA (216) 322-9317 • LOP

KS ASSOCIATES INCORPORATED

SHEET 1 OF 3
JOB NO. 93138