LAUNDON • SIMON • CAHL & ASSOC. INC.
CONSULTING ENGINEERS & SURVEYORS
504 MIDDLE AVENUE ELYRIA, OHIO 44035

SURVEY FOR

WARREN KNOX

Orig. Lot	City of AVON LAKE	Date 9-6-84 Scale 1"=50'
Orig. Sec 19	Village of	Dwn. by R.G.S Chkd. by J.C.
Tract	County of LORAIN	Job No. 84- F.B. 98-56
Township of AVON	State of OHIO	Printed

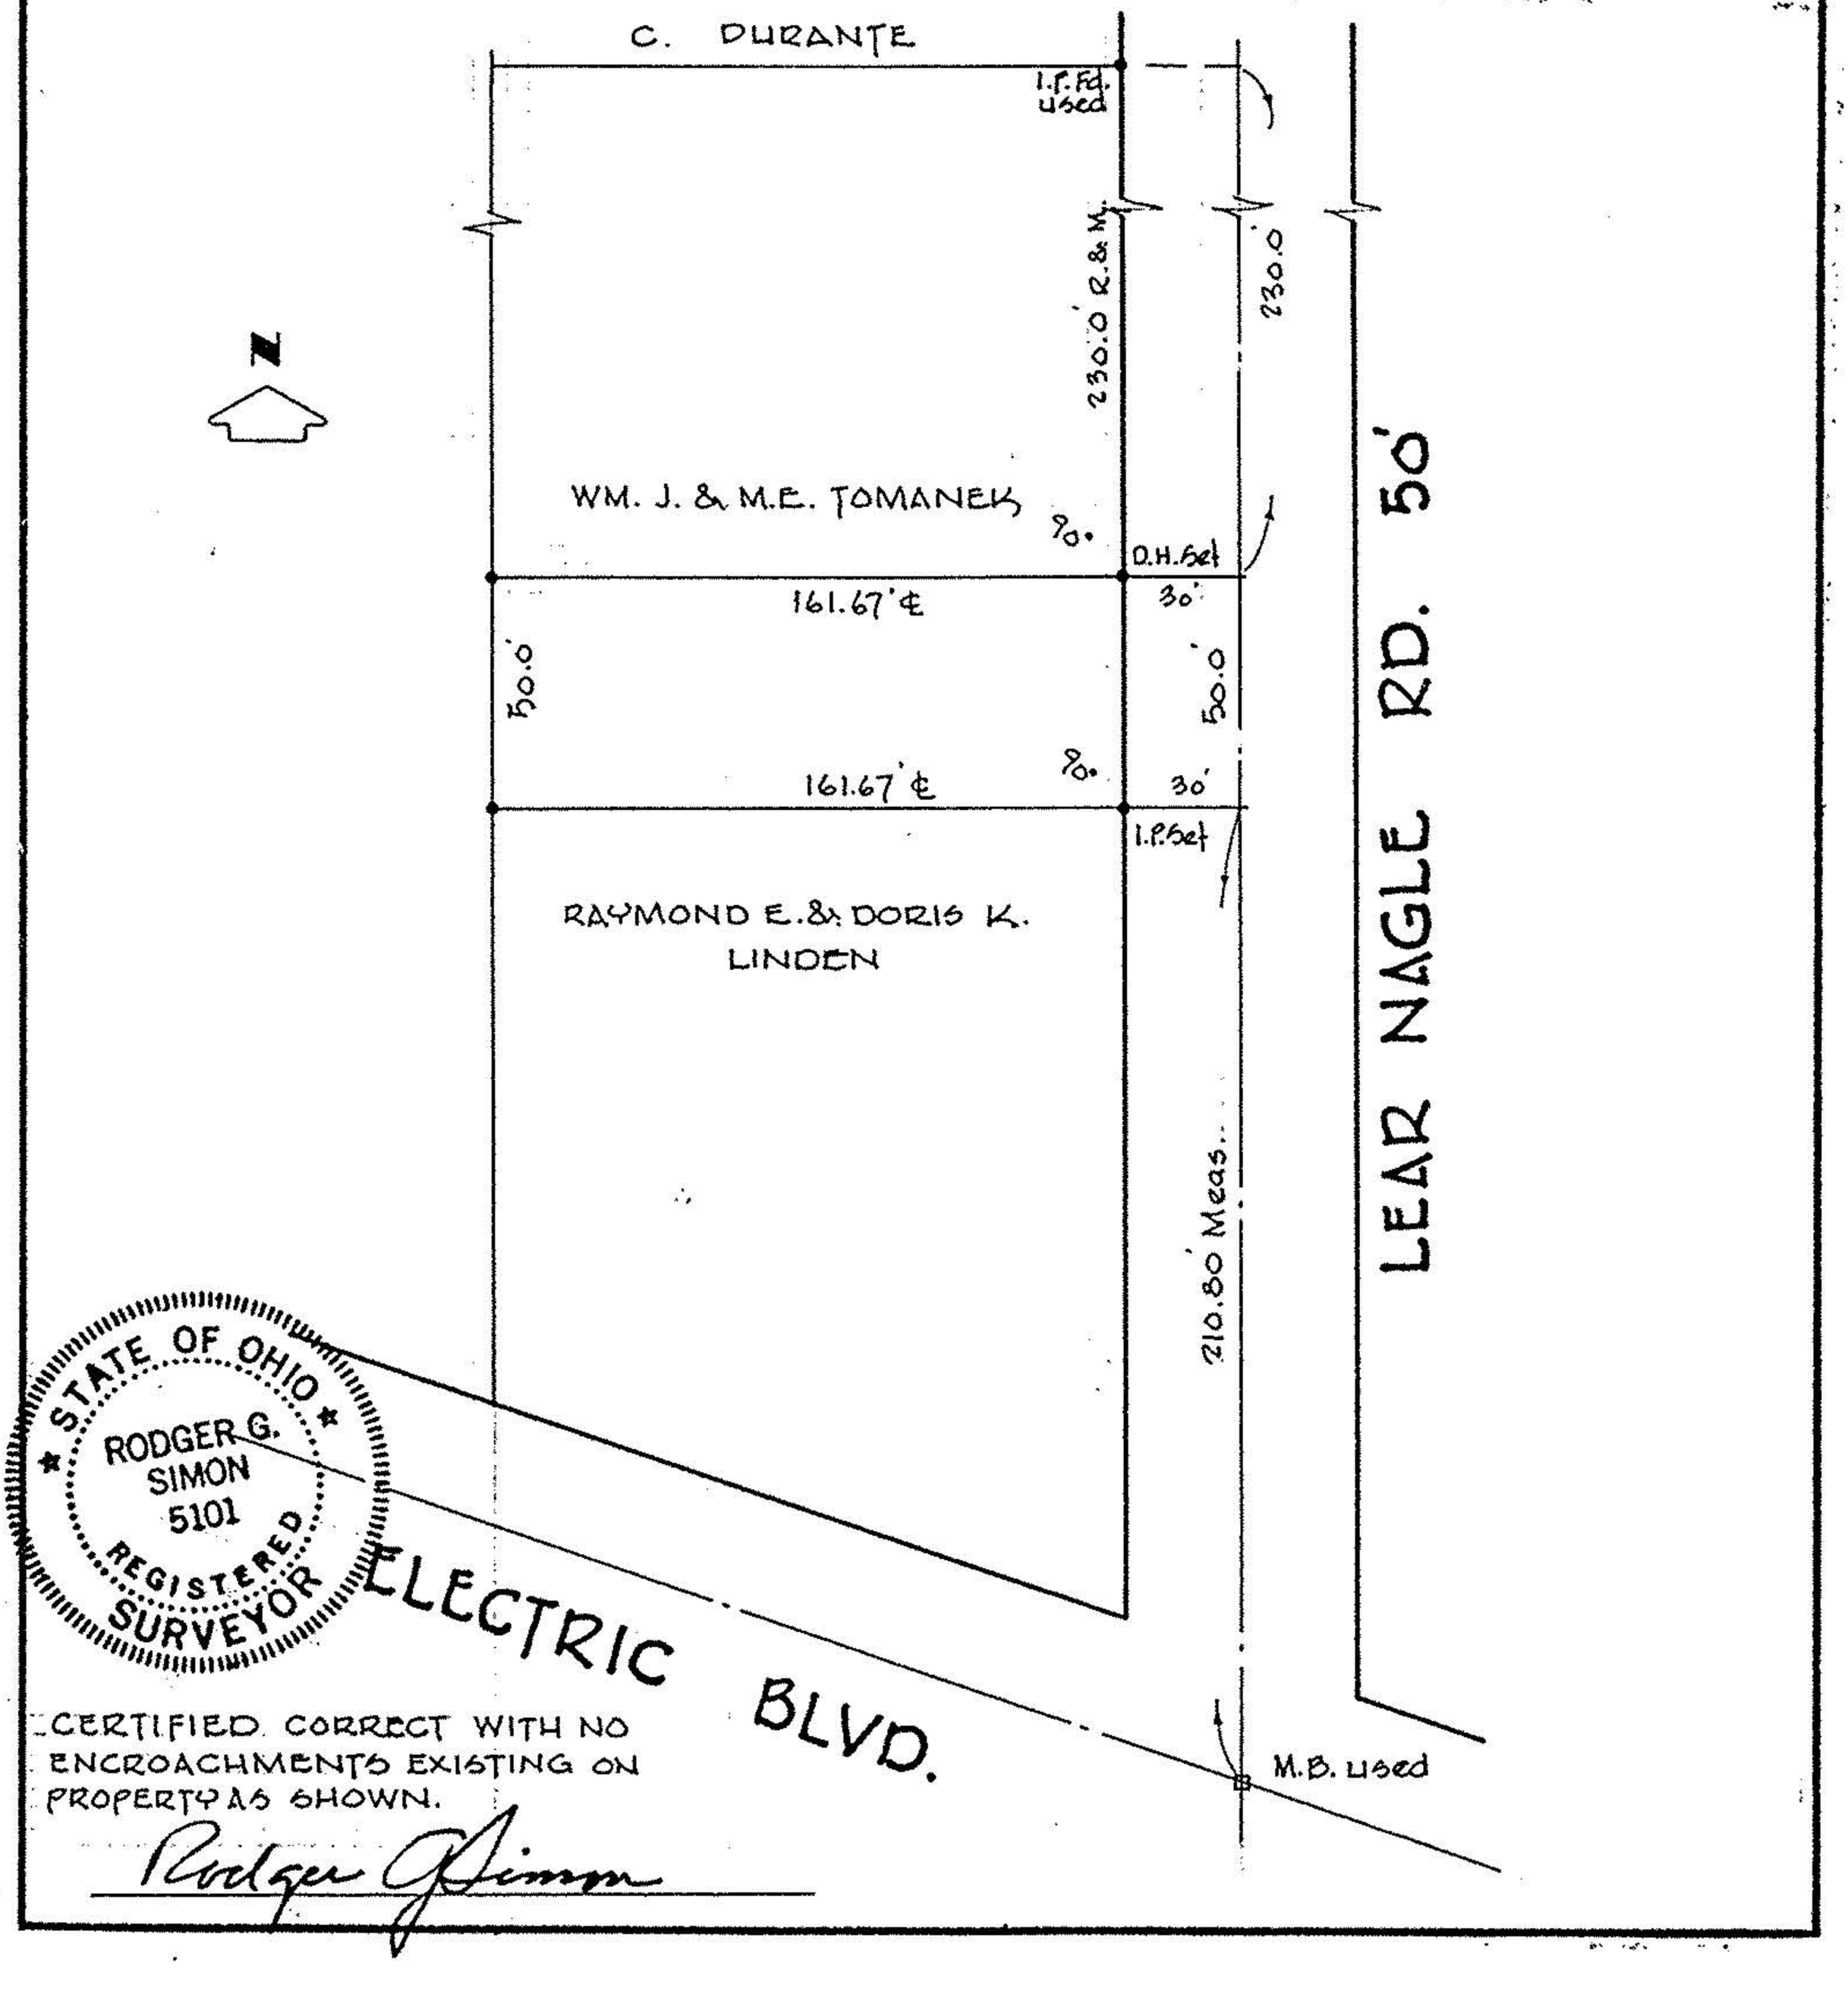

STATE OF OHIO
RODGER G. SIMON 5101
REGISTERED SURVEYOR

CERTIFIED CORRECT WITH NO ENCROACHMENTS EXISTING ON PROPERTY AS SHOWN.

Rodger G. Simon