4-00-019-D ✕18517 04-00-019-134

MAP OF PROPERTY SURVEY

PART OF
AVON TOWNSHIP SECTION № 19
CITY OF AVON LAKE · COUNTY OF LORAIN · STATE OF OHIO

NORTH
SCALE 1" = 100'

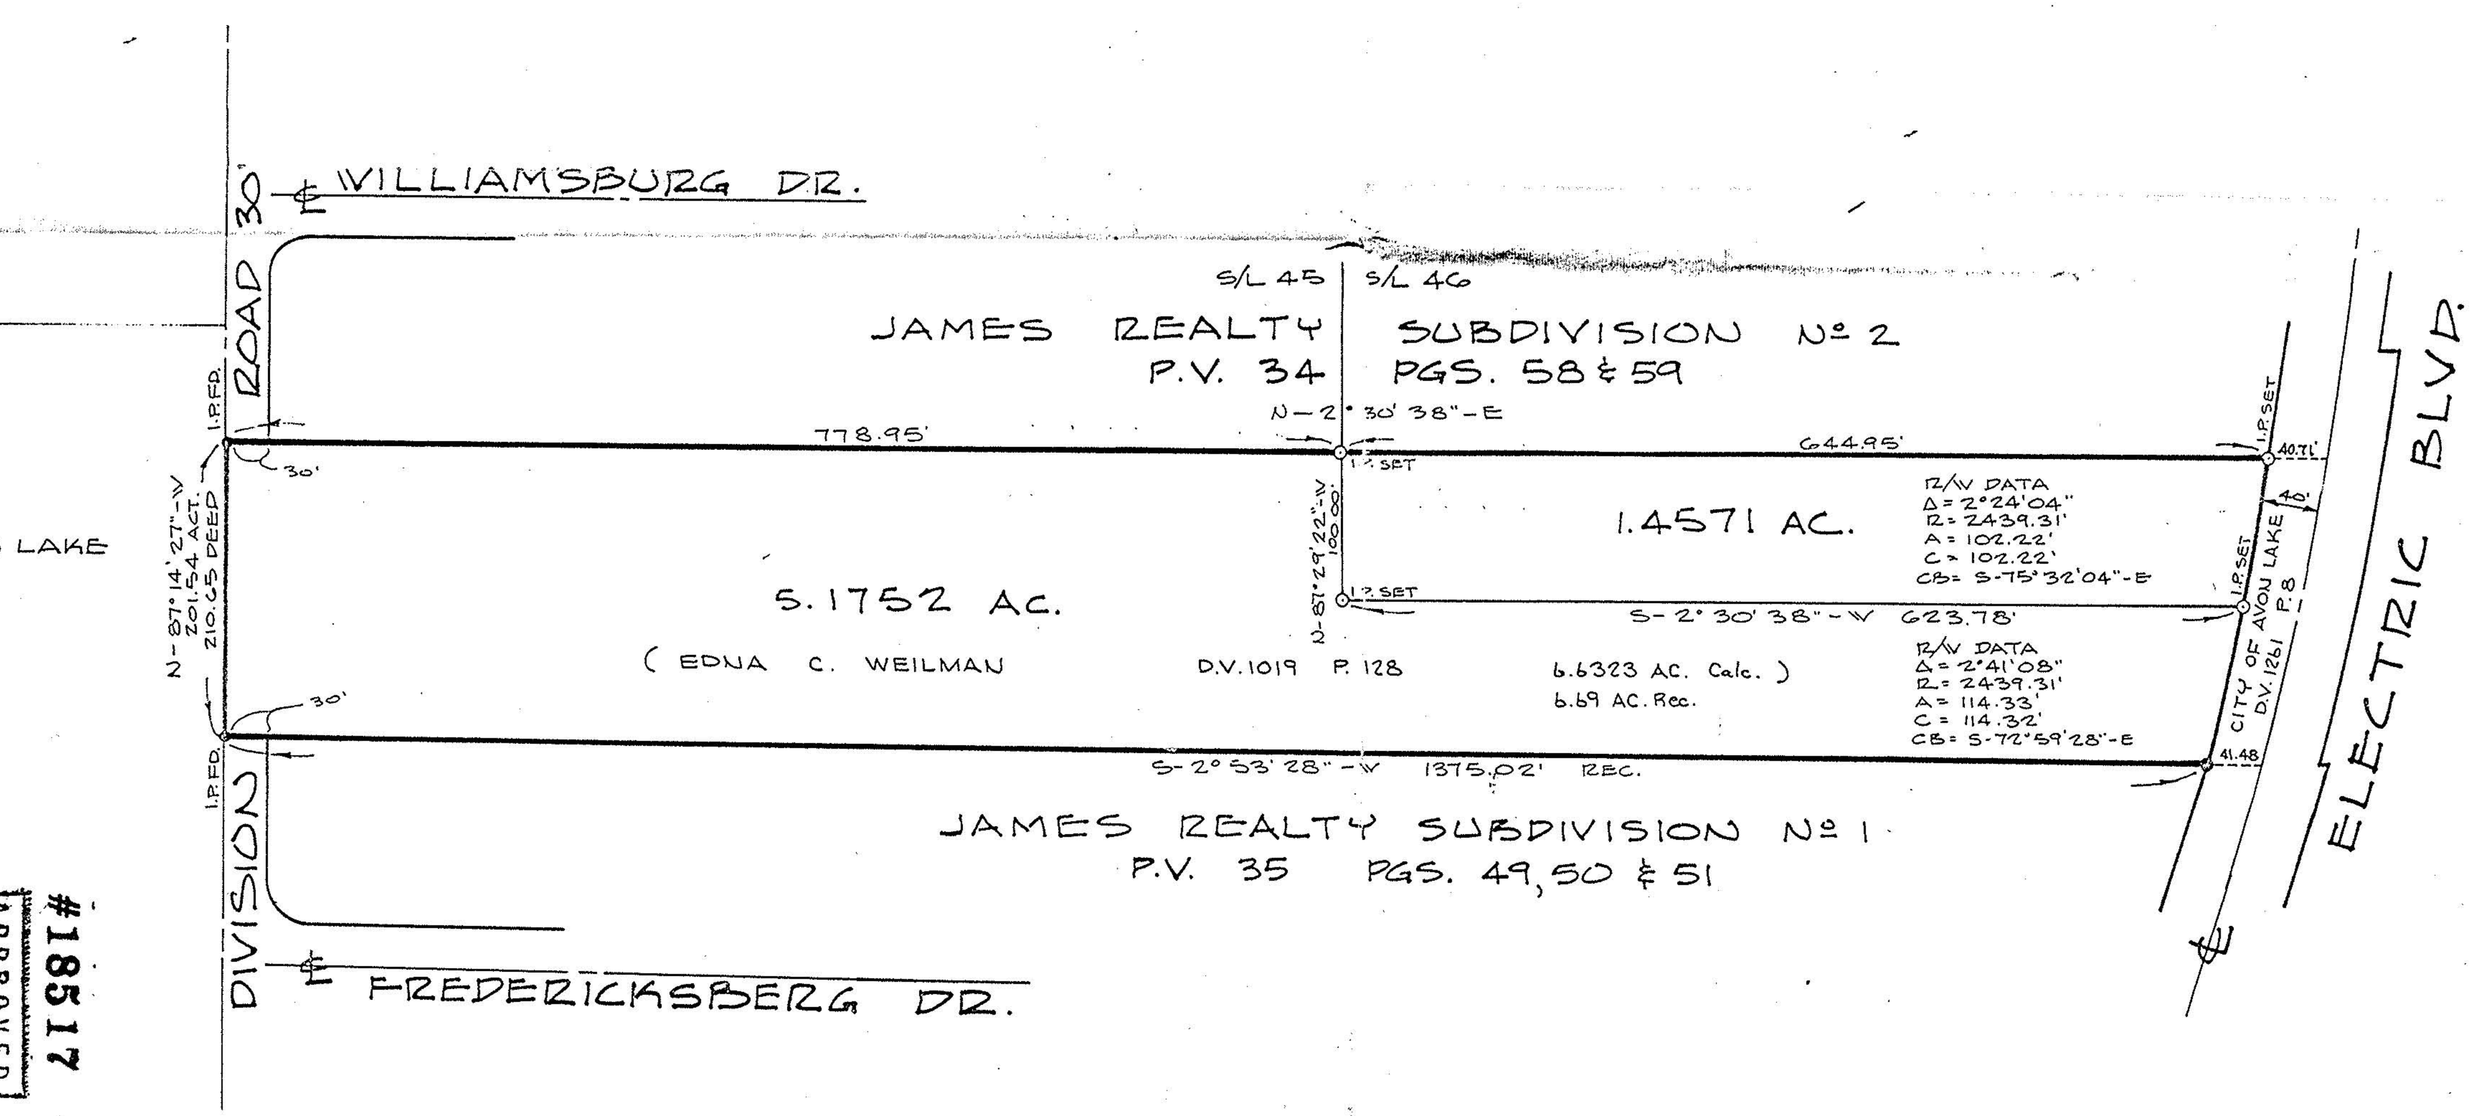

APPROVED
LORAIN CO.
MAP DEPT.
DATE 7-10-89
PAGE 4-00-019-D
BY T. Mayhew
VOID AFTER 18517

#18517

STATE OF OHIO
DAVID L. ELWELL
6333
REGISTERED SURVEYOR

David L. Elwell
REG. SURVEYOR
2-10-89

KCI

ENGINEERS/SURVEYORS
KS ASSOCIATES INCORPORATED
424 Middle Avenue
P.O. Box 89