



* THIS IS MAP USED WHEN GREEN PAINTED & 7 WERE BROUGHT IN 5-7-81 SEE LINN MCKINNS ABOUT ANY CORRECTIONS, ADDITIONS, OR DELETIONS TO THIS MAP.

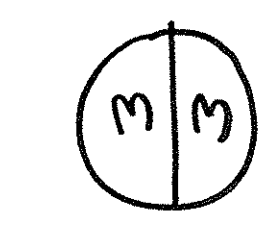

SURVEY OF PART OF ORIGINAL AVON TOWNSHIP SECTION 19 CITY OF AVON OHIO COUNTY OF LOHAIN STATE OF OHIO
 PREPARED BY KLEINODER-SCHMIDT & ASSOCIATES CONSULTING ENGINEERS & SURVEYORS
 ELYRIA, OHIO
 REV. JUNE 1978 L.V.M.
 REV. AUGUST 1979 L.V.M.
 REV. MARCH 1980 L.V.M.

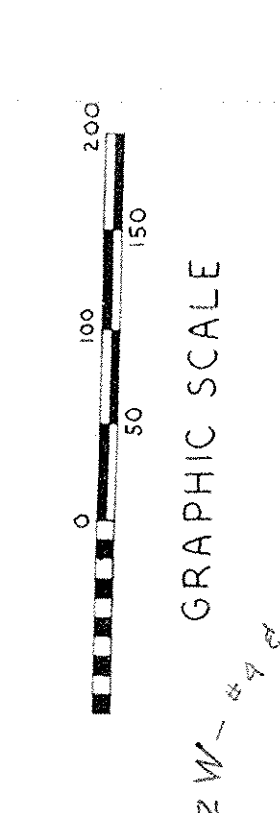

RADIUS	DELTA	ARC	CHORD	BEARING
A 330.00'	2.75140"	16.96'	16.96'	S. 85° 55' 27" E
B 464.30'	5.70423"	42.88'	42.87'	S. 85° 55' 27" E
C 304.00'	1.47709"	94.75'	94.75'	N. 71° 00' 57" W
D 25.00'	1.472630"	54.80'	44.24'	N. 71° 00' 57" W
E 2866.00'	1.70156"	69.69'	69.68'	N. 107° 00' 28" W