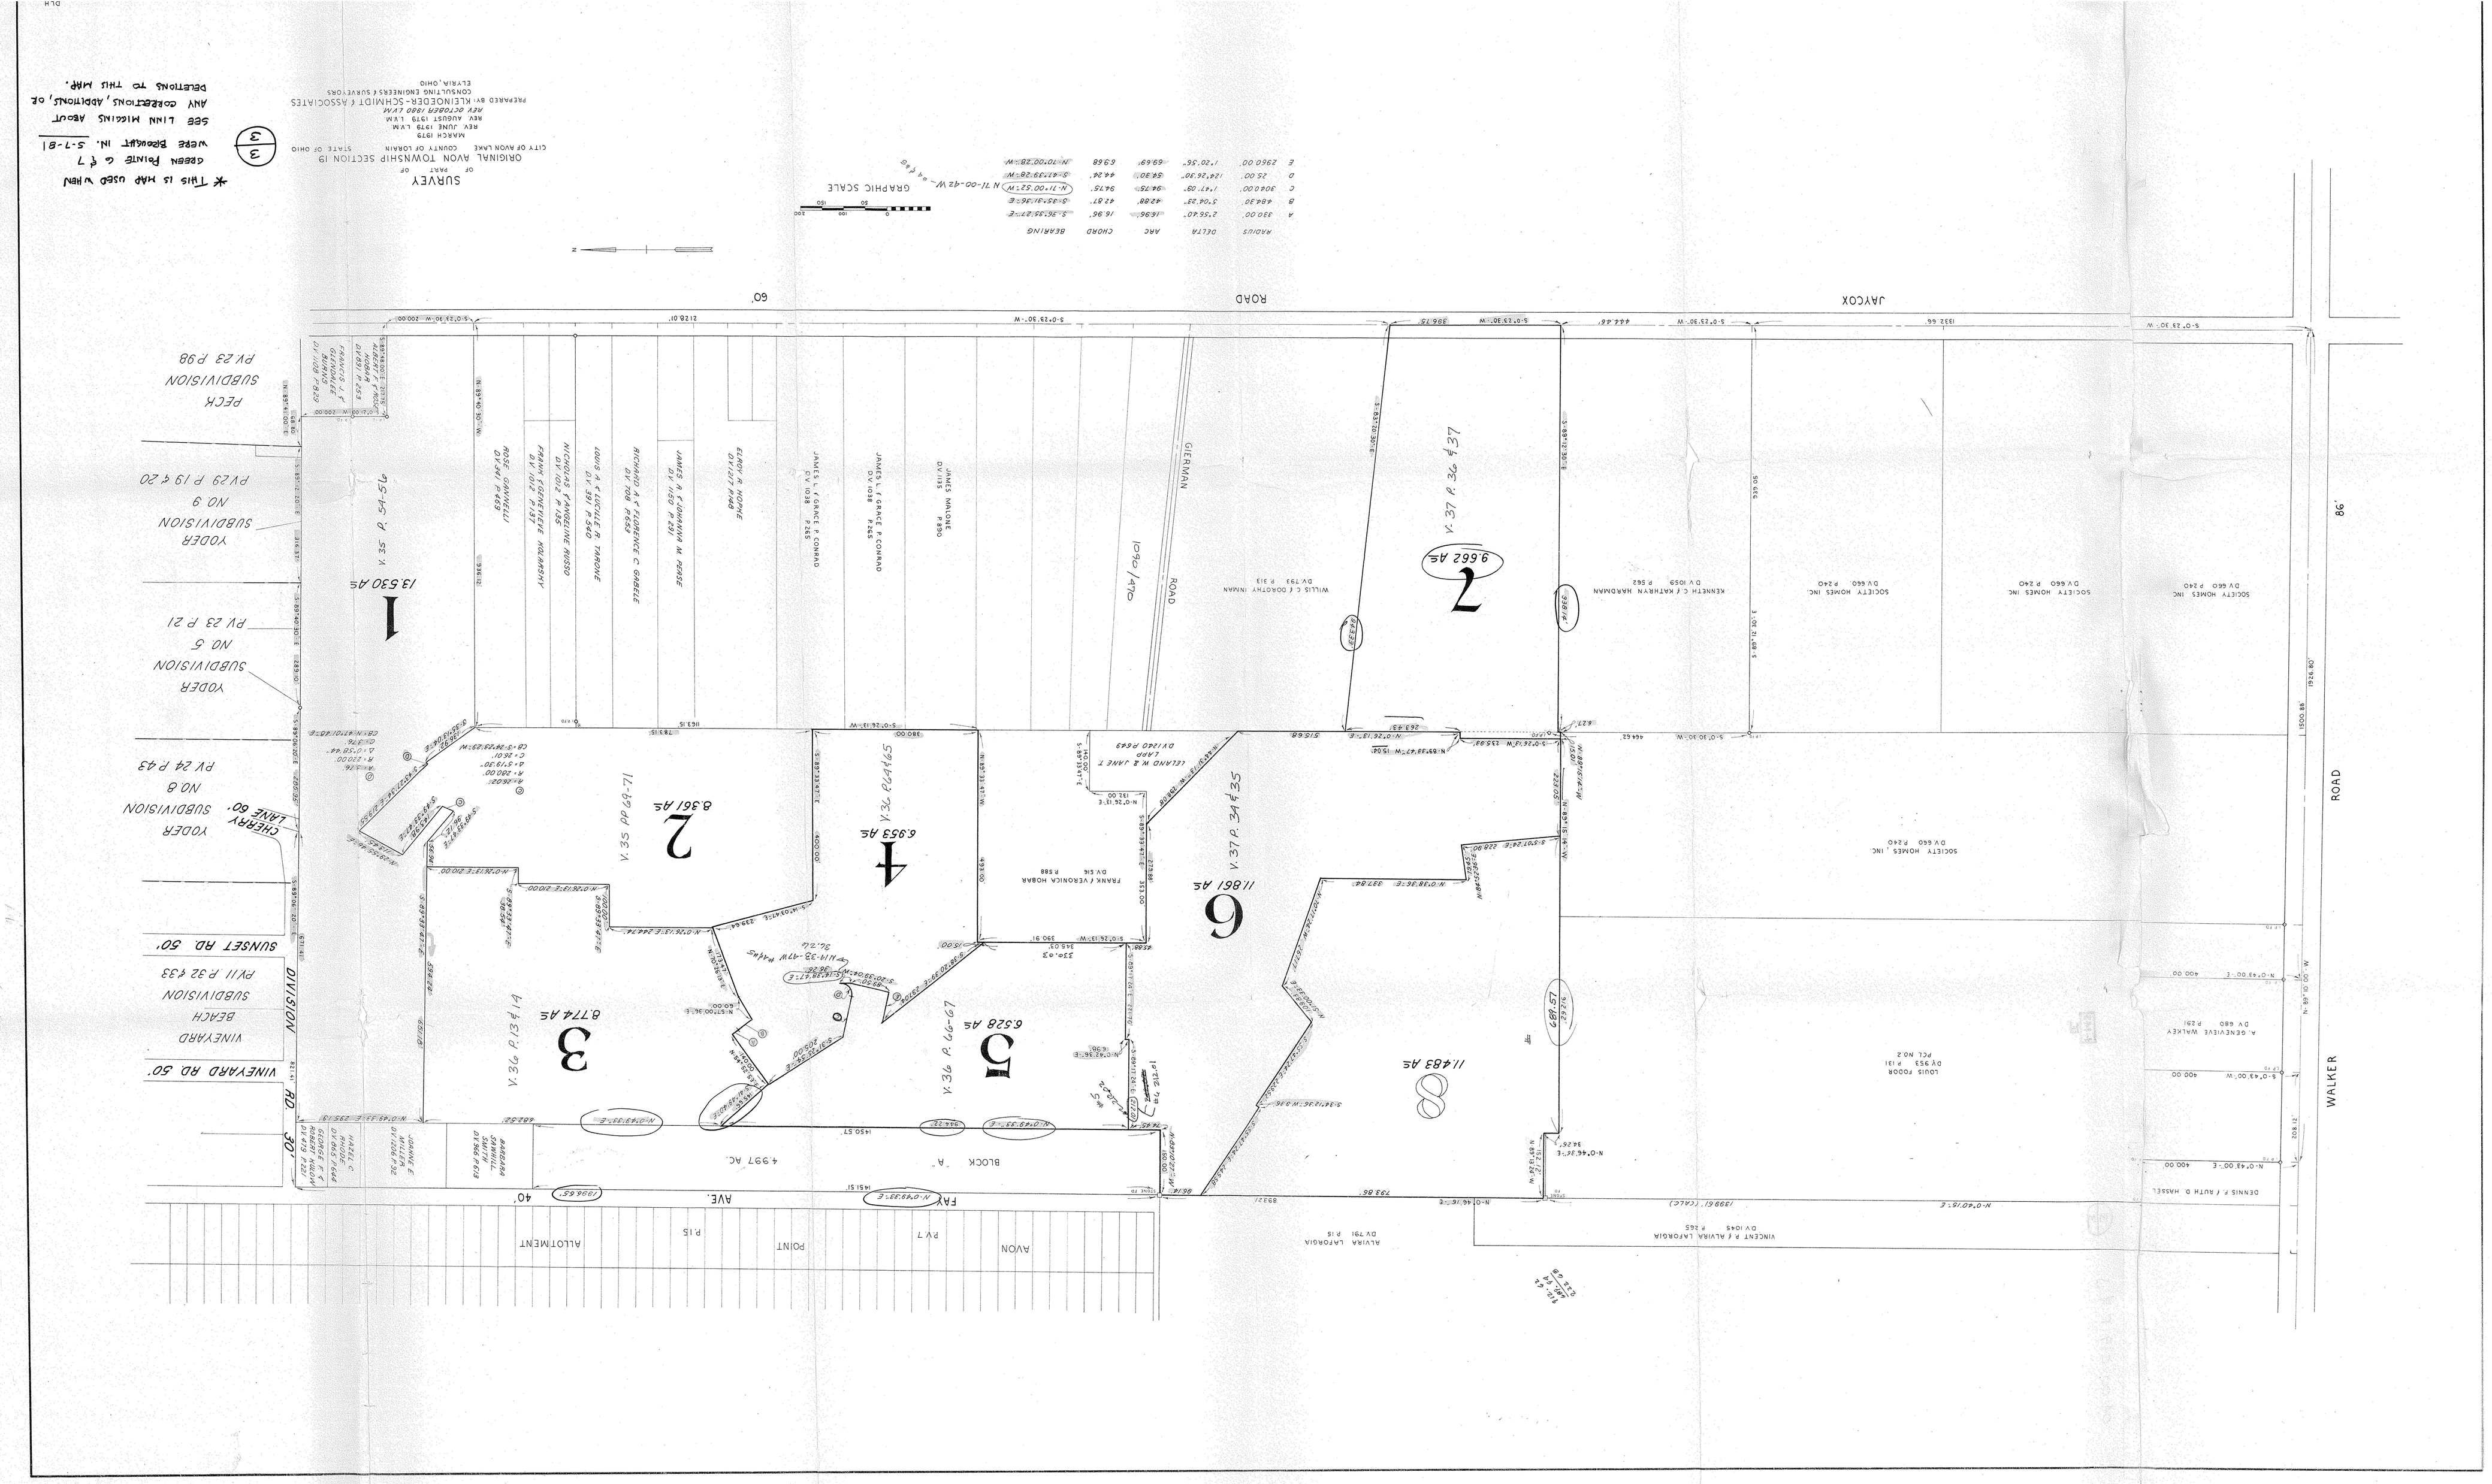
SURVEY
ORIGINAL AVON TOWNSHIP SECTION 19
OF PART OF
CITY OF AVON LAKE COUNTY OF LORAIN STATE OF OHIO
MARCH 1979
REV JUNE 1979 LVM
REV AUGUST 1979 LVM
REV OCTOBER 1980 LVM
PREPARED BY KLEINOEDER-SCHMIDT & ASSOCIATES
CONSULTING ENGINEERS & SURVEYORS
ELYRIA, OHIO
GRAPHIC SCALE
3
* THIS IS MAP USED WHEN
GREEN POINTE & #7
WERE BROUGHT IN. S-7-81
SEE LINN MICCIAS ABOUT
ANY CORRECTIONS, ADDITIONS, OR
DELETIONS TO THIS MAP.
JAYCOX ROAD 60'
WALKER ROAD
GERMAN ROAD
CHERRY LANE 60'
SUNSET RD. 50'
VINEYARD RD 50'
FAY AVE. 40'
AVON POINT ALLOTMENT
BLOCK "A" 4.997 AC.
1 13.530 AS
2 8.361 AS
3 8.774 AS
4 6.953 AS
5 6.528 AS
6 11.861 AS
7 9.662 AS
8 11.483 AS
YODER SUBDIVISION NO. 5 PV 23 P 21
YODER SUBDIVISION NO. 9 PV29 P 19 & 20
PECK SUBDIVISION PV 23 P98
YODER SUBDIVISION NO. 8 PV 24 P 43
VINEYARD BEACH SUBDIVISION PV11 P 32 & 33
SOCIETY HOMES INC DV 660 P 240
KENNETH C & KATHRYN HARRAMAN DV 1059 P 562
WILLIS C & DOROTHY INMAN DV 793 P 313
JAMES L & GRACE P CONRAD DV 1038 P 265
JAMES L & GRACE P CONRAD DV 1038 P 265
JAMES MALONE DV 1135 P 820
GLORIA P HOPPE DV 617 P 149
RICHARD A & FLORENCE C GABELE DV 708 P 659
LOUIS A & LUCILLE R TARONE DV 391 P 540
JAMES A & MARYANN M PERSE DV 150 P 139
NICHOLAS & PAULINE RISTO DV 1012 P 135
FRANK & GENEVIEVE KOVARSKY DV 1012 P 137
ROSE CARNELLI DV 141 P 469
FRANK & VERONICA HOBAR DV 516 P 588
CLEANO W & JANE T LAPP DV 1260 P 649
VINCENT P & ALVIRA LAFORGIA DV 1045 P 265
ALVIRA LAFORGIA DV 791 P 18
LOUIS FOOOR DV 953 P 131 PCL NO. 2
A. GENEVIEVE WALKER DV 680 P 291
DENNIS F & RUTH D HASSEL
JOANNE E MILLER DV 1208 P 36
MICHAEL C PRUSSE DV 1065 P 664
GEORGE W & MARGARET A SMITH DV 1134 P 1
MARGARET A BARNHARD DV 1134 P 1
N 1500.88
1926.80'
N 00°08'46" W