DIMENSIONS SHOWN ON THIS PLAT ARE EXPRESSED IN FEET AND DECIMAL PARTS THEREOF, ALL BEARINGS ARE TO AN ASSUMED MERIDIAN AND ARE USED TO INDICATE ANGLES ONLY. PERMANENT MONUMENTS WERE FOUND OR SET AT ALL POINTS INDICATED HEREON, ALL OF WHICH I CERTIFY TO BE CORRECT.

STATE OF OHIO
THOMAS A. SIMON
S 7775
REGISTERED
PROFESSIONAL SURVEYOR

THOMAS A. SIMON
REG. PROFESSIONAL SURVEYOR
NO. S-7775

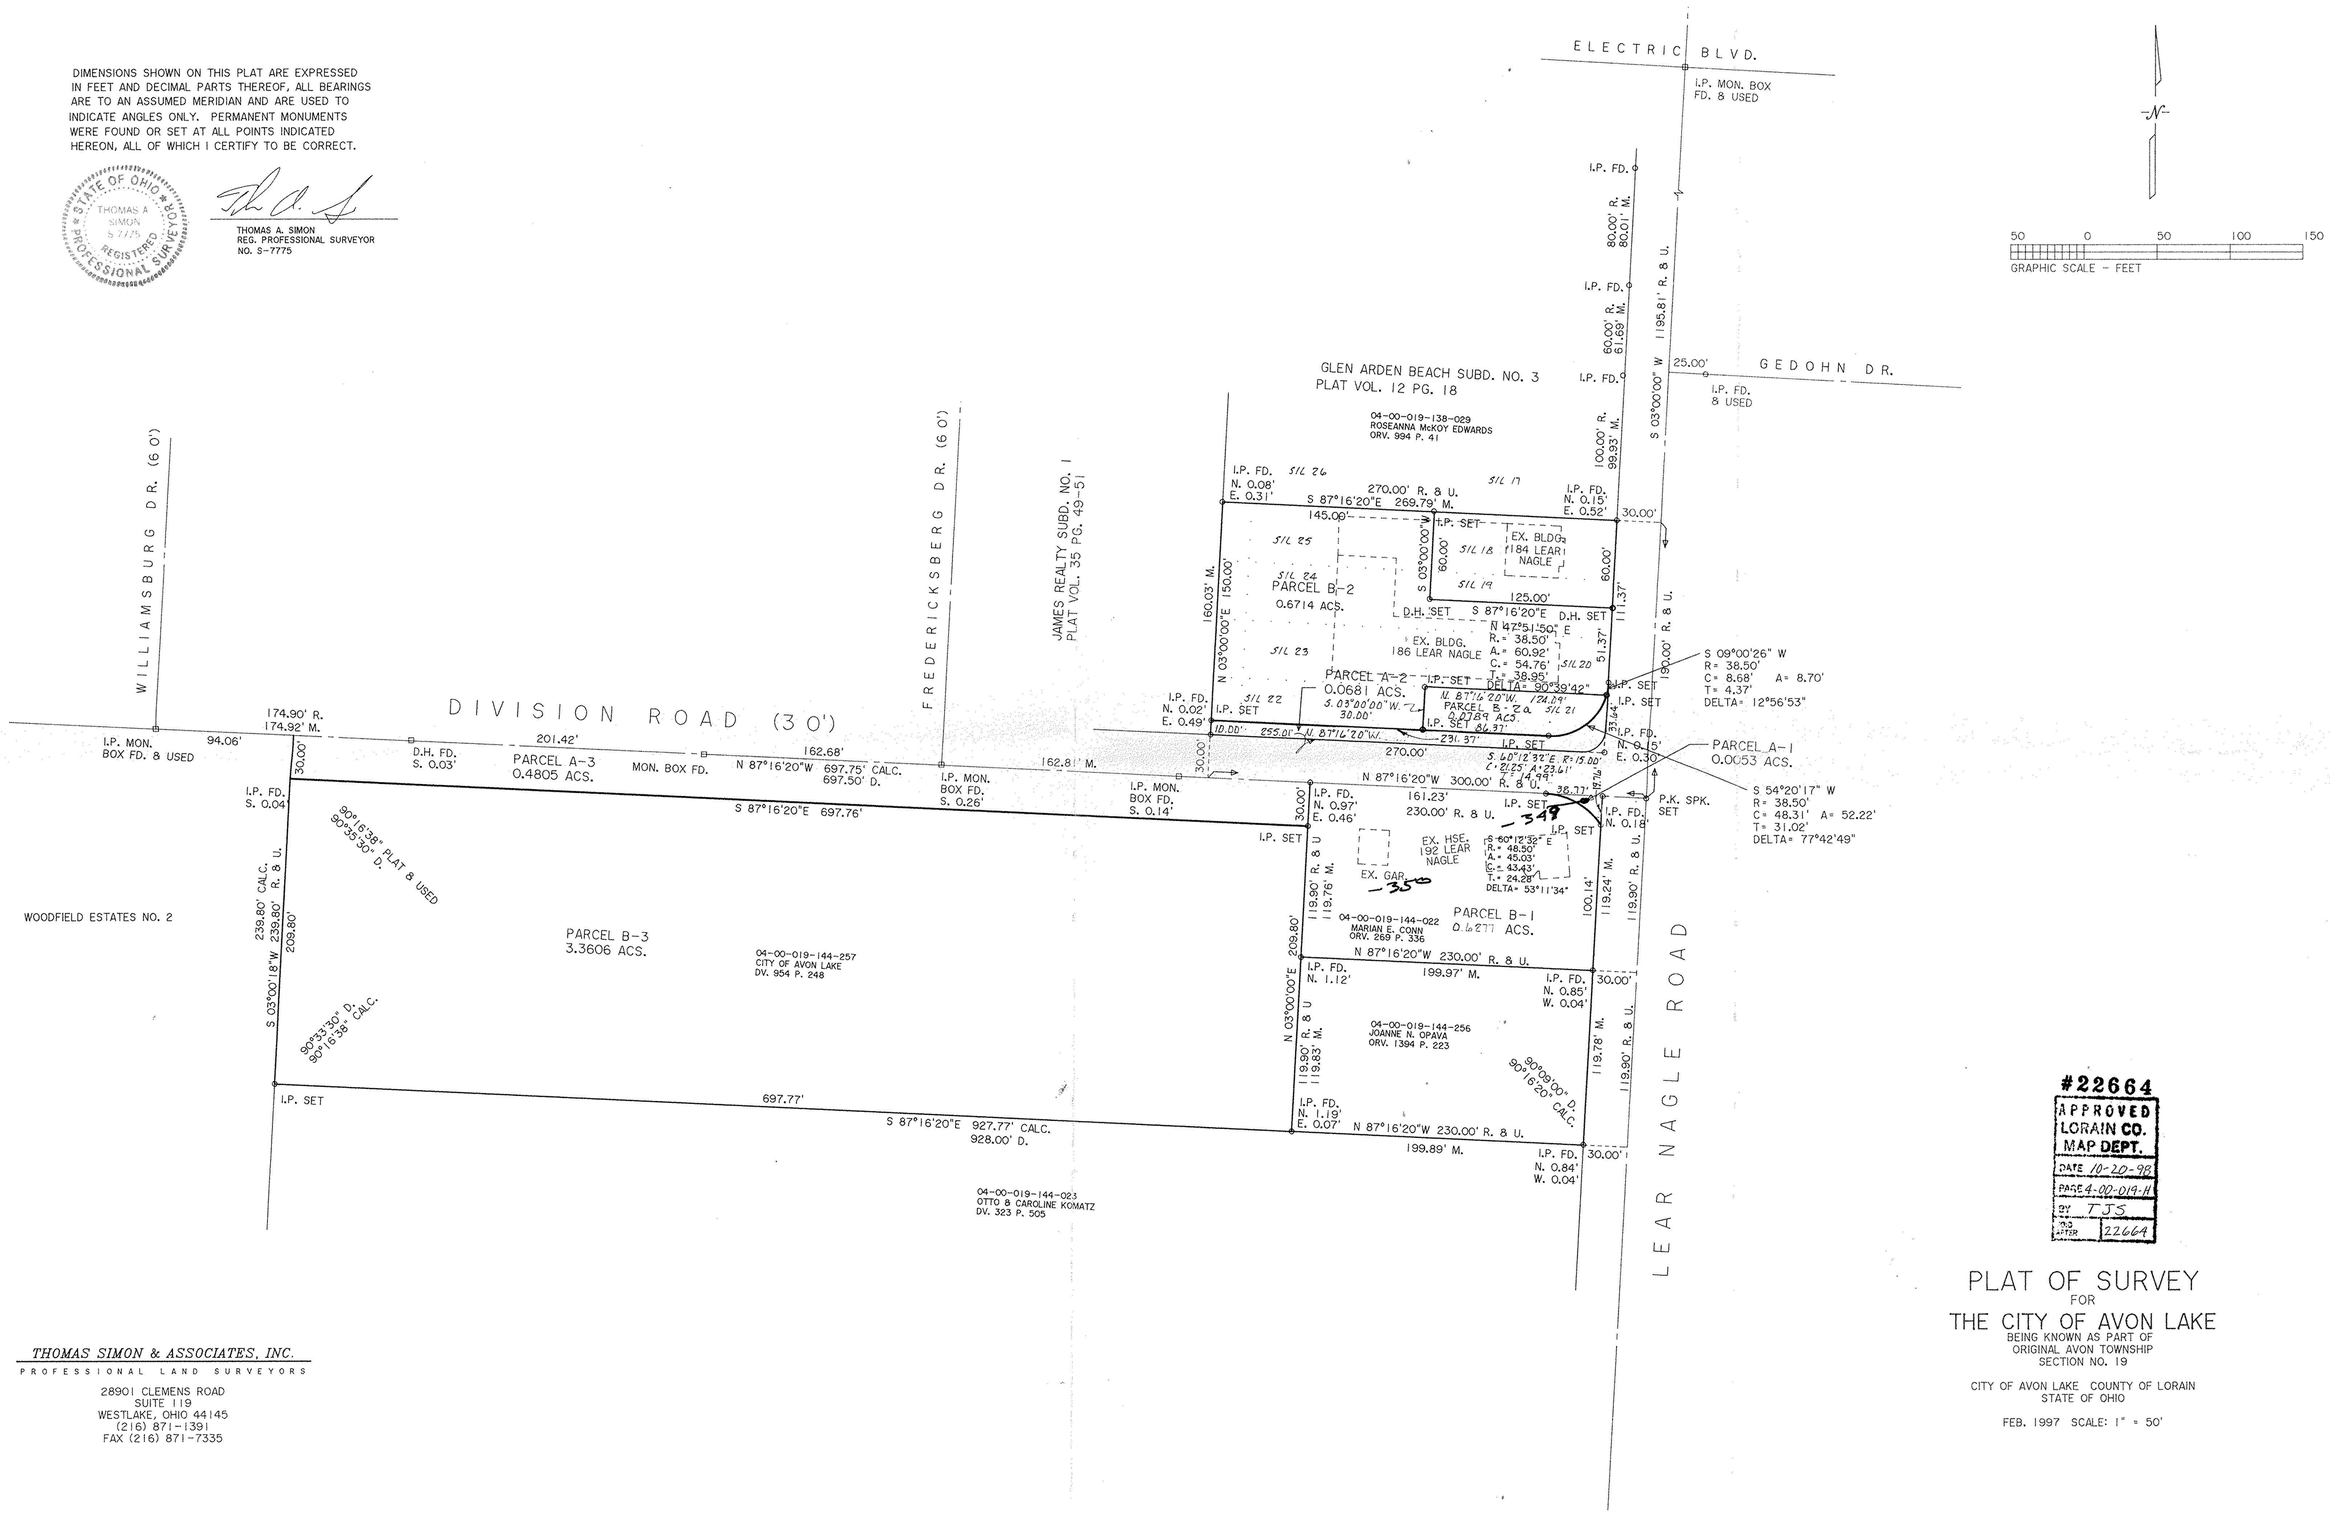

#22664
APPROVED
LORAIN CO.
MAP DEPT.
DATE 10-20-98
PARCEL 4-00-019-11
BY TJS
NO. AFTER 22664

PLAT OF SURVEY
FOR
THE CITY OF AVON LAKE
BEING KNOWN AS PART OF
ORIGINAL AVON TOWNSHIP
SECTION NO. 19

CITY OF AVON LAKE COUNTY OF LORAIN
STATE OF OHIO

FEB. 1997 SCALE: 1" = 50'

THOMAS SIMON & ASSOCIATES, INC.
PROFESSIONAL LAND SURVEYORS

28901 CLEMENS ROAD
SUITE 119
WESTLAKE, OHIO 44145
(216) 871-1391
FAX (216) 871-7335

REV. 7-3-98 - PARCEL B-1 ACS.