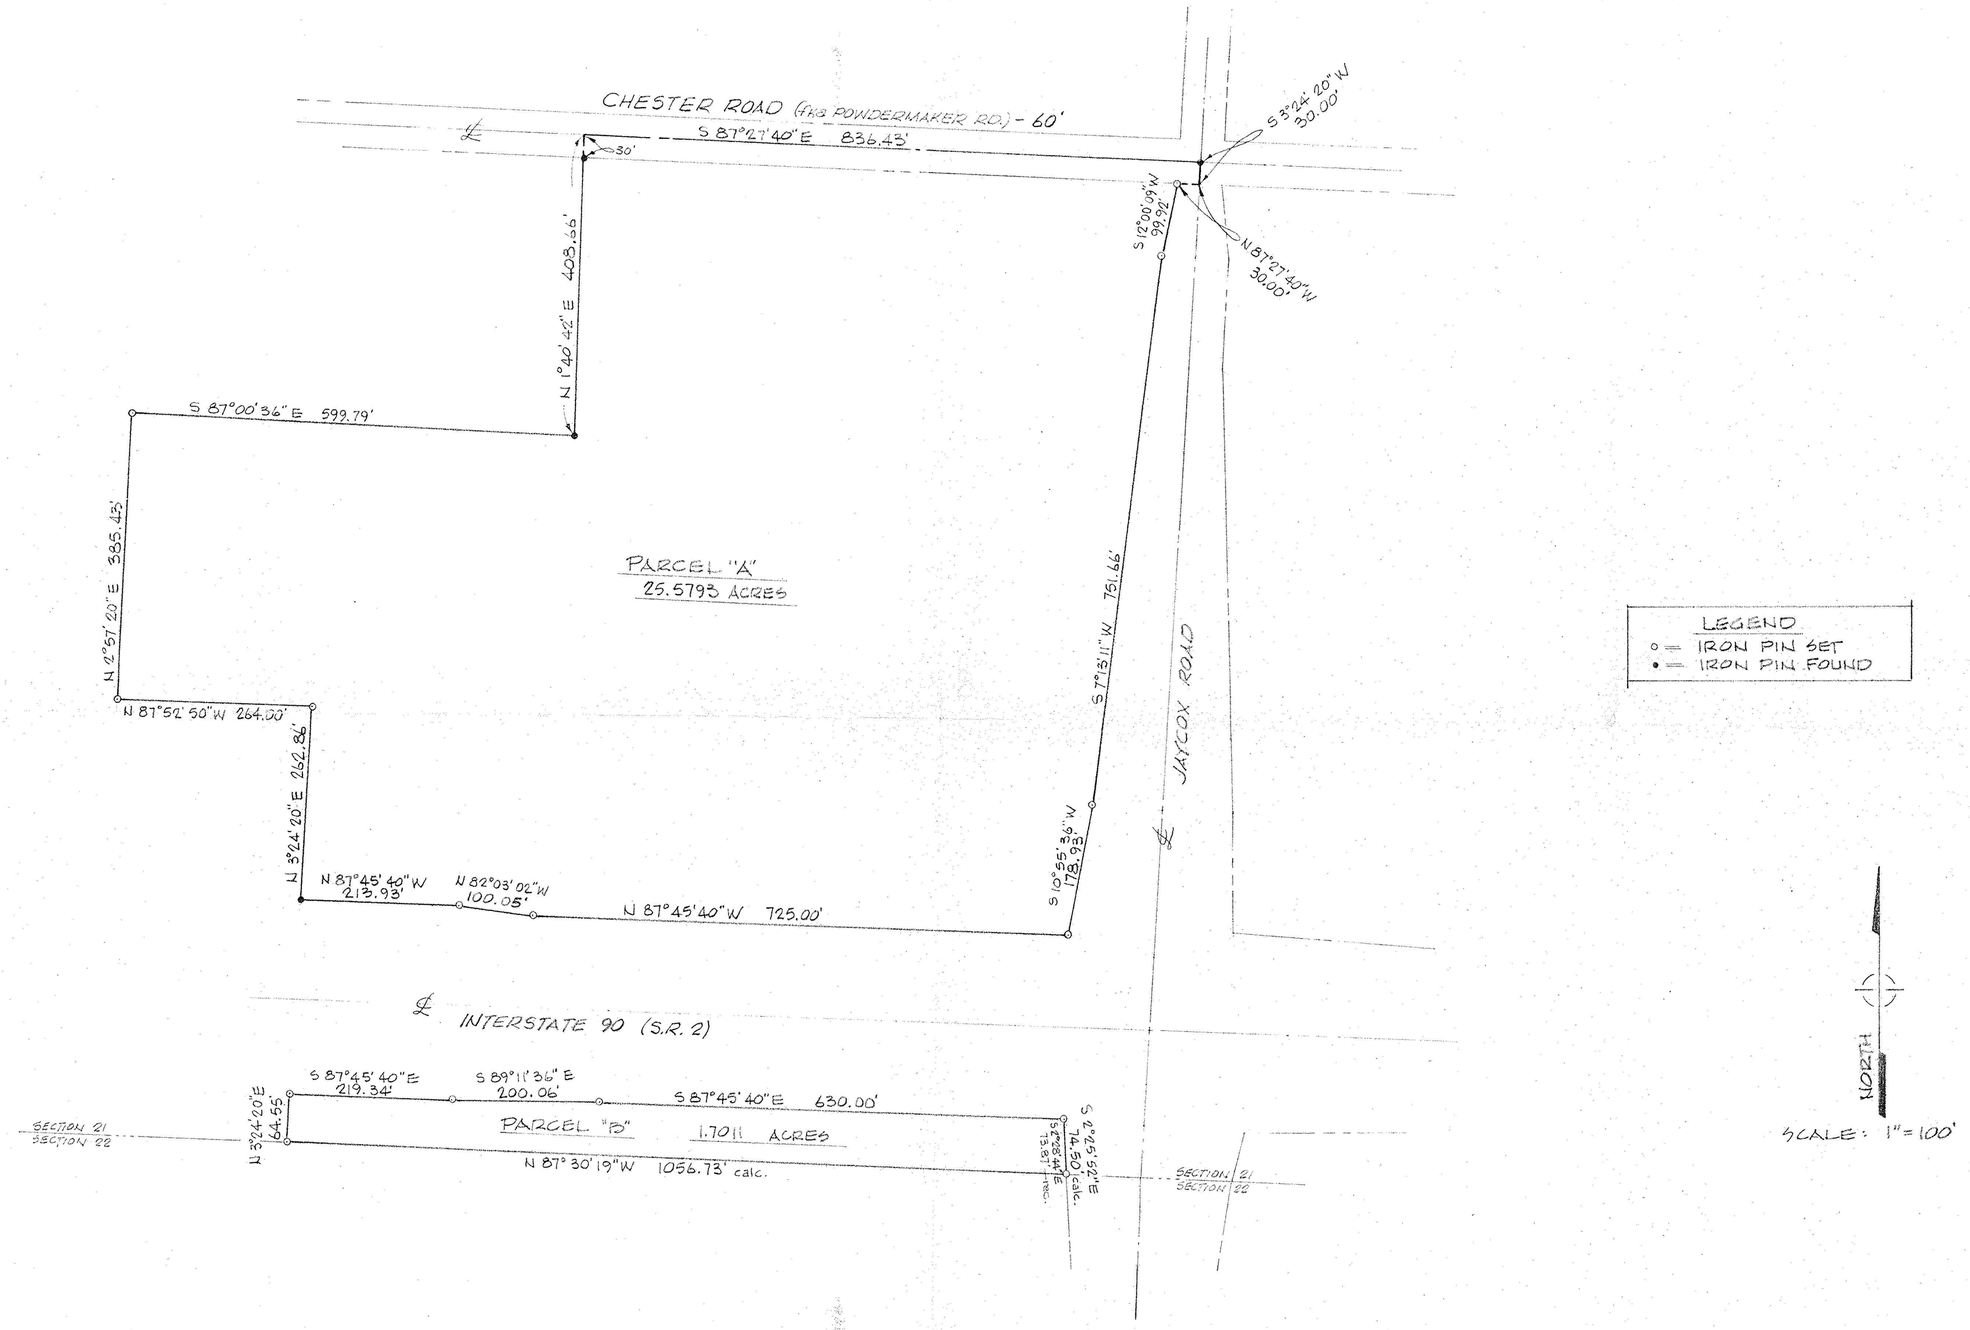

MAP of BOUNDARY SURVEY

PREPARED FOR ATT'Y. V. PAUL TIMKO

PART of ORIGINAL AVON TOWNSHIP SECTION No. 21

CITY of AVON LORAIN COUNTY OHIO

McGLINCHY and ASSOCIATES, INC.
PROFESSIONAL ENGINEER & SURVEYORS
110½ MIDDLE AVE. ELYRIA, OHIO
NOVEMBER, 1981 # 817039