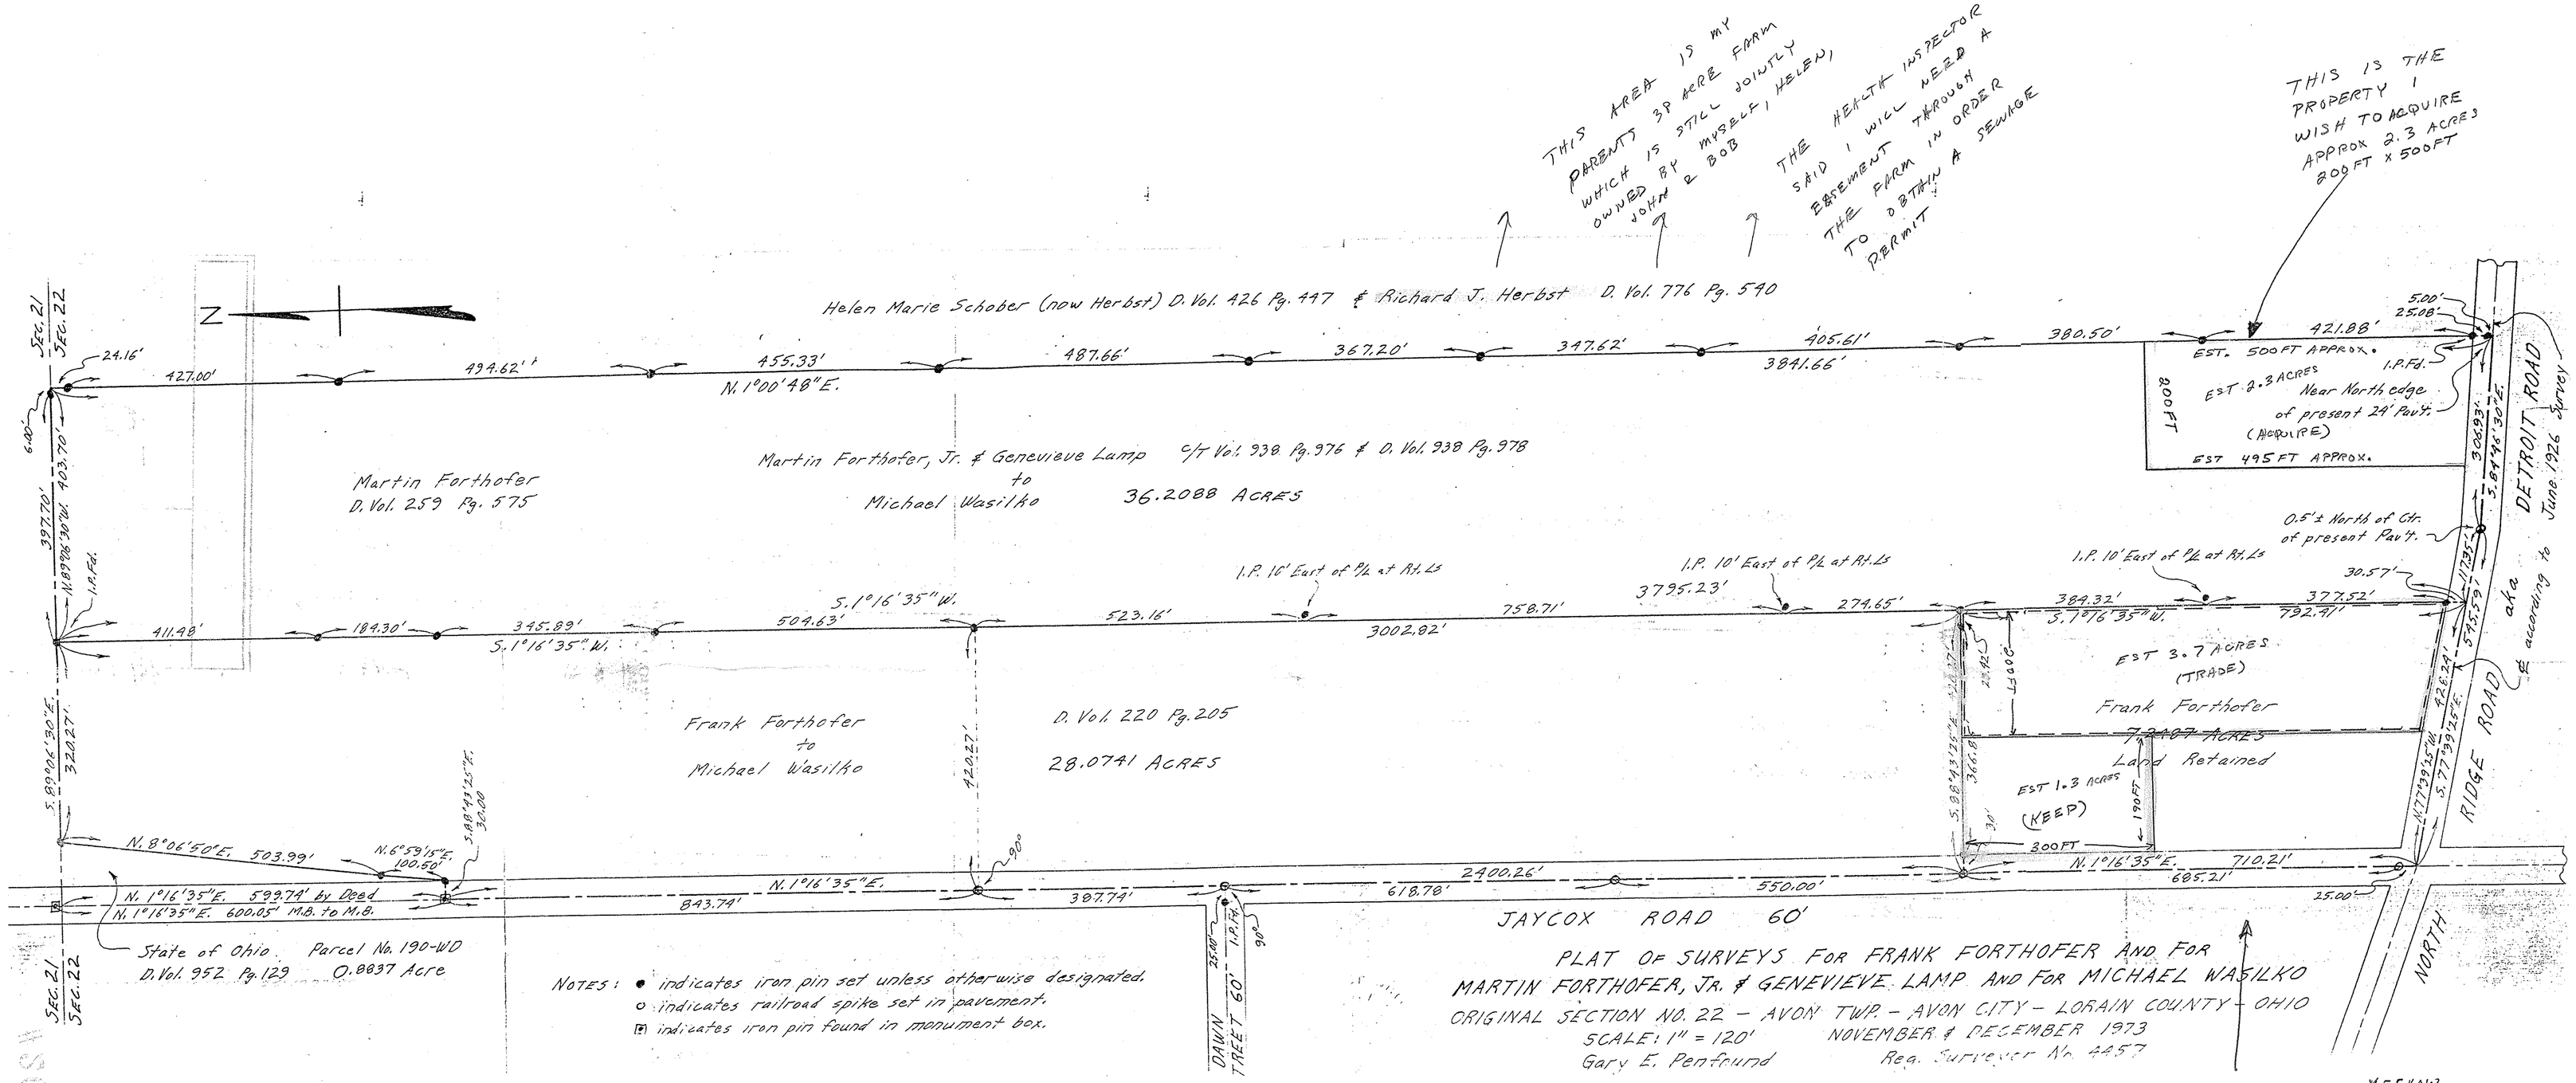


NOTES: ● indicates iron pin set unless otherwise designated.
○ indicates railroad spike set in pavement.
▣ indicates iron pin found in monument box.

THE ABOVE AREA OUTLINED IN YELLOW IS THE PROPERTY I PRESENTLY OWN. THE AREA OUTLINE IN RED (3.7 ACRES) IS THE PROPERTY WASILKO WANTS TO EXCHANGE FOR THE PROPERTY I WISH TO AQUIRE. I WOULD KEEP THE 300 FT X 190 FT (1.3 ACRES) ON JAYCOX.

| | |
|---|---|
| **P.P. NO.** 04-00-022-102-049 | |
| **SPLIT #** 20108 | **DATE OF SURVEY** December, 1973 |
| **MAP PAGE** 4-00-022-G | |
| **SURVEYOR** Gary E. Penfound | |