



4-00-22 E

9278
400-022 E

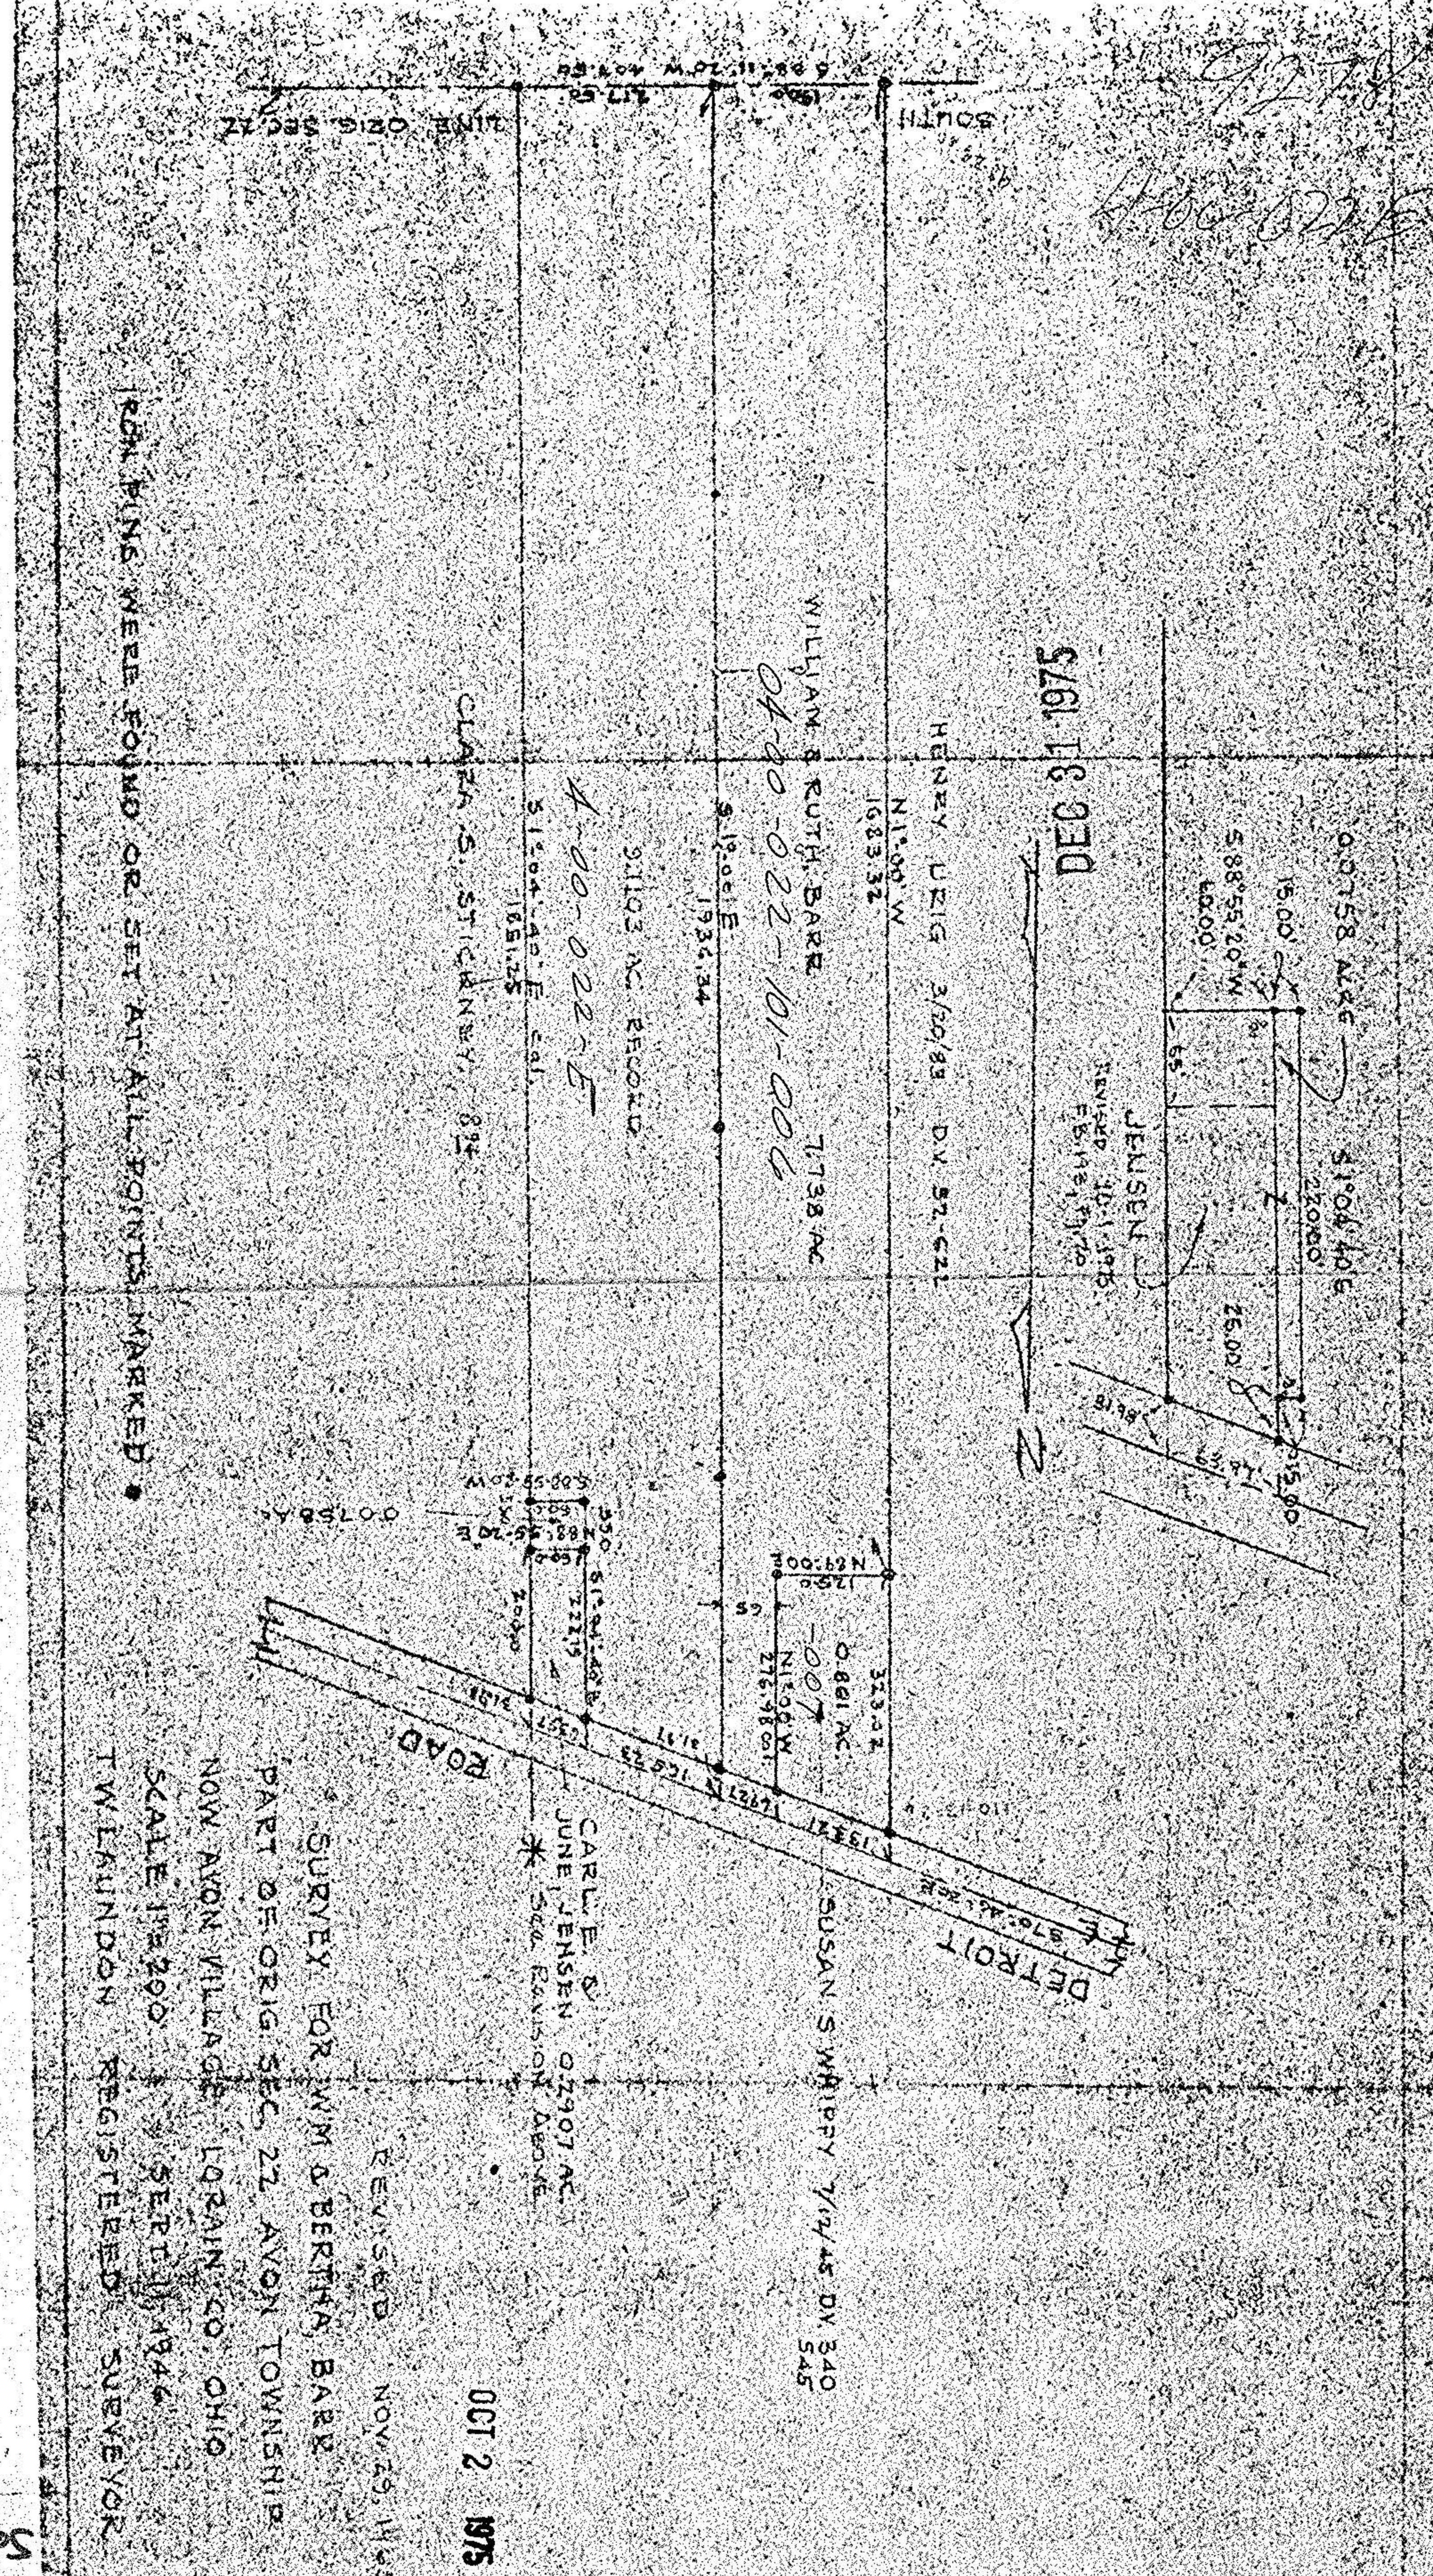

NOV 26 1975

Sec. 22
4

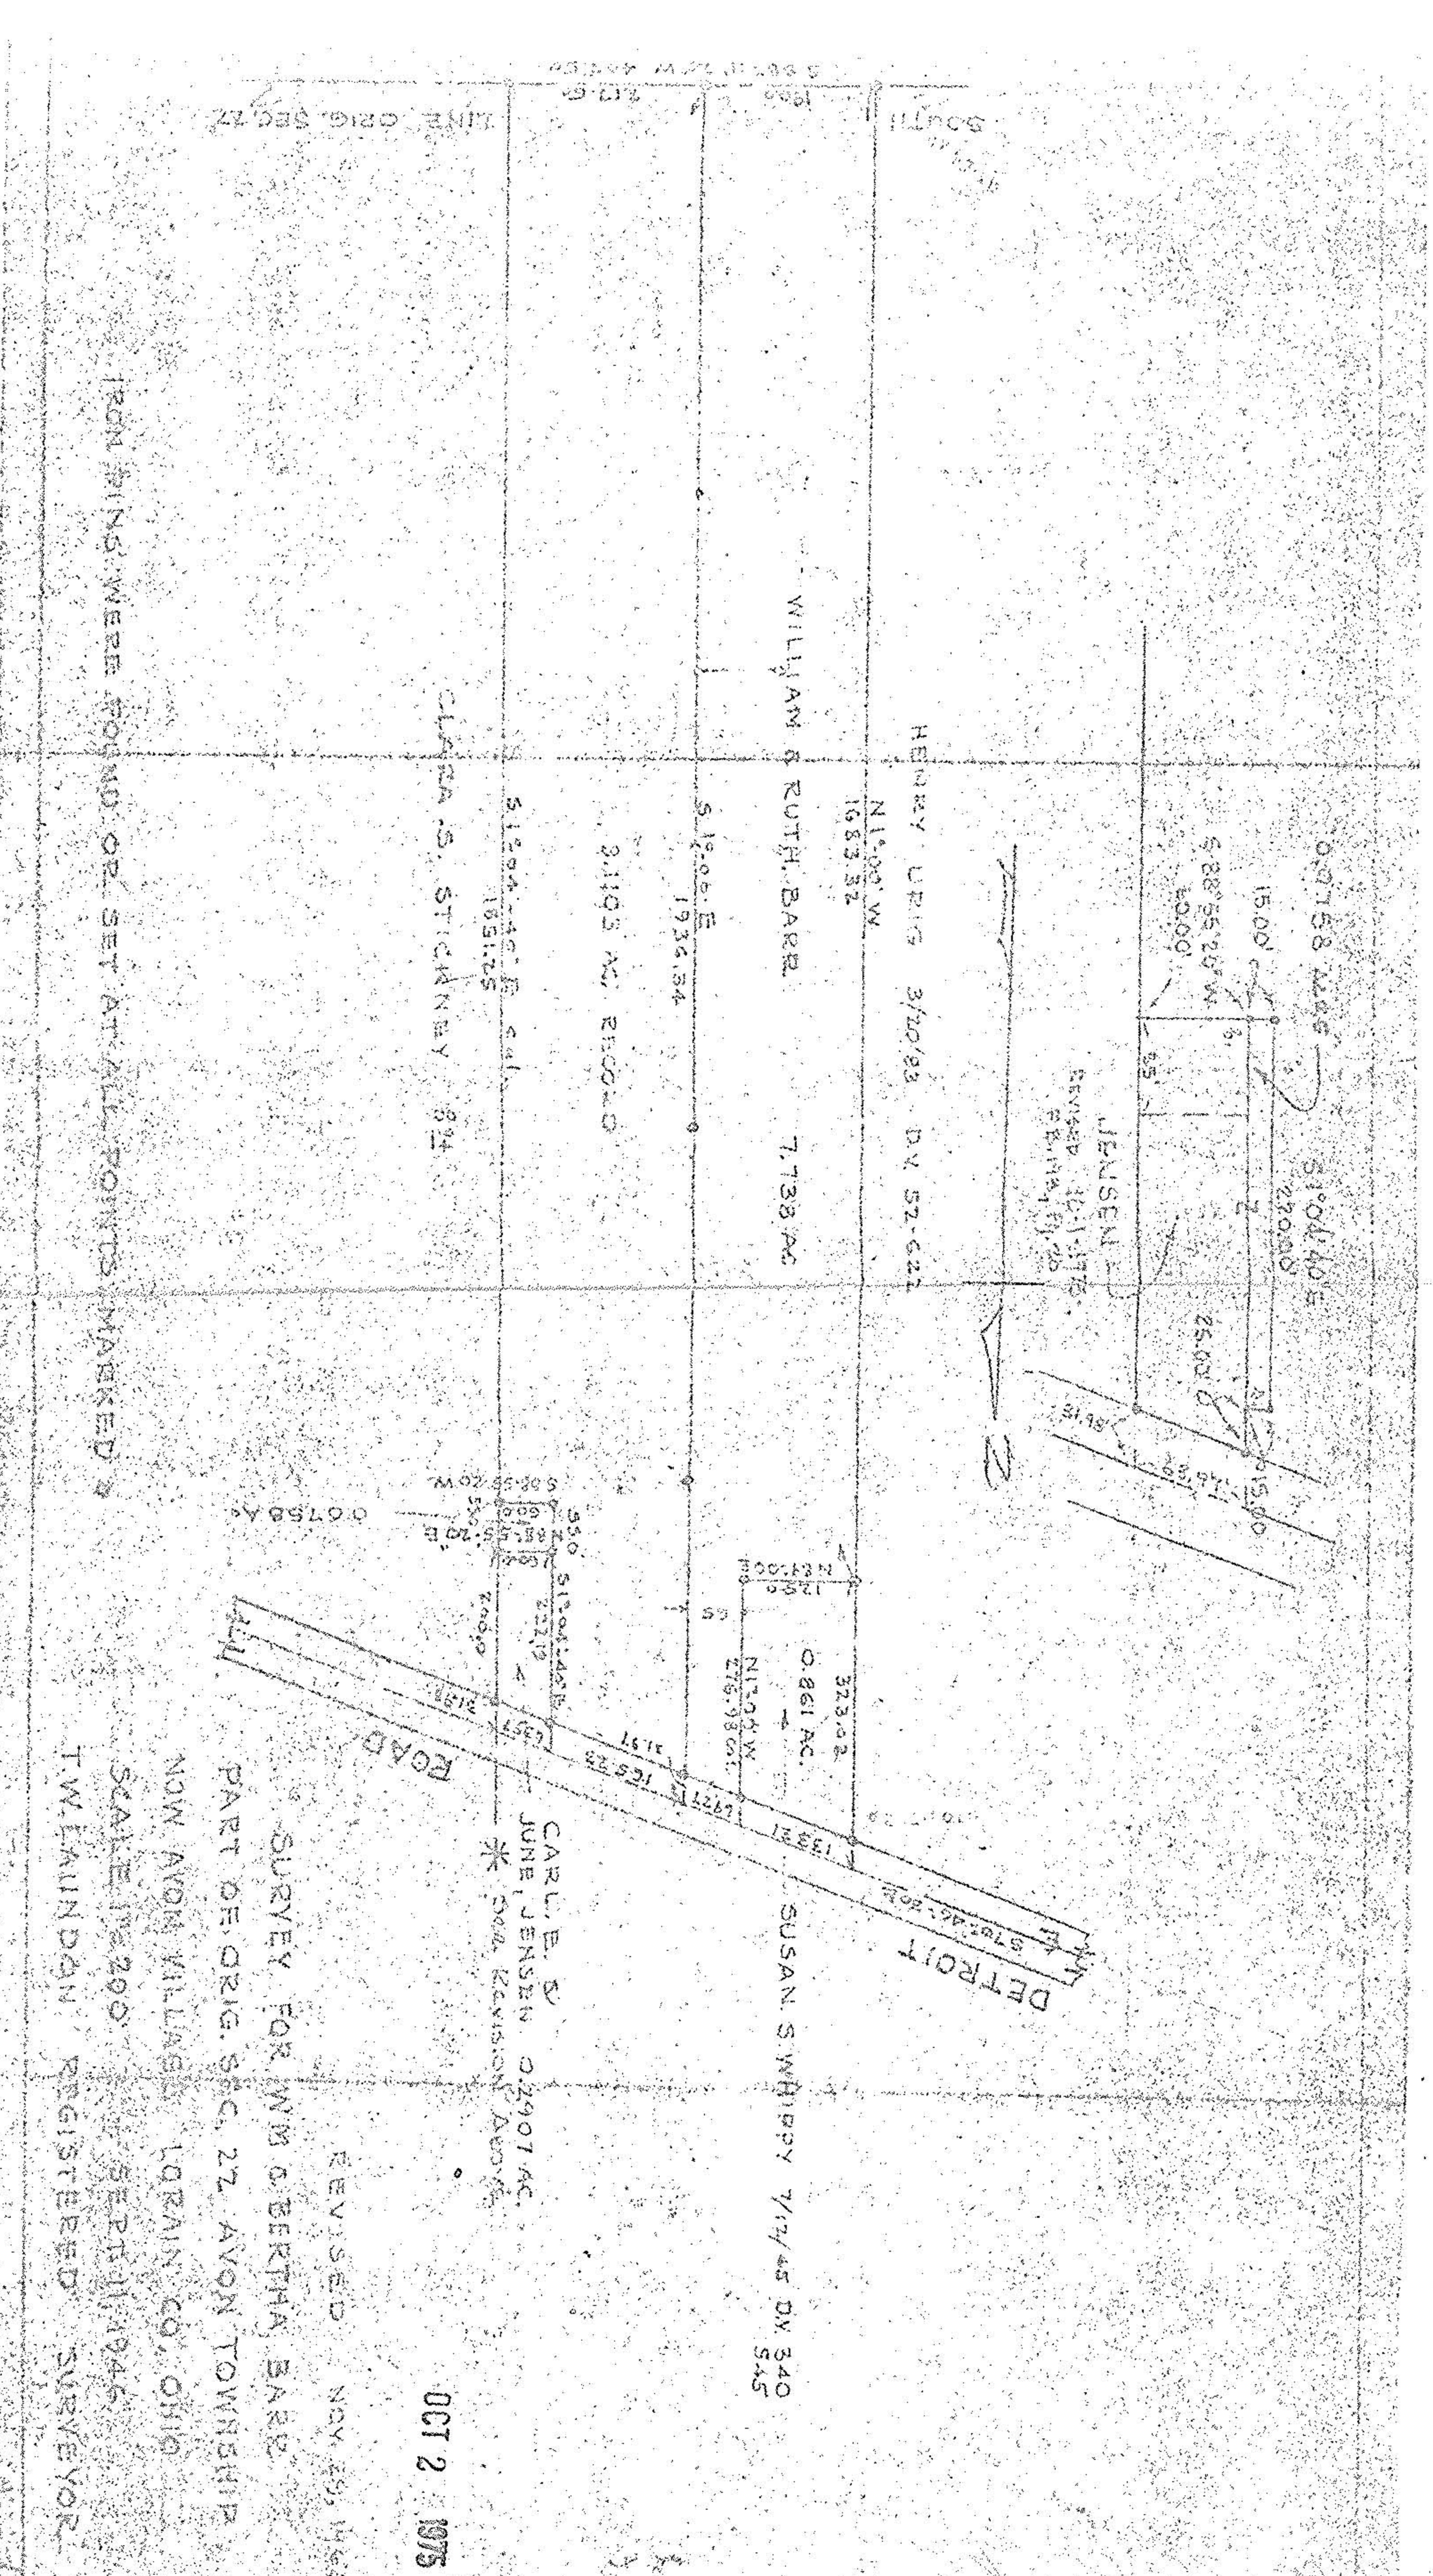

OCT 2 1975