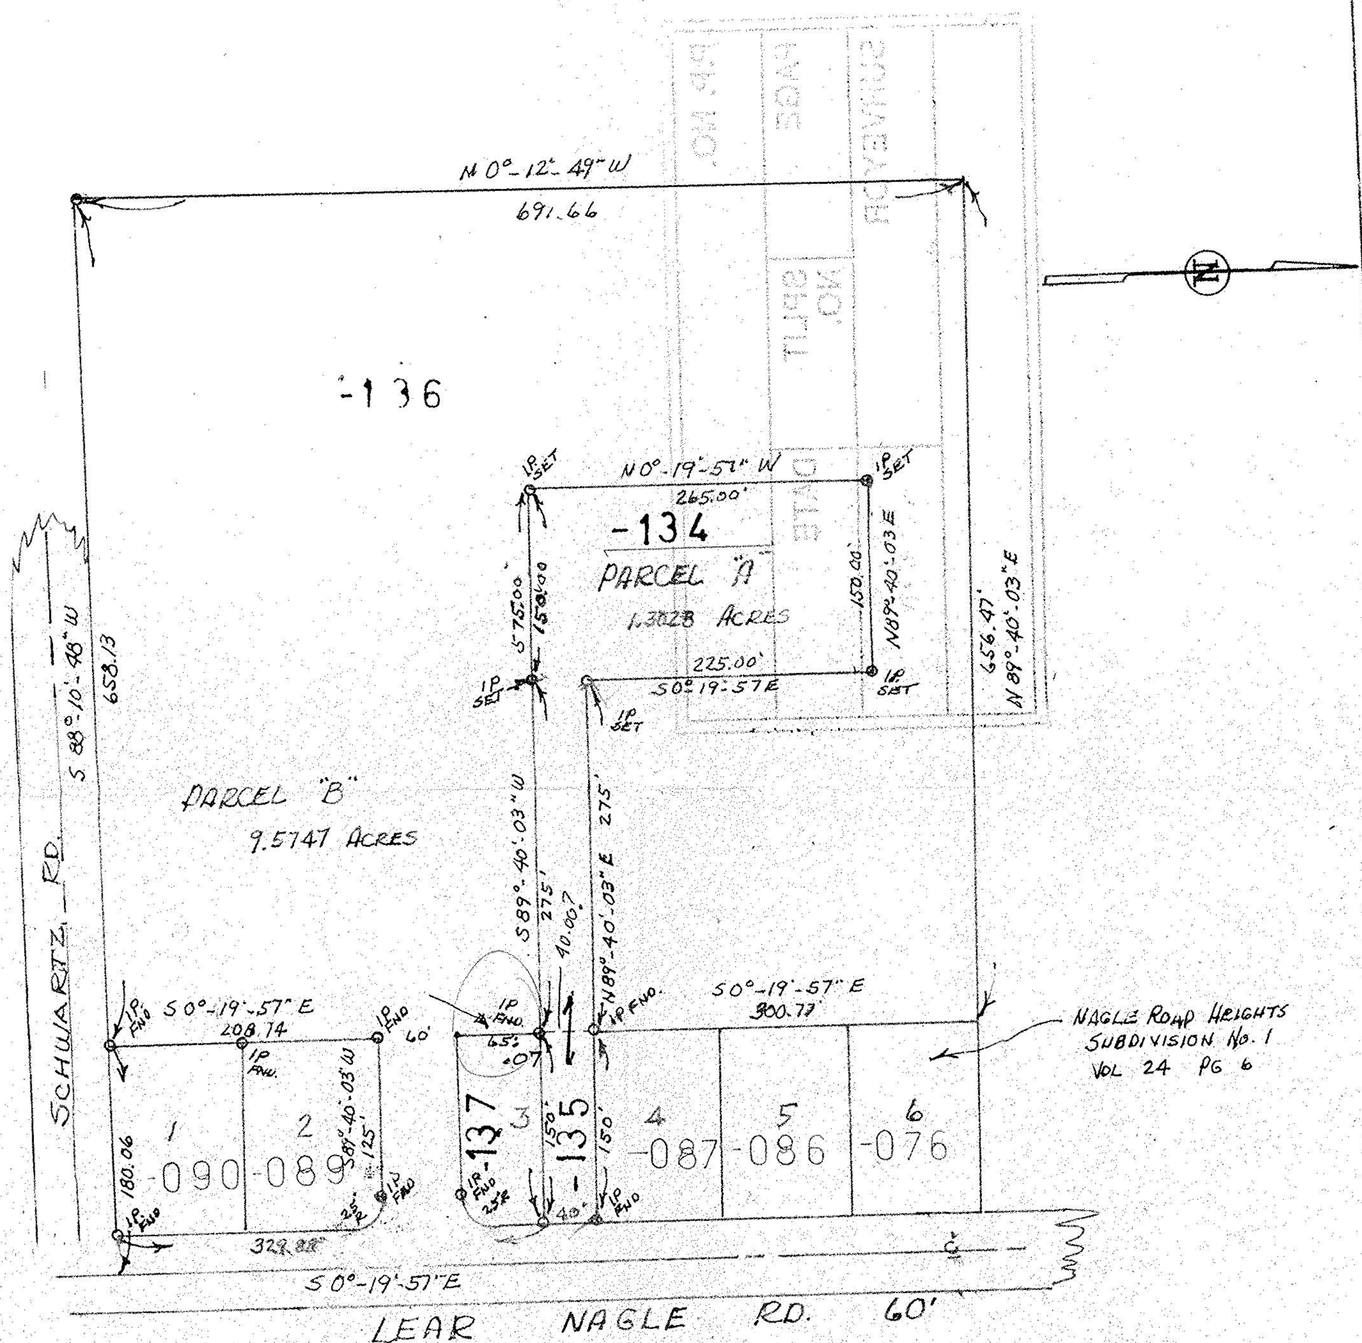

REFER TO BOUNDARY SURVEY
BY KS ASSOCIATES, INC. JULY 1991

SURVEY PARCEL "A"
ORIGINAL LOT 23 AVON TOWNSHIP
LORAIN COUNTY - AVON, OHIO
LEAR NAGLE ROAD
OWNERS: DAVID L. & BERNADETTE MAST
SCALE 1" = 100' JUNE 10, 1993

STATE OF OHIO
PAUL RICHARD SMULSKY
5886
REGISTERED
SURVEYOR

Paul R. Smulsky 6-14-93
#5886

20401

APPROVED
LORAIN CO.
MAP DEPT.
DATE 6-24-93
PAGE 4-00-023-D
BY CAROLYN FRANCIS
VOID AFTER # 20401

04-00-023-105-134
-135
-136
-137