PLAT OF SURVEY
FOR
JOZSEF E. AND SANWA A SZILAGYI

OR VOL 1140 Page 306

363176

SITUATED IN THE CITY OF AVON COUNTY OF LORAIN AND STATE OF OHIO AND BEING KNOWN AS PART OF ORIGINAL AVON TOWNSHIP NO. 10 AS RECORDED IN O.R. VOL 716 PG. 489 IN LORAIN COUNTY RECORD OF DEEDS

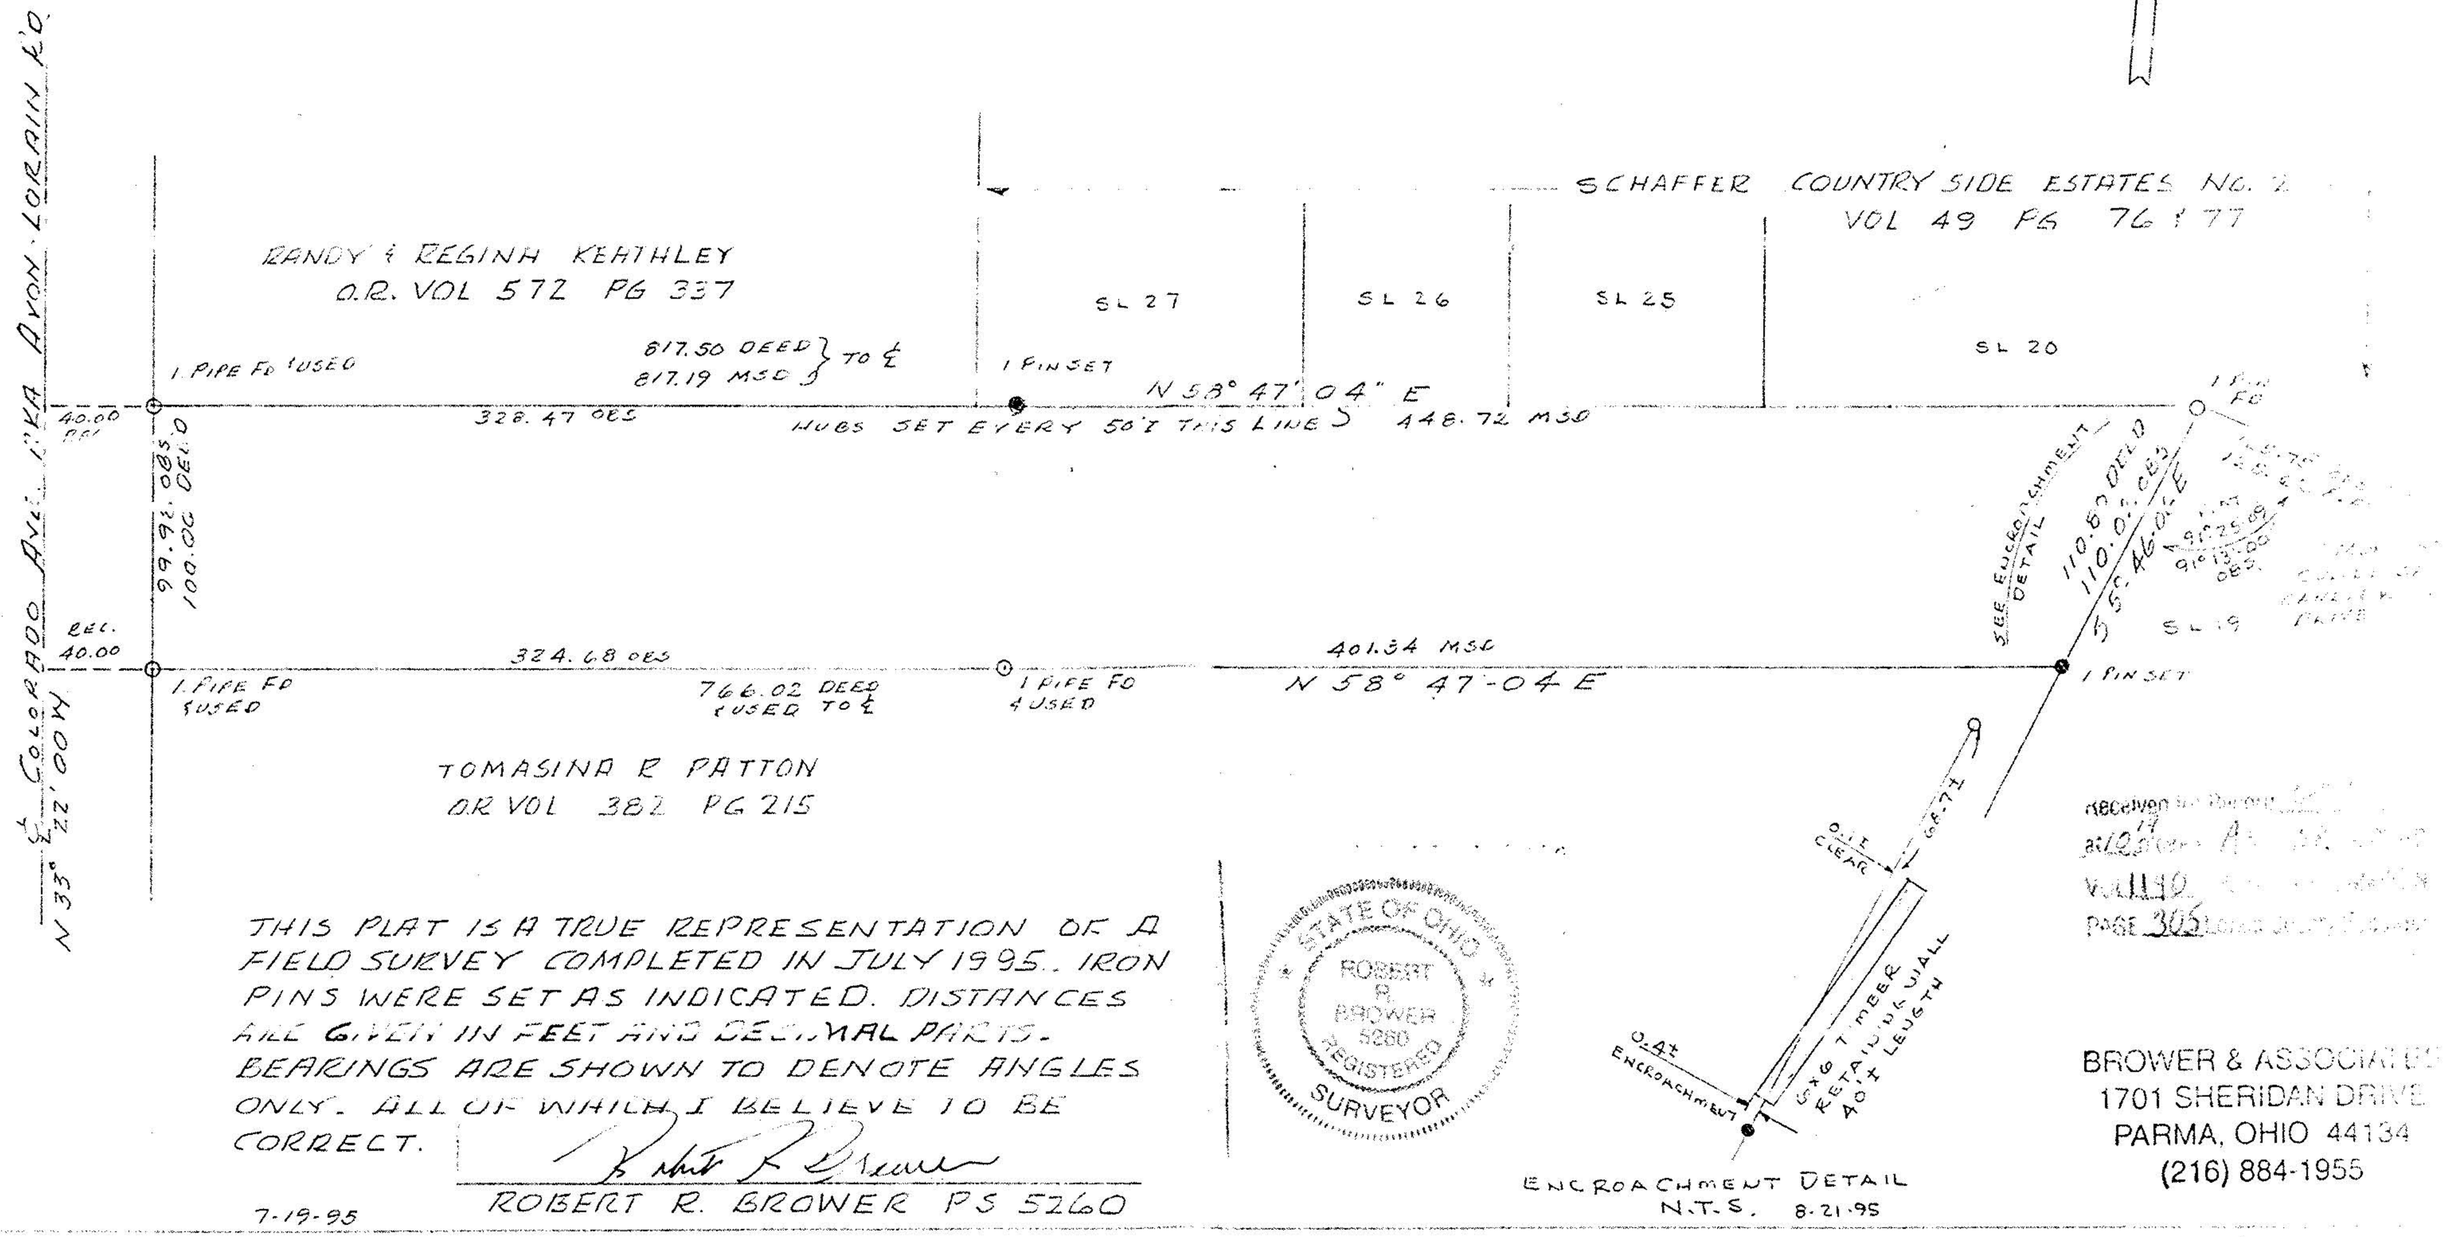

THIS PLAT IS A TRUE REPRESENTATION OF A FIELD SURVEY COMPLETED IN JULY 1995. IRON PINS WERE SET AS INDICATED. DISTANCES ARE GIVEN IN FEET AND DECIMAL PARTS. BEARINGS ARE SHOWN TO DENOTE ANGLES ONLY. ALL OF WHICH I BELIEVE TO BE CORRECT.

Robert R. Brower

ROBERT R. BROWER PS 5260

7-19-95

STATE OF OHIO
ROBERT R. BROWER
5260
REGISTERED
SURVEYOR

Received for Record
at 12:57 P.M. 8-22-95
Vol 1140
Page 305

BROWER & ASSOCIATES
1701 SHERIDAN DRIVE
PARMA, OHIO 44134
(216) 884-1955

O.R. VOL 1140 PAGE 000307