Stonebridge Creek Subdivision V.61, P.68 & 69 L.C.P.R.

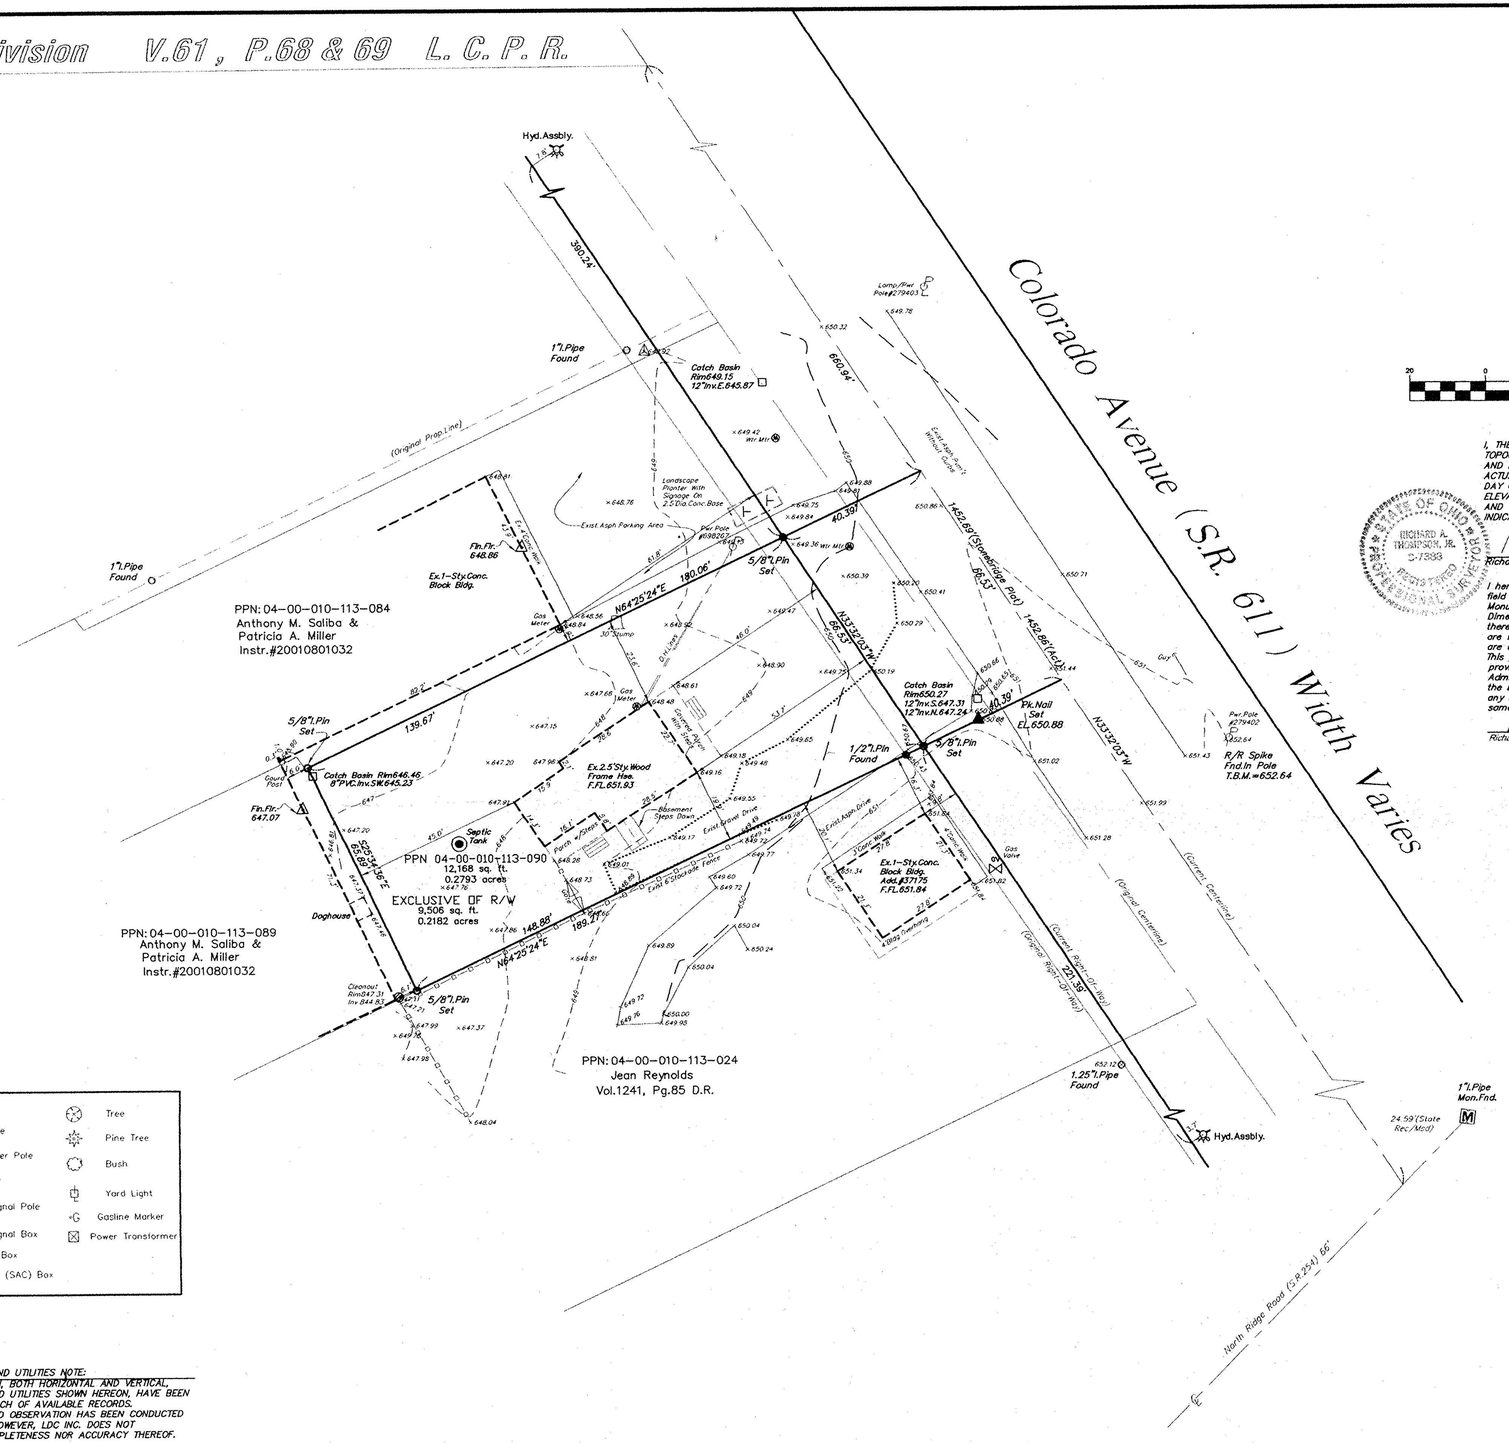

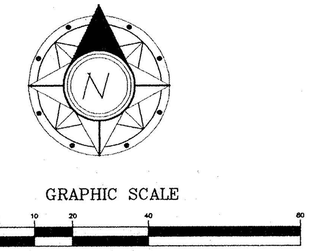

I, THE UNDERSIGNED, HEREBY CERTIFY THAT THIS TOPOGRAPHY, INDICATED BY 6", 1' OR 2' CONTOURS, AND ELEVATIONS SHOWN HEREON, REPRESENT AN ACTUAL FIELD SURVEY MADE BY ME ON THE 26th. DAY OF AUGUST 2002, AND THAT THE ELEVATIONS WERE TAKEN AT APPROPRIATE INTERVALS AND THAT AS OF THAT DATE THEY EXISTED AS INDICATED HEREON.

STATE OF OHIO RICHARD A. THOMPSON, JR. S-7388 REGISTERED PROFESSIONAL SURVEYOR

Feb 5, 2003

Richard A. Thompson, Jr. P.S.7388

I hereby certify that this plat was prepared from a field survey made under my direct supervision. Monuments were found or set as indicated. Dimensions are expressed in feet and decimal parts thereof. Bearings refer to an assumed meridian and are intended to indicate angles only. All of which are correct to the best of my knowledge and belief. This plat was prepared in accordance with the provisions of Chapter 4733-37 of the Ohio Administrative Code. This plat was prepared without the benefit of an abstract of title and is subject to any state of facts revealed by a examination of the same.

Richard A. Thompson, Jr., P.S. #7388

No 00792-A

APPROVED
BOARD OF
COUNTY
COMMISSIONERS
2-14-03
4-00-010-F
R. MAINES
03-00792-A

LEGEND

Clean Out	Water Valve	Guide Wire	Tree
Catch Basin	Water Meter	Power Pole	Pine Tree
Curb Inlet	Fire Hydrant	Light Power Pole	Bush
Yard Drain	Well	Light Pole	Yard Light
Manhole	Gas Valve	Traffic Signal Pole	Gasline Marker
Sanitary Manhole	Gas Meter	Traffic Signal Box	Power Transformer
Storm Manhole	Mailbox	Electrical Box	
Storm Inlet MH	Guard Post	Telephone (SAC) Box	
	Sign		

2 WORKING DAYS BEFORE YOU DIG
CALL TOLL FREE 800-362-2764
OHIO UTILITIES PROTECTION SERVICE

EXISTING UNDERGROUND UTILITIES NOTE:
THE SIZE & LOCATION, BOTH HORIZONTAL AND VERTICAL, OF THE UNDERGROUND UTILITIES SHOWN HEREON, HAVE BEEN OBTAINED BY A SEARCH OF AVAILABLE RECORDS. VERIFICATION BY FIELD OBSERVATION HAS BEEN CONDUCTED WHERE PRACTICAL. HOWEVER, LDC INC. DOES NOT GUARANTEE THE COMPLETENESS NOR ACCURACY THEREOF.

REV. No.		DATE	BY	CH'K'D

L.D.C. Inc. d.b.a.
LAND DESIGN consultants
www.LDCinc.net
ENGINEERS · PLANNERS SURVEYORS
8585 East Avenue Mentor, Ohio 44060 1471 Lear Industrial Park Avon, Ohio 44011
TEL: (440) 255-8463 (440) 951-LANDTEL: (440) 937-5601 (440) 937-5602
(440) 354-6938 FAX: (440) 255-9575 FAX: (440) 937-5603

DATE Feb.5th.,2003
SCALE: HOR. 1"=20'-0"
VERT.
FILENAME topographic.dwg
COMPUTER G.S.V.
FIELD CREW P.C.S.

Boundary, Location & Topographic Survey

Prepared For:
Dale Smitek

SHEET 1 OF 1

CONTRACT No. SMITD2-0201